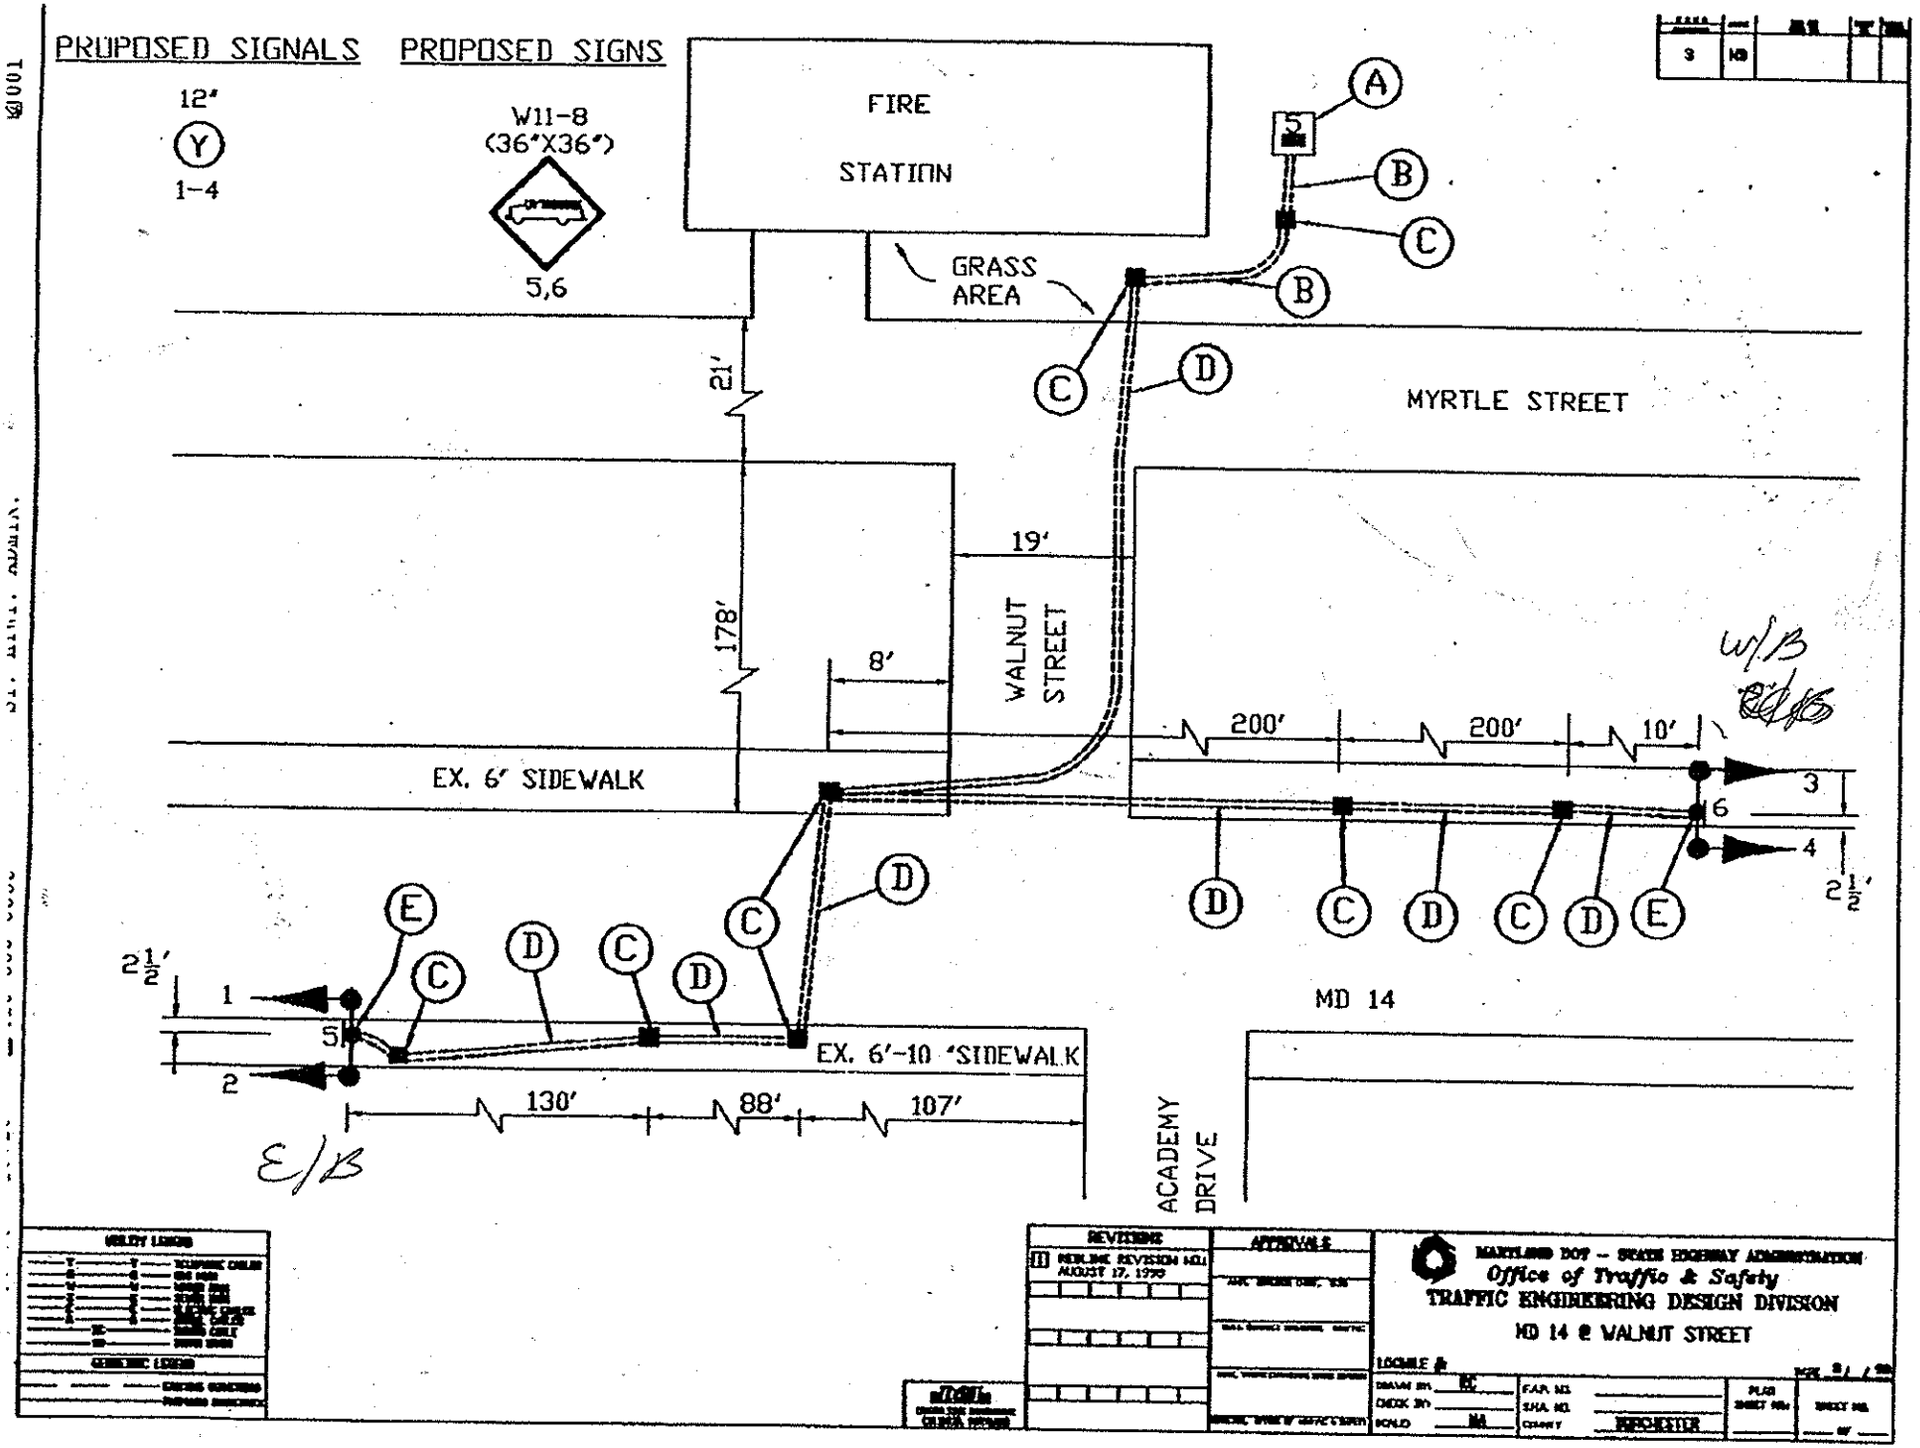
PROPOSED SIGNALS
PROPOSED SIGNS
12"
Y
1-4
W11-8
(36"X36")
5,6
FIRE
STATION
GRASS
AREA
MYRTLE STREET
21'
19'
178'
8'
WALNUT
STREET
200'
200'
10'
EX. 6' SIDEWALK
3
6
4
2 1/2'
W/B
E/B
MD 14
EX. 6'-10 'SIDEWALK
130'
88'
107'
ACADEMY
DRIVE
1
2
5
A
B
C
D
E
REVISIONS
APPROVALS
MARYLAND DOT – STATE HIGHWAY ADMINISTRATION
Office of Traffic & Safety
TRAFFIC ENGINEERING DESIGN DIVISION
MD 14 @ WALNUT STREET
LOCALE
DRAWN BY
CHECK BY
SCALE
F.A.P. NO.
S.H.A. NO.
COUNTY
PLAN SHEET NO.
SHEET NO.