F.H.W.A. REGION NO.	STATE	FED. AID PROJ. NO.	SHEET NO.	TOTAL SHEETS
3	MD.			

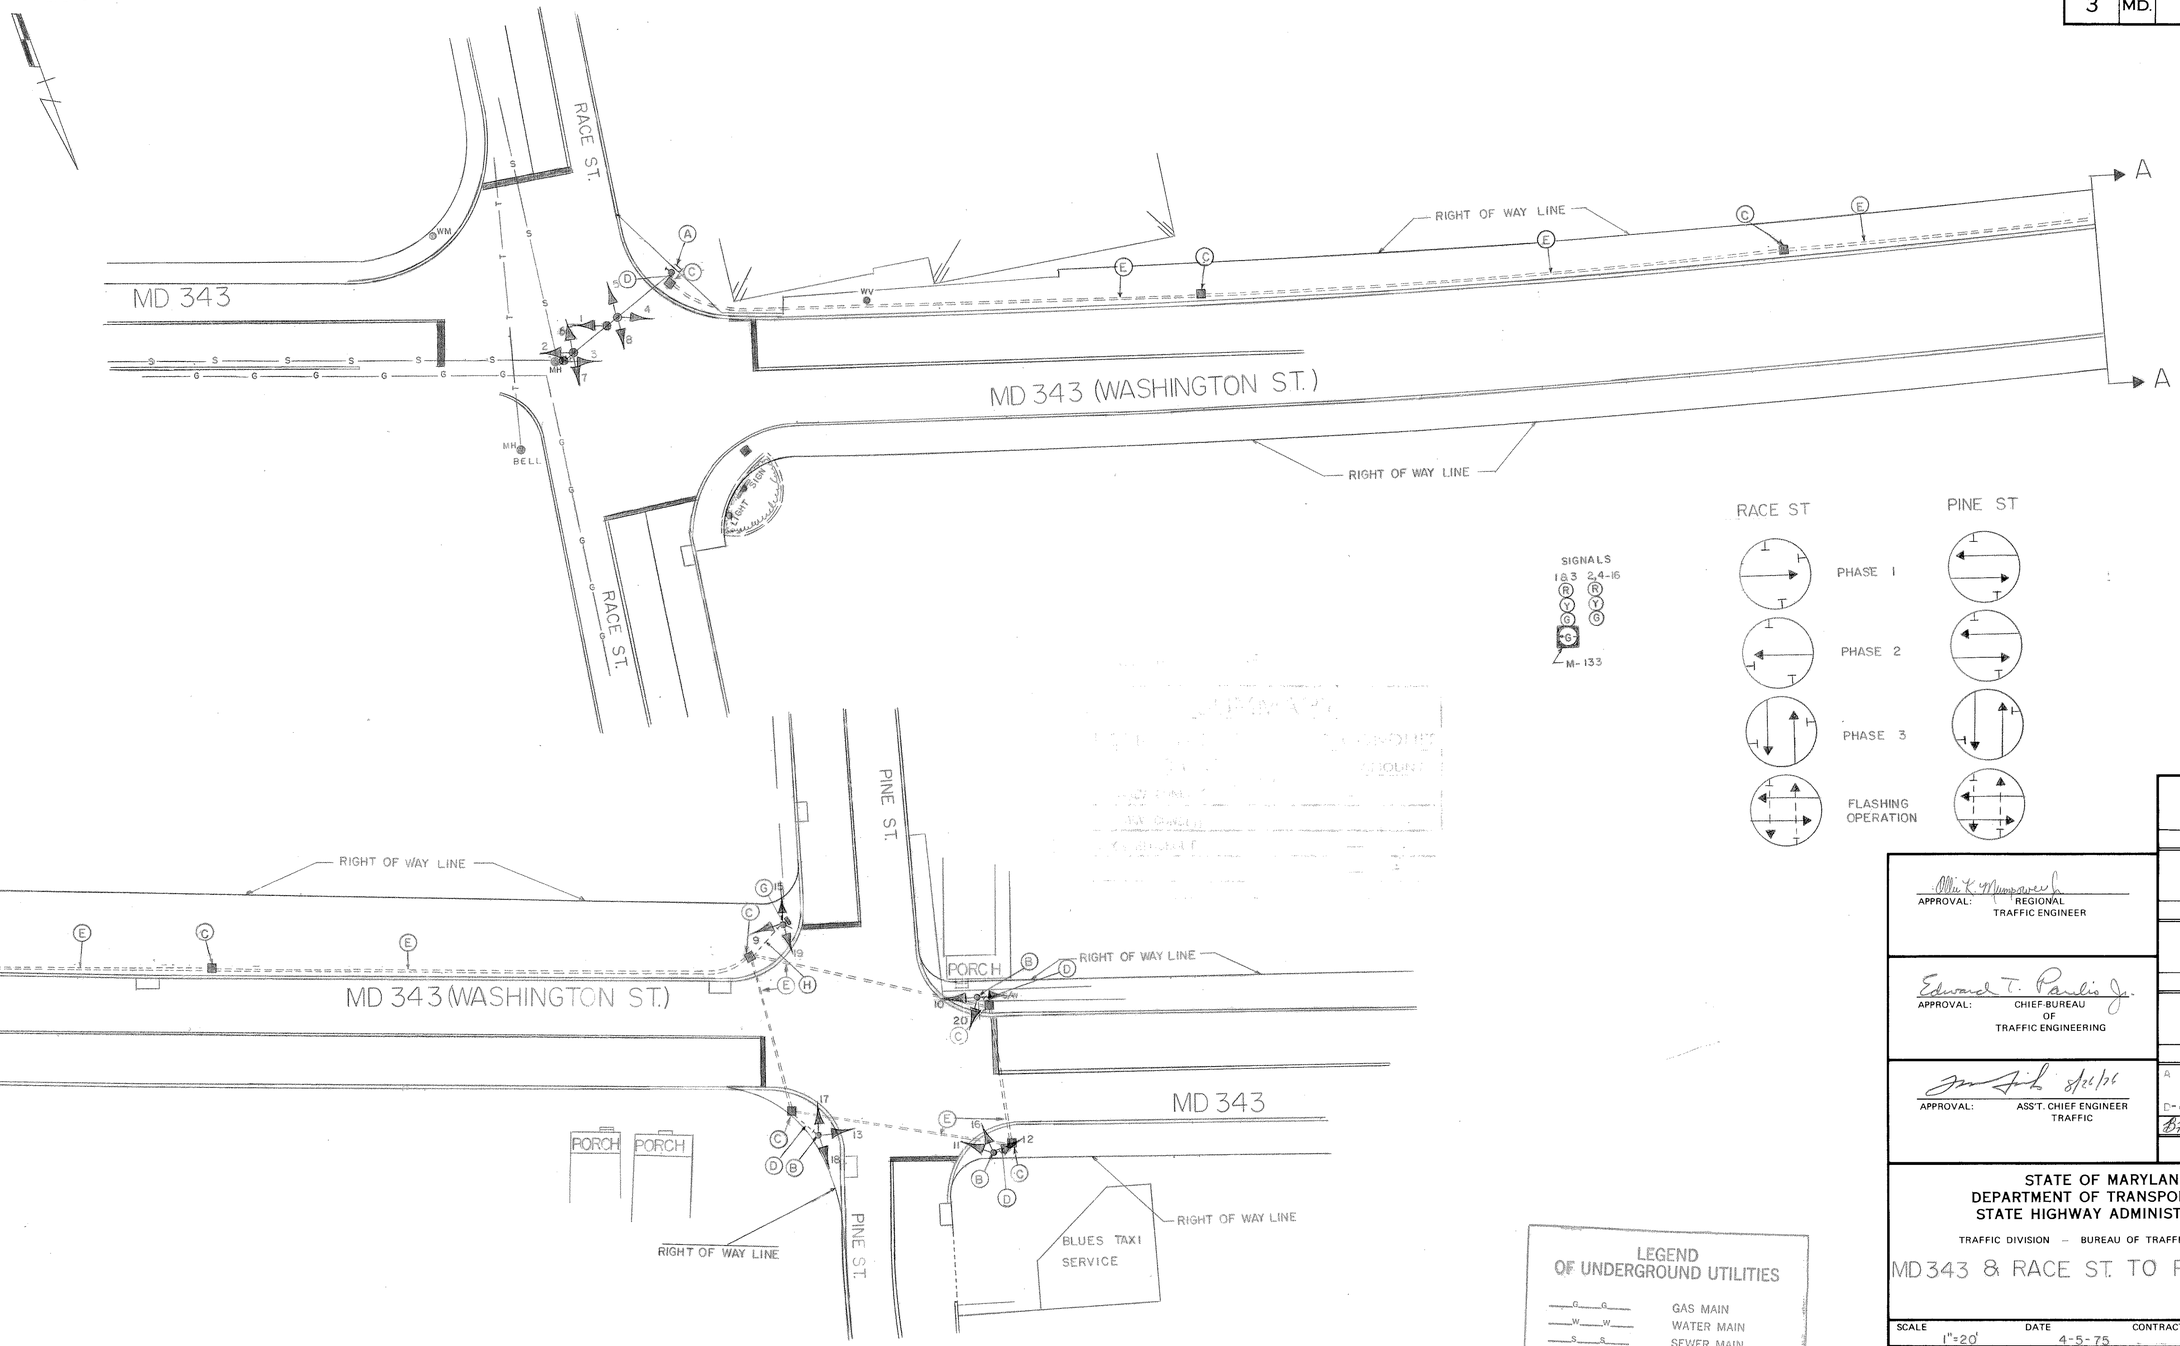

LEGEND OF UNDERGROUND UTILITIES

G G	GAS MAIN
W W	WATER MAIN
S S	SEWER MAIN
E E	ELECTRIC CABLES
T T	TELEPHONE CABLES
A A	AERIAL CABLES

APPROVAL: REGIONAL TRAFFIC ENGINEER

APPROVAL: CHIEF-BUREAU OF TRAFFIC ENGINEERING

8/26/76

APPROVAL: ASS'T. CHIEF ENGINEER TRAFFIC

A ASBUILT 7-13-82

D-425-451-185

REVISIONS

STATE OF MARYLAND
DEPARTMENT OF TRANSPORTATION
STATE HIGHWAY ADMINISTRATION

TRAFFIC DIVISION – BUREAU OF TRAFFIC ENGINEERING

MD 343 & RACE ST. TO PINE ST.

SCALE	DATE	CONTRACT NO.
1"=20'	4-5-75	

DRAWN BY: B. THOMPSON COUNTY: DORCHESTER

DESIGNED BY: Bruce Thompson SIGNAL NO.: 09009 & 09007

CHECKED BY: A. Budniechuk 8-30-76.

DRAWING NO. TS-1300A

BRUNING 44-511 19927