F.H.W.A. REGION NO.	STATE	FED. AID PROJ. NO.	SHEET NO.	TOTAL SHEETS
3	MD.			

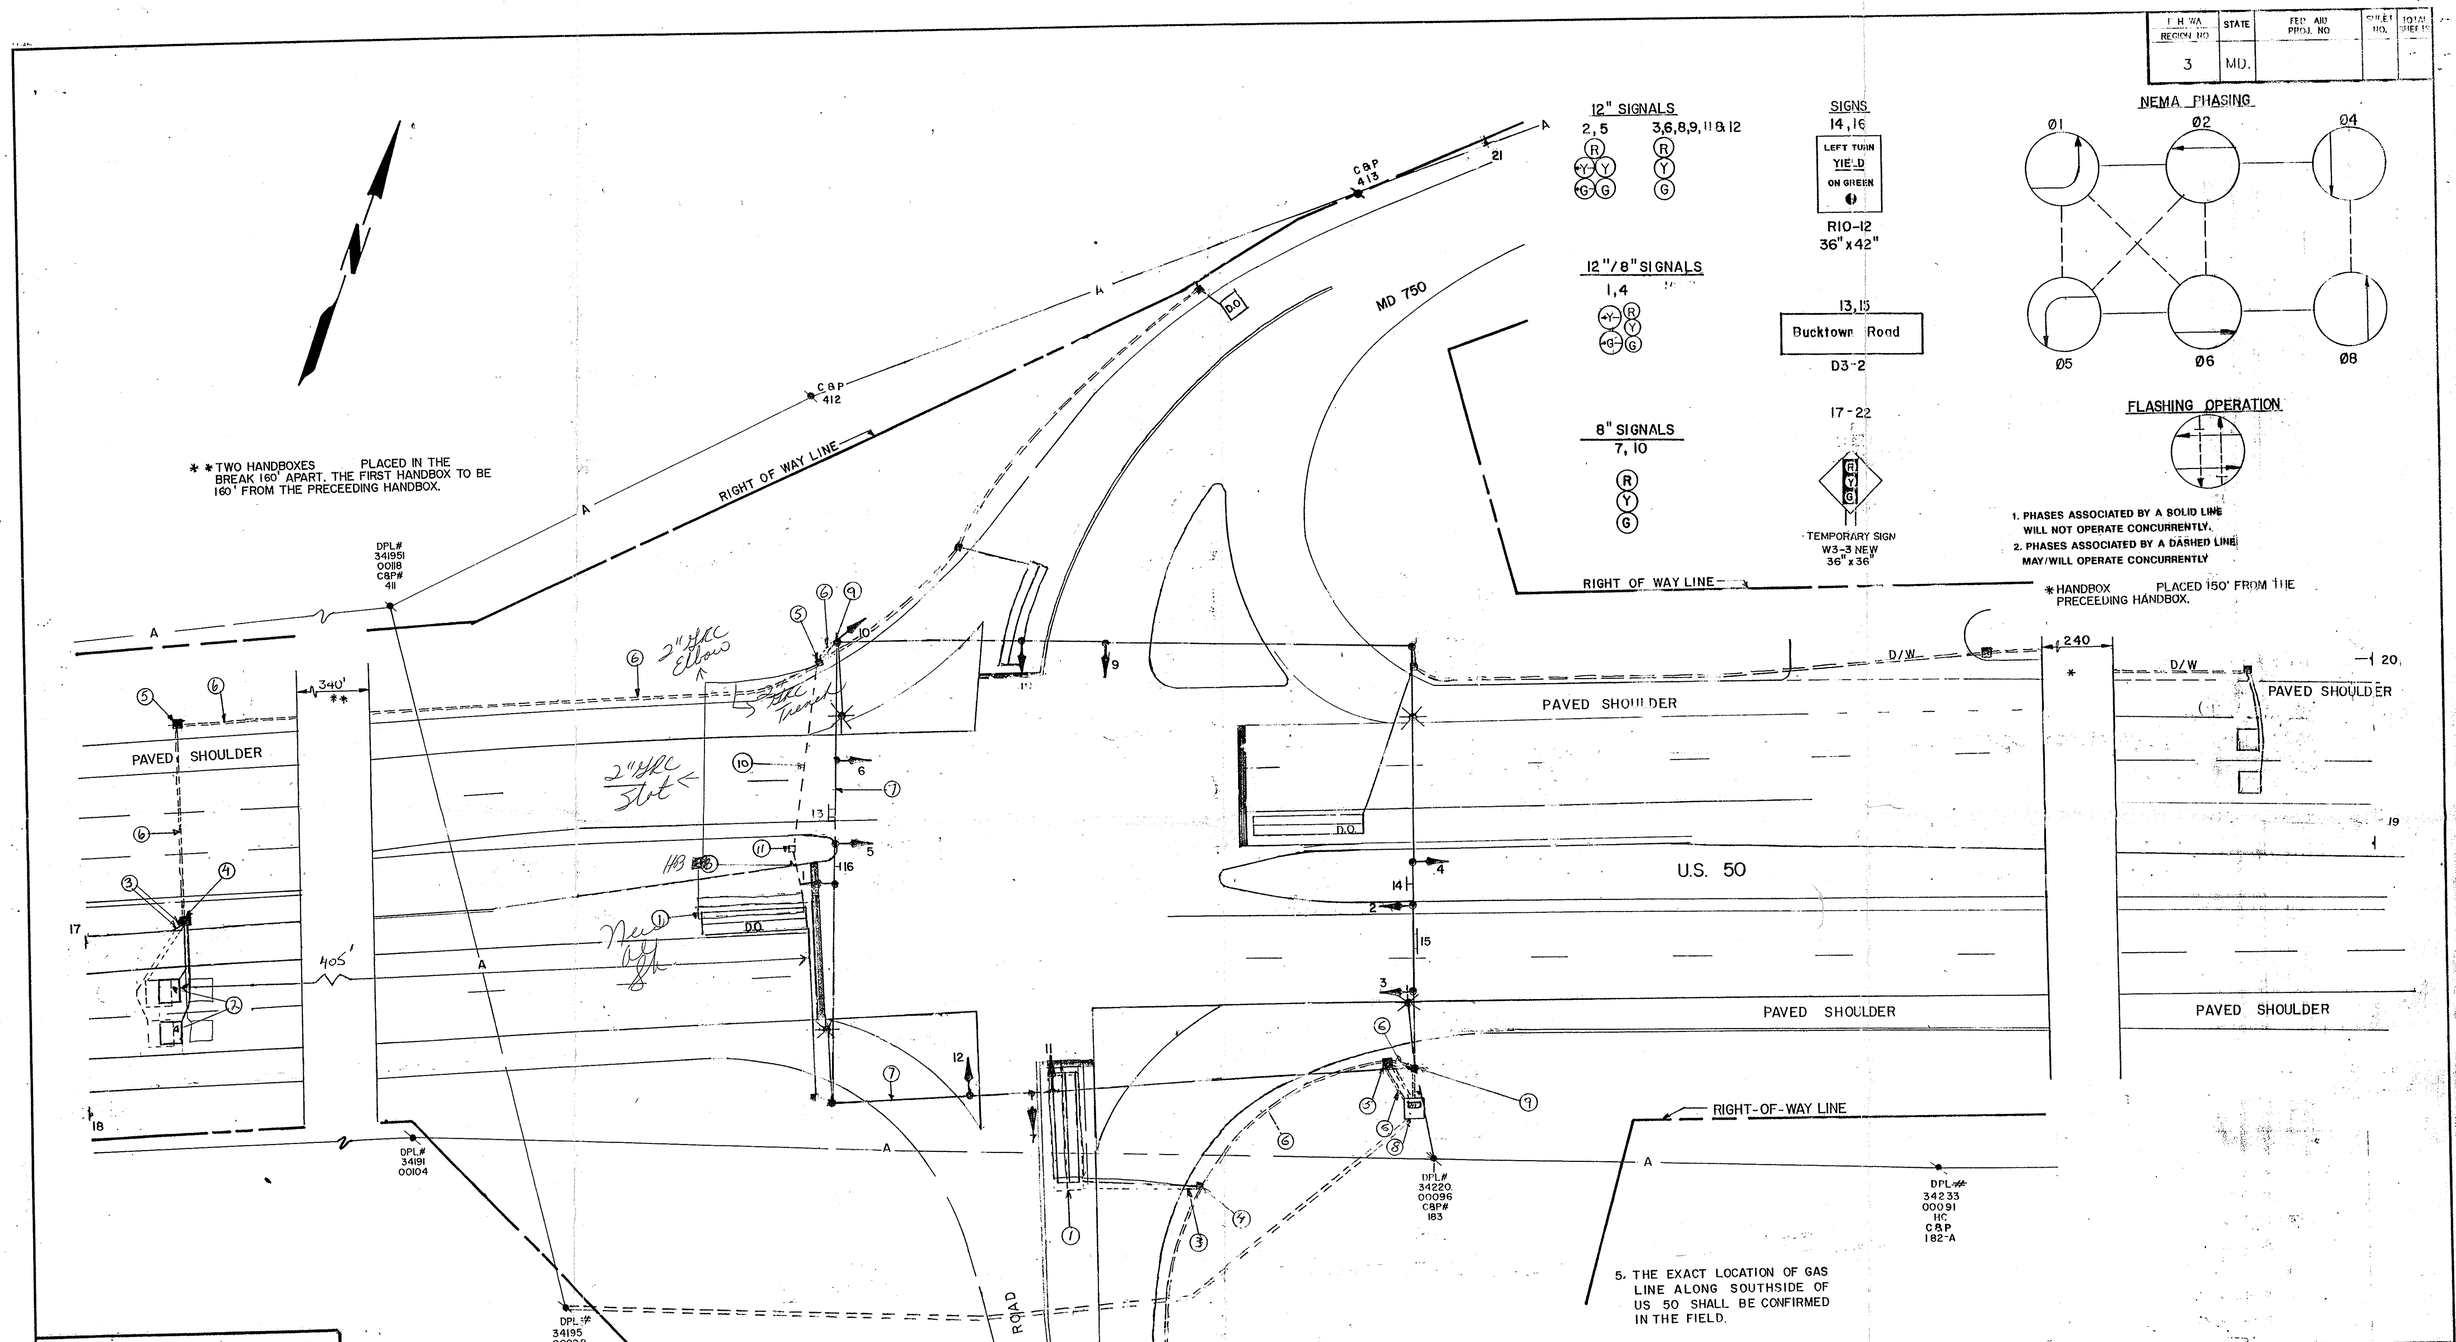

LEGEND OF UNDERGROUND AND OVERHEAD UTILITIES

AERIAL CABLE — A — A — A — A —

ELECTRIC — E — E — E — E — E —

TELEPHONE — T — T — T — T —

JOHNSON, MIRMIRAN & THOMPSON, P.A.
810 GLENEAGLES CT.
BALTIMORE, MARYLAND

REVISIONS	APPROVALS
10-93 REPAIR FINISHED LOOP DETECTORS SHEET NO. SHG-0005(FB)E.	CHIEF, SIGNAL DESIGN SECTION 10/18/88
	ASST. DISTRICT ENGINEER, TRAFFIC 10/18/88
	CHIEF, BUREAU OF TRAFFIC ENGINEERING 10-18-88
	DEPUTY CHIEF ENGINEER, OFFICE OF TRAFFIC 10-18-88

MARYLAND DEPARTMENT OF TRANSPORTATION
STATE HIGHWAY ADMINISTRATION – OFFICE OF TRAFFIC
BUREAU OF TRAFFIC ENGINEERING

DRAWN BY: EDK
DES. BY: DS
CHK. BY: 10/18/88
DATE: 8-18-88
SCALE: 1"=20'

US 50 AND BUCKTOWN ROAD

COUNTY: DORCHESTER
F.A.P. NO.
S.H.A. NO. D-537-459-185
TS/FILE NO. 2497
SHEET NO. 1 OF 2

09005002.92