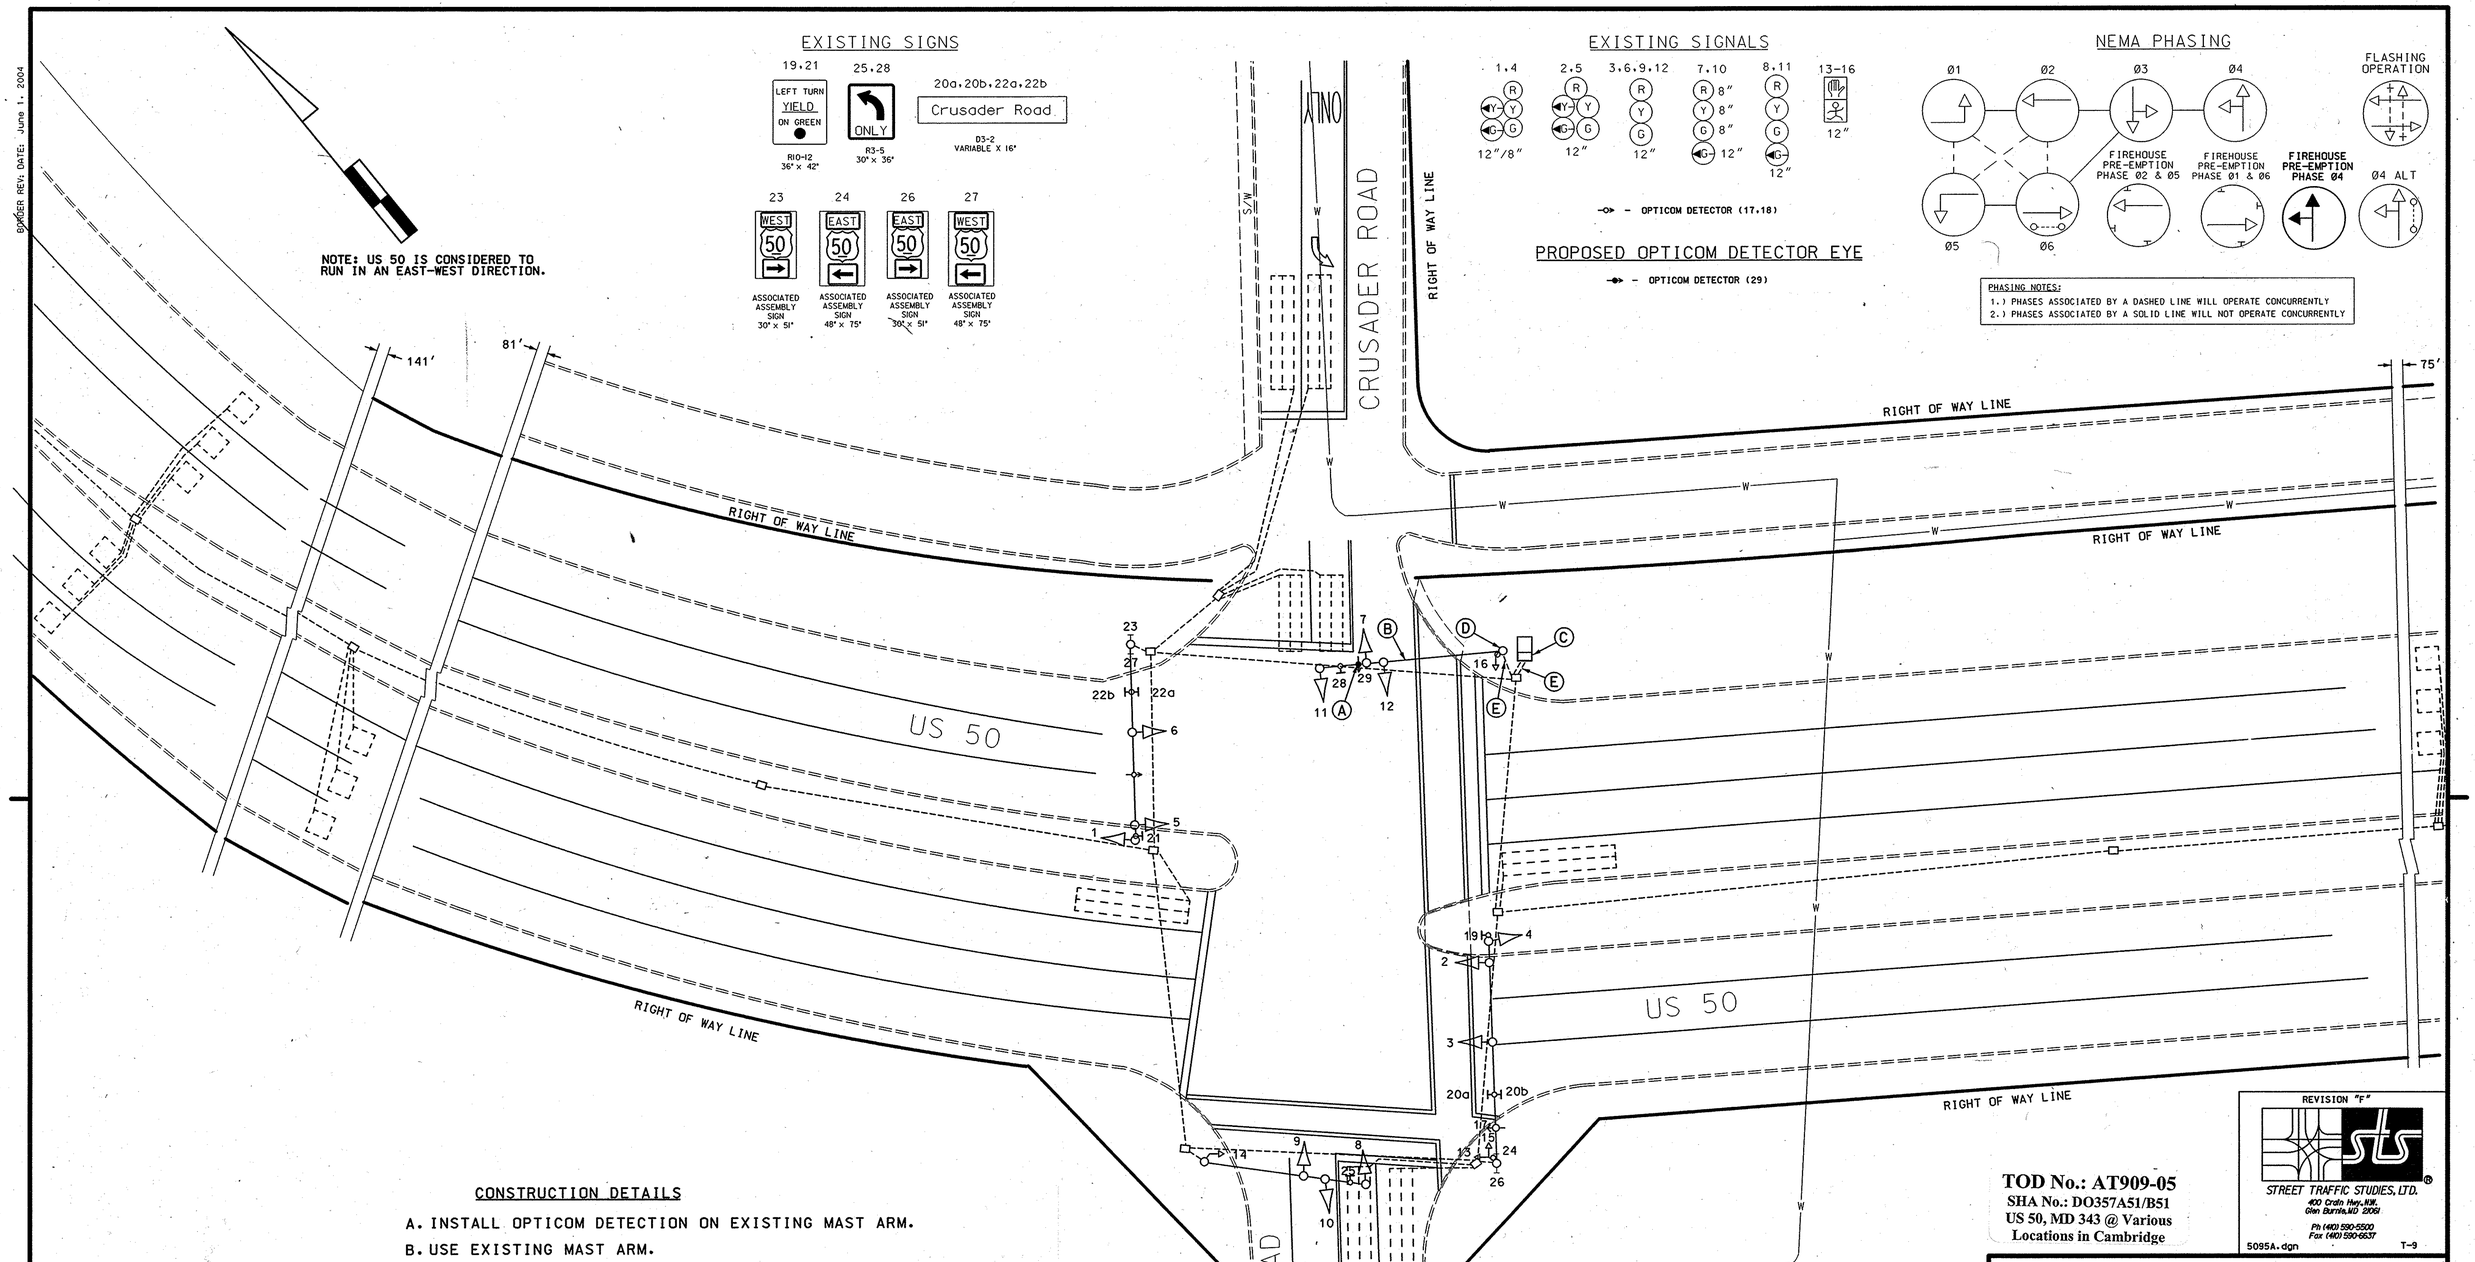

CONSTRUCTION DETAILS

A. INSTALL OPTICOM DETECTION ON EXISTING MAST ARM.
B. USE EXISTING MAST ARM.
C. USE EXISTING CABINET AND CONTROLLER.
D. USE EXISTING MAST ARM POLE.
E. USE EXISTING CONDUIT.

GENERAL NOTES:

1. This plan reflects only those underground utilities that were apparent at the time of this location being asbuilt. A detailed review was not undertaken and the plan should not be construed as representing all underground utilities in the area.

TOD No.: AT909-05
SHA No.: DO357A51/B51
US 50, MD 343 @ Various Locations in Cambridge

REVISION "F"
STREET TRAFFIC STUDIES, LTD.
400 Crain Hwy. N.W.
Glen Burnie, MD 21061
Ph (410) 590-5500
Fax (410) 590-6637
5095A.dgn T-9

STATE OF MARYLAND
DEPARTMENT OF TRANSPORTATION
STATE HIGHWAY ADMINISTRATION

US 50 AND CRUSADER ROAD

CAMBRIDGE, MD

TRAFFIC SIGNAL PLAN

SCALE 1"= 20' DATE _____ CONTRACT NO. D515501170

DESIGNED BY _____ COUNTY DORCHESTER
DRAWN BY _____ LOGMILE 09005001.59
CHECKED BY _____ TIMS NO. H663
F.A.P. NO. _____ TOD NO. _____

TS NO. 340F | DRAWING NO. 1 OF 9 | SHEET NO. OF

APPROVALS	REVISIONS
TEAM LEADER	INSTALL OPTICOM DETECTOR EYE. SHA #: AT9095185 TIMS: H663 9-14-06
ASST. DIV. CHIEF	E. 10/2002 - REPLACED SIGNAL HEADS W/ BLACK FACES, ASSOC. WIRING, & ADDED ASSOCIATED SHIELD ASSEMBLY SIGNS SHA NO. XX1065185
DIVISION CHIEF	W.M. / M.A.R. / D.A.Z. / B.R.K.
OFFICE DIRECTOR	D. 05/1998 - ADDED FIREHOUSE PRE-EMPTION TO E/B & W/B US 50 SHA NO. AW-2765185
	W.M. / D.J.D. / D.A.Z. / B.R.K.

ORIGINAL ON FILE

PLOTTED: $DATETIME$
FILE: $FILE$

GEOMETRIC LEGEND
PROPOSED
EXISTING

LEGEND OF UNDERGROUND AND OVERHEAD UTILITIES
AERIAL CABLE — A — A —
ELECTRIC — E — E —
TELEPHONE — T — T —
GAS — G — G —
SEWER — S — S —
WATER — W — W —
CABLE TV — TV — TV —

DRILL HOLES
DRILL HOLES
DRILL HOLES

BORDER REV: DATE: June 1, 2004