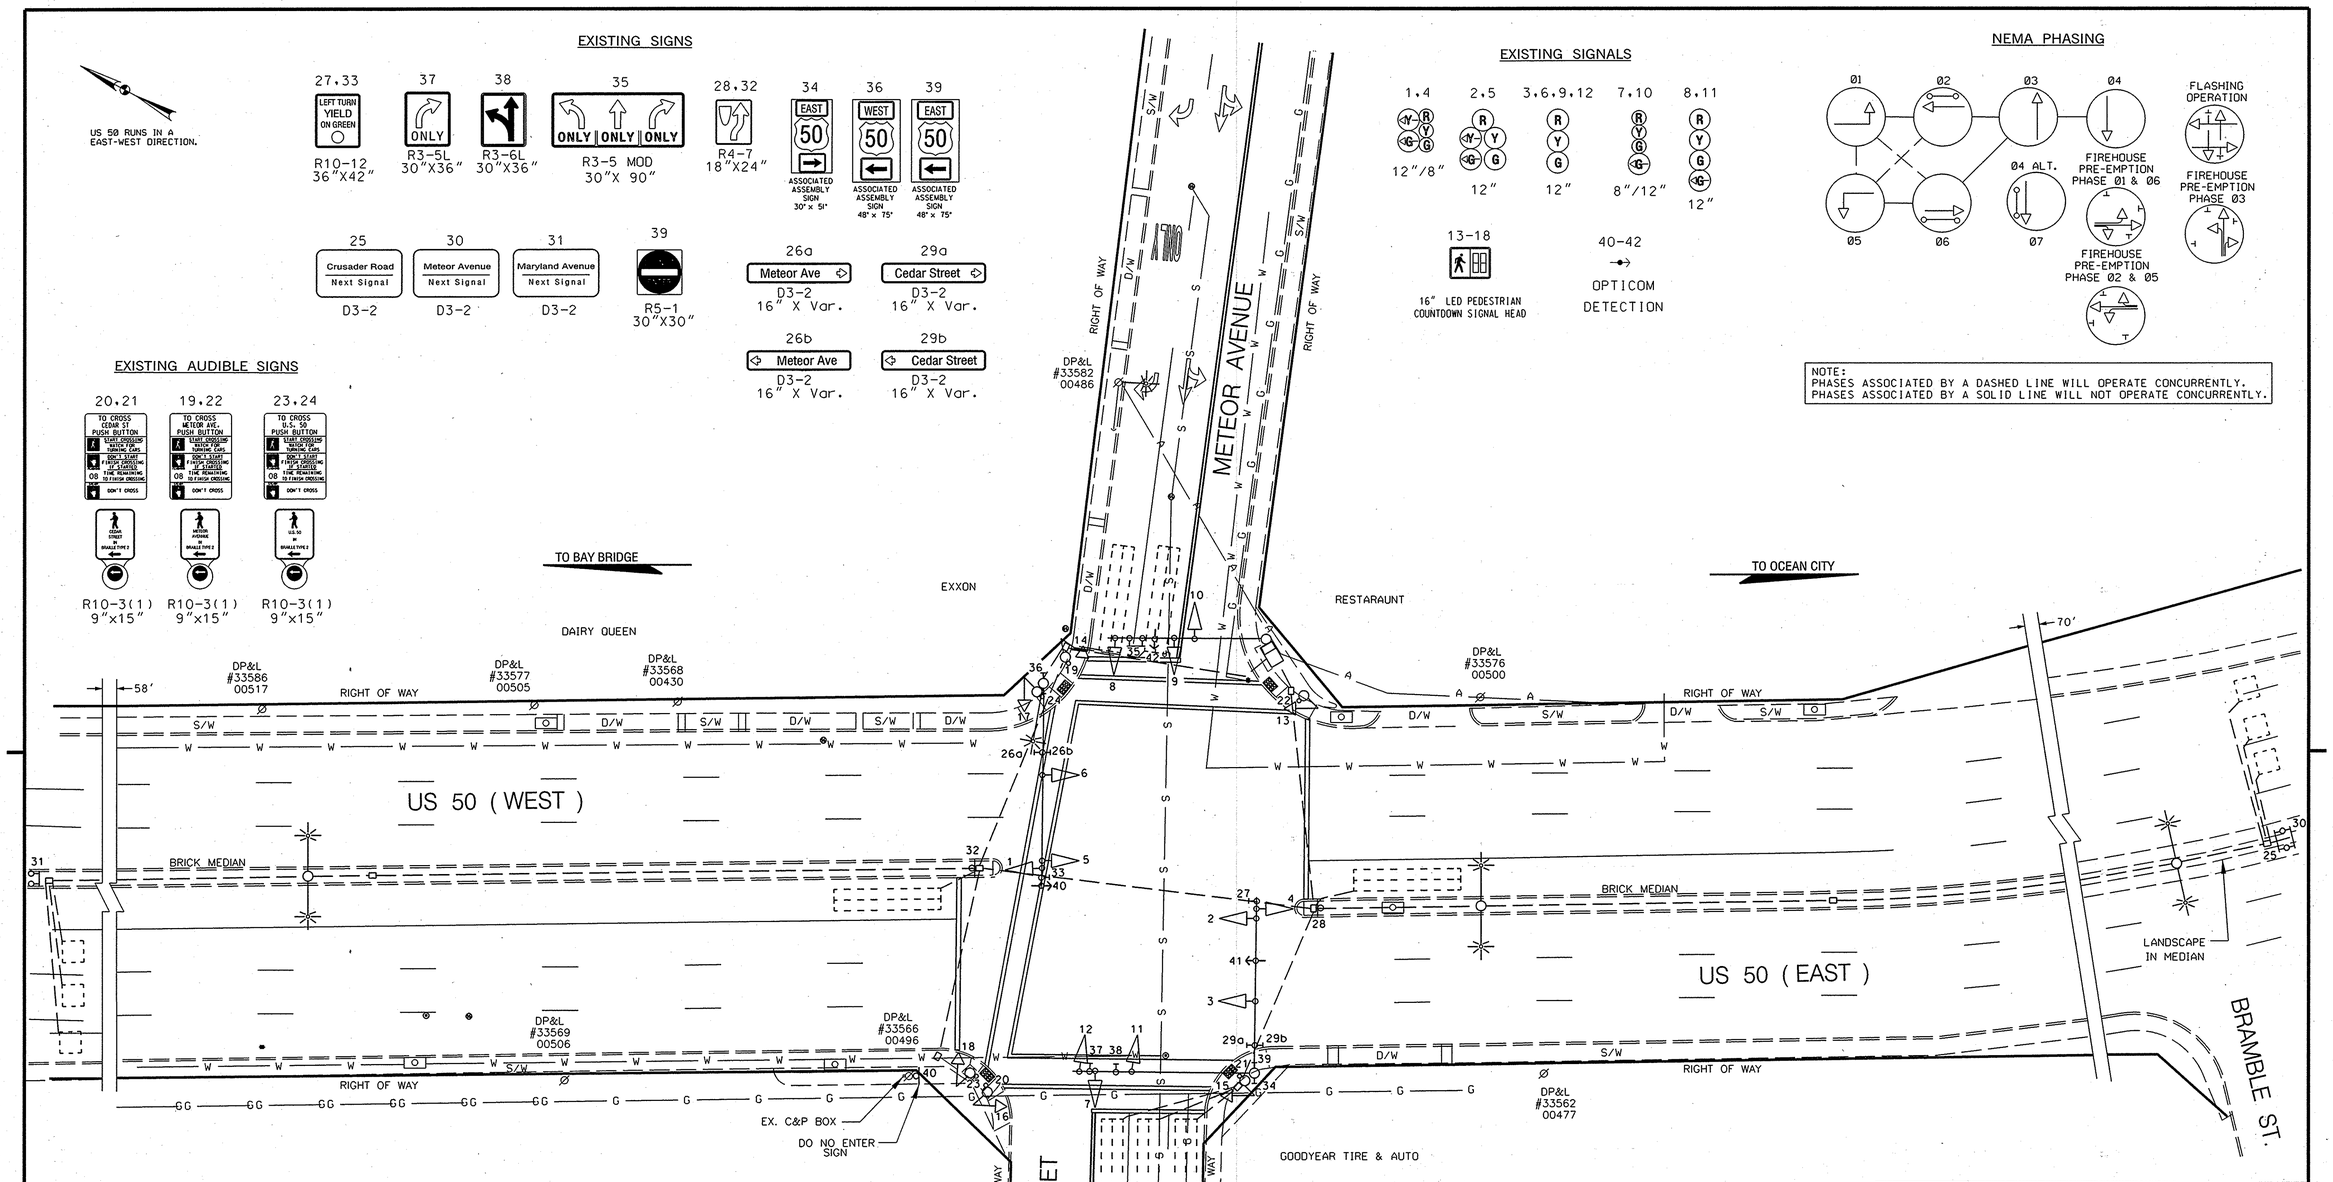

GEOMETRIC LEGEND

EXISTING
PROPOSED

UTILITY LEGEND

SD	STORM DRAIN
G	GAS MAIN
W	WATER MAIN
S	SEWER MAIN
E	ELECTRIC CABLES
A	AERIAL CABLES
T	TELEPHONE CABLES
F	FIBER-OPTIC

BY: ROBERT

BAI

BRUDIS & ASSOCIATES, INC.
CONSULTING ENGINEERS
9220 RUMSEY ROAD SUITE 110
COLUMBIA, MARYLAND 21045
410-884-3607 410-884-3609(FAX)

SHA

STATE OF MARYLAND
DEPARTMENT OF TRANSPORTATION
STATE HIGHWAY ADMINISTRATION
OFFICE OF TRAFFIC & SAFETY
TRAFFIC ENGINEERING DESIGN DIVISION

US 50 AT CEDAR STREET /METEOR AVENUE

AS-BUILT PLAN

SCALE 1"= 20' DATE 05/09/07 CONTRACT NO.

DESIGNED BY
DRAWN BY B. THOMPSON
CHECKED BY
F.A.P. NO.
COUNTY DORCHESTER
LOGMILE 09005001.37
T.I.M.S. NO. ~~1469.1470~~.1471.~~1472~~
TOD NO.

DRAWING NO. TS 336 J 1 OF 1 SHEET NO. OF

APPROVALS

TEAM LEADER
ASST. DIV. CHIEF
DIVISION CHIEF
OFFICE DIRECTOR

ORIGINAL ON FILE

REVISIONS

(J) AS-BUILT INSTALL APS & CPS 07-23-2007 M.H.

(I) REPLACED SIGNAL HEADS W/ BLACK FACES & ASSOC. WIRING. ADDED ASSOCIATED ASSEMBLY SIGNS. SHA NO. XX1065185 10/2002 W.M. D.J.D. D.A.J. B.R.K.

(H) ADDED FIREHOUSE PRE-EMPTION TO E/B US 50 & W/B US 50 SHA NO. AW-2765185 05/1998 W.M. D.J.D. D.A.J. B.R.K.

PLOTTED: WEDNESDAY, AUGUST 29, 2007 AT 07:41 AM
FILE: P:\04-005 SIGNALS\US 50 APS\DRAWINGS\US 50 APS ASBUILTS\US 50 & CEDAR\MSG-P002.US50@CEDAR.DGN