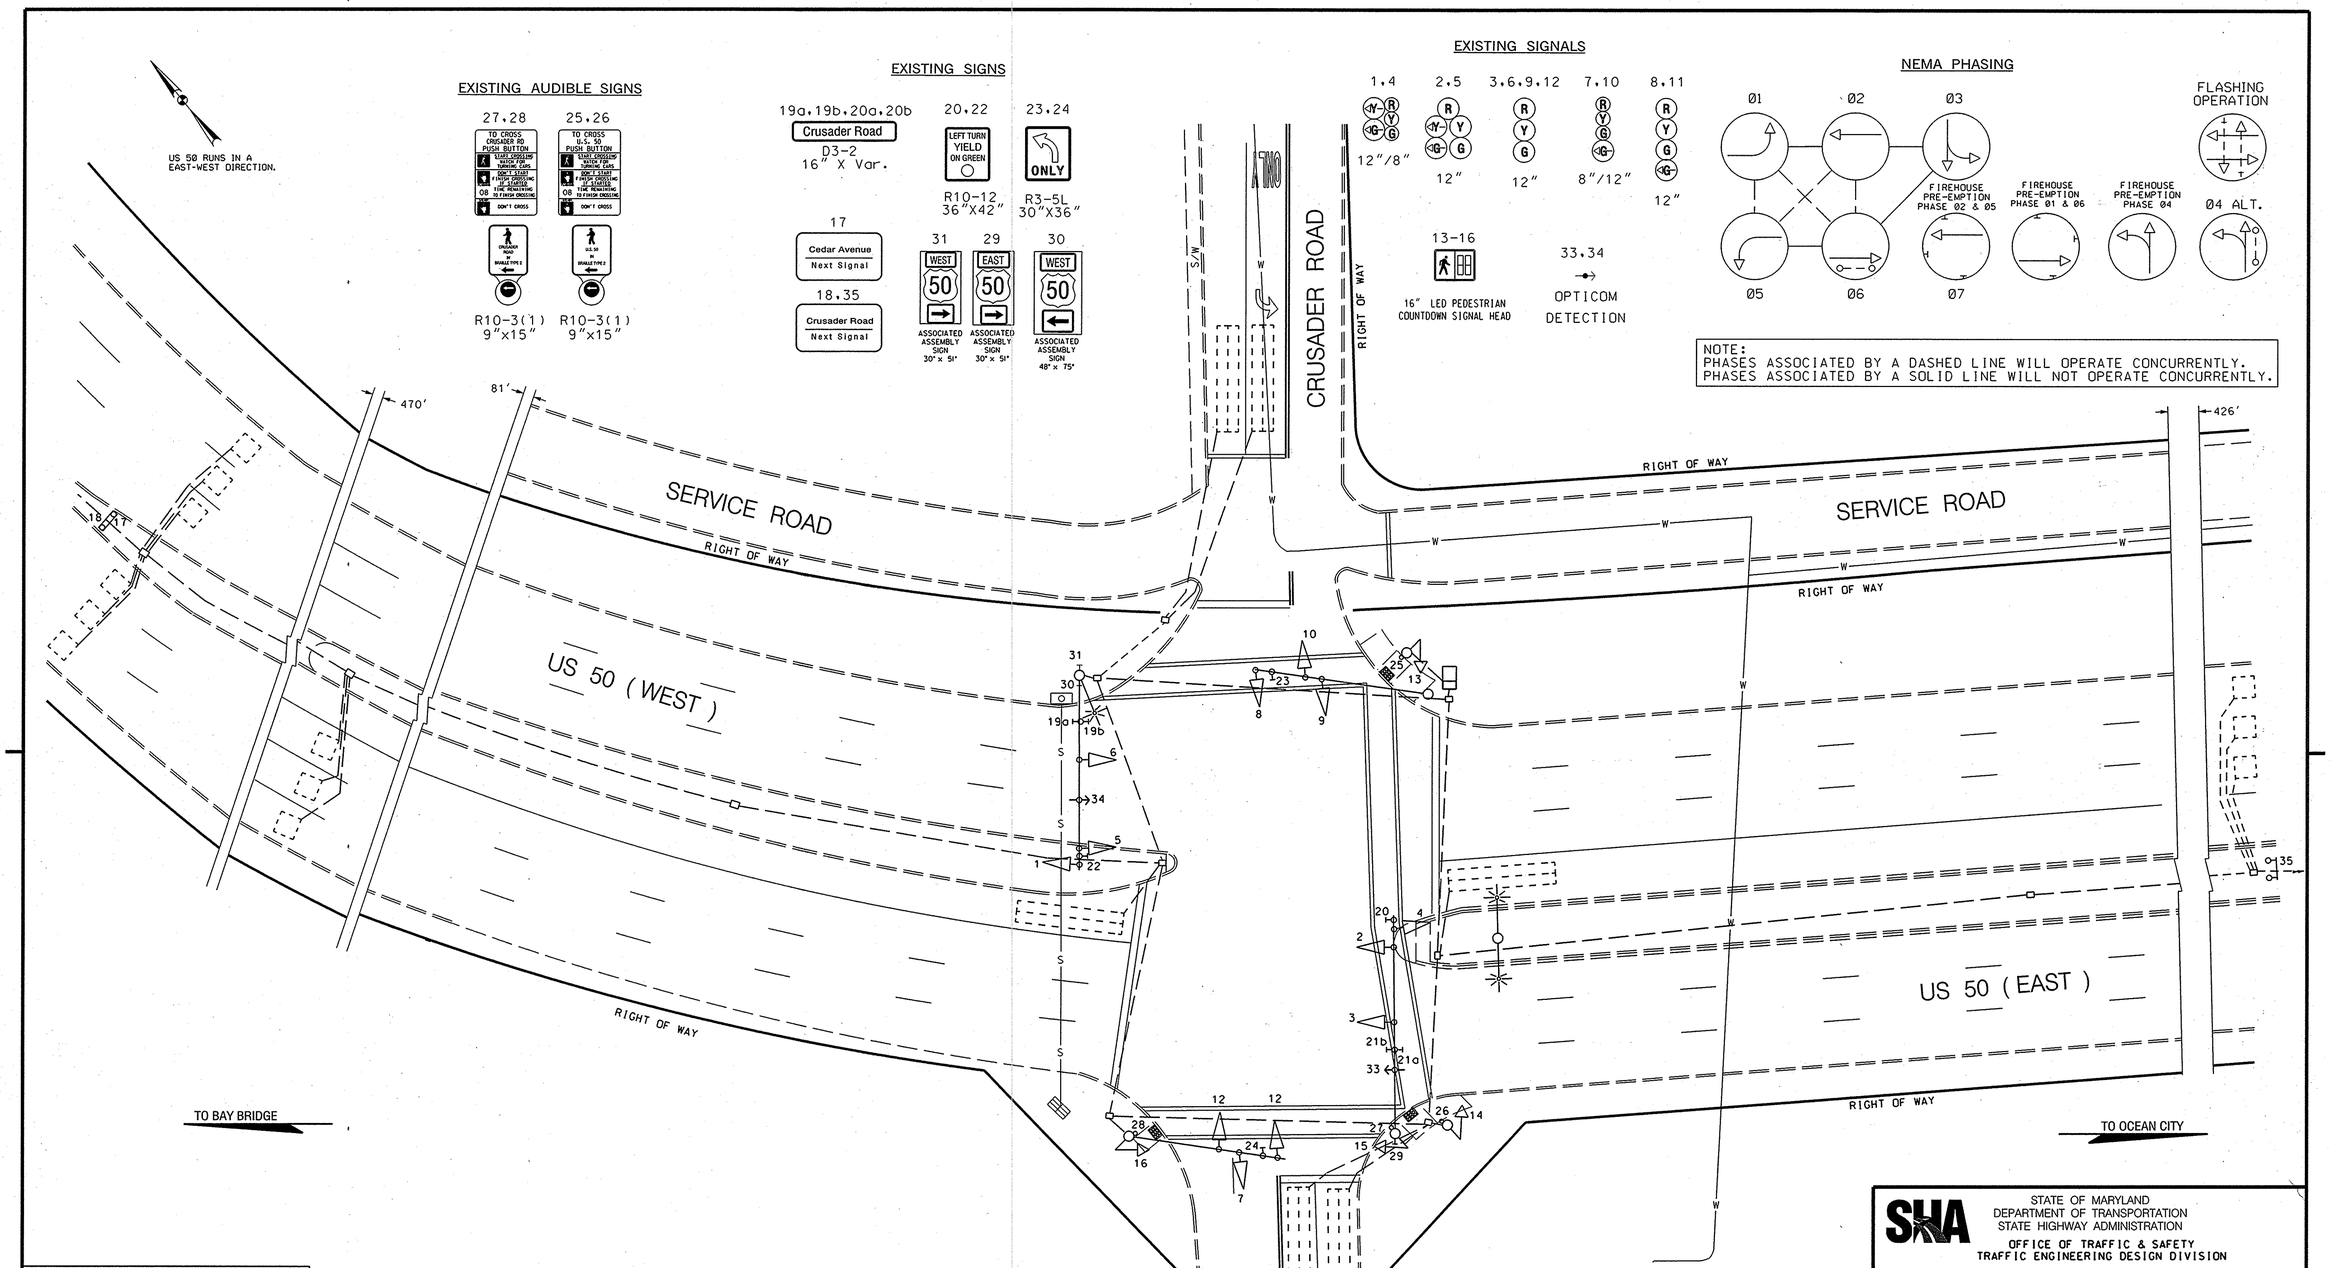

GEOMETRIC LEGEND

EXISTING
PROPOSED

UTILITY LEGEND

SD	STORM DRAIN
G	GAS MAIN
W	WATER MAIN
S	SEWER MAIN
E	ELECTRIC CABLES
A	AERIAL CABLES
T	TELEPHONE CABLES
F	FIBER-OPTIC

BY: ROBERT

BAI

BRUDIS & ASSOCIATES, INC.
CONSULTING ENGINEERS
9220 RUMSEY ROAD SUITE 110
COLUMBIA, MARYLAND 21045
410-884-3607 410-884-3609(FAX)

STATE OF MARYLAND
DEPARTMENT OF TRANSPORTATION
STATE HIGHWAY ADMINISTRATION
OFFICE OF TRAFFIC & SAFETY
TRAFFIC ENGINEERING DESIGN DIVISION

US 50 & CRUSADER ROAD

AS-BUILT PLAN

SCALE 1"= 20' DATE _____ CONTRACT NO. _____

DESIGNED BY _____ COUNTY DORCHESTER
DRAWN BY _____ LOGMILE 09005001.59
CHECKED BY _____ T.I.M.S. NO. ~~1469, 1470,~~ 1471, ~~1472~~
F.A.P. NO. _____ TOD NO. _____

DRAWING NO. TS 340G 1 OF 1 SHEET NO. OF

APPROVALS

TEAM LEADER
ASST. DIV. CHIEF
DIVISION CHIEF
OFFICE DIRECTOR

ORIGINAL ON FILE

REVISIONS

0 AS-BUILT 06-06-2007
M.H.

2 INSTALL OPTICOM DETECTOR EYE. SHA # AT9095185 09/14/2006
J.W.A. D.J.D. J.A.H. M.A.R. W.H.

3 REPLACED SIGNAL HEADS W/ BLACK FACES. ASSOC., WIRING. & ADDED ASSOCIATED SHIELD ASSEMBLY SIGNS: SHA NO. XX1065185 05/1998
W.M. D.J.D. D.A.Z. B.R.K.

PLOTTED: WEDNESDAY, AUGUST 29, 2007 AT 07:43 AM
FILE: P:\04-005 SIGNALS\US 50 APS\DRAWINGS\US 50 APS ASBUILTS\US 50 & CRUSADER\H663GP01.DGN