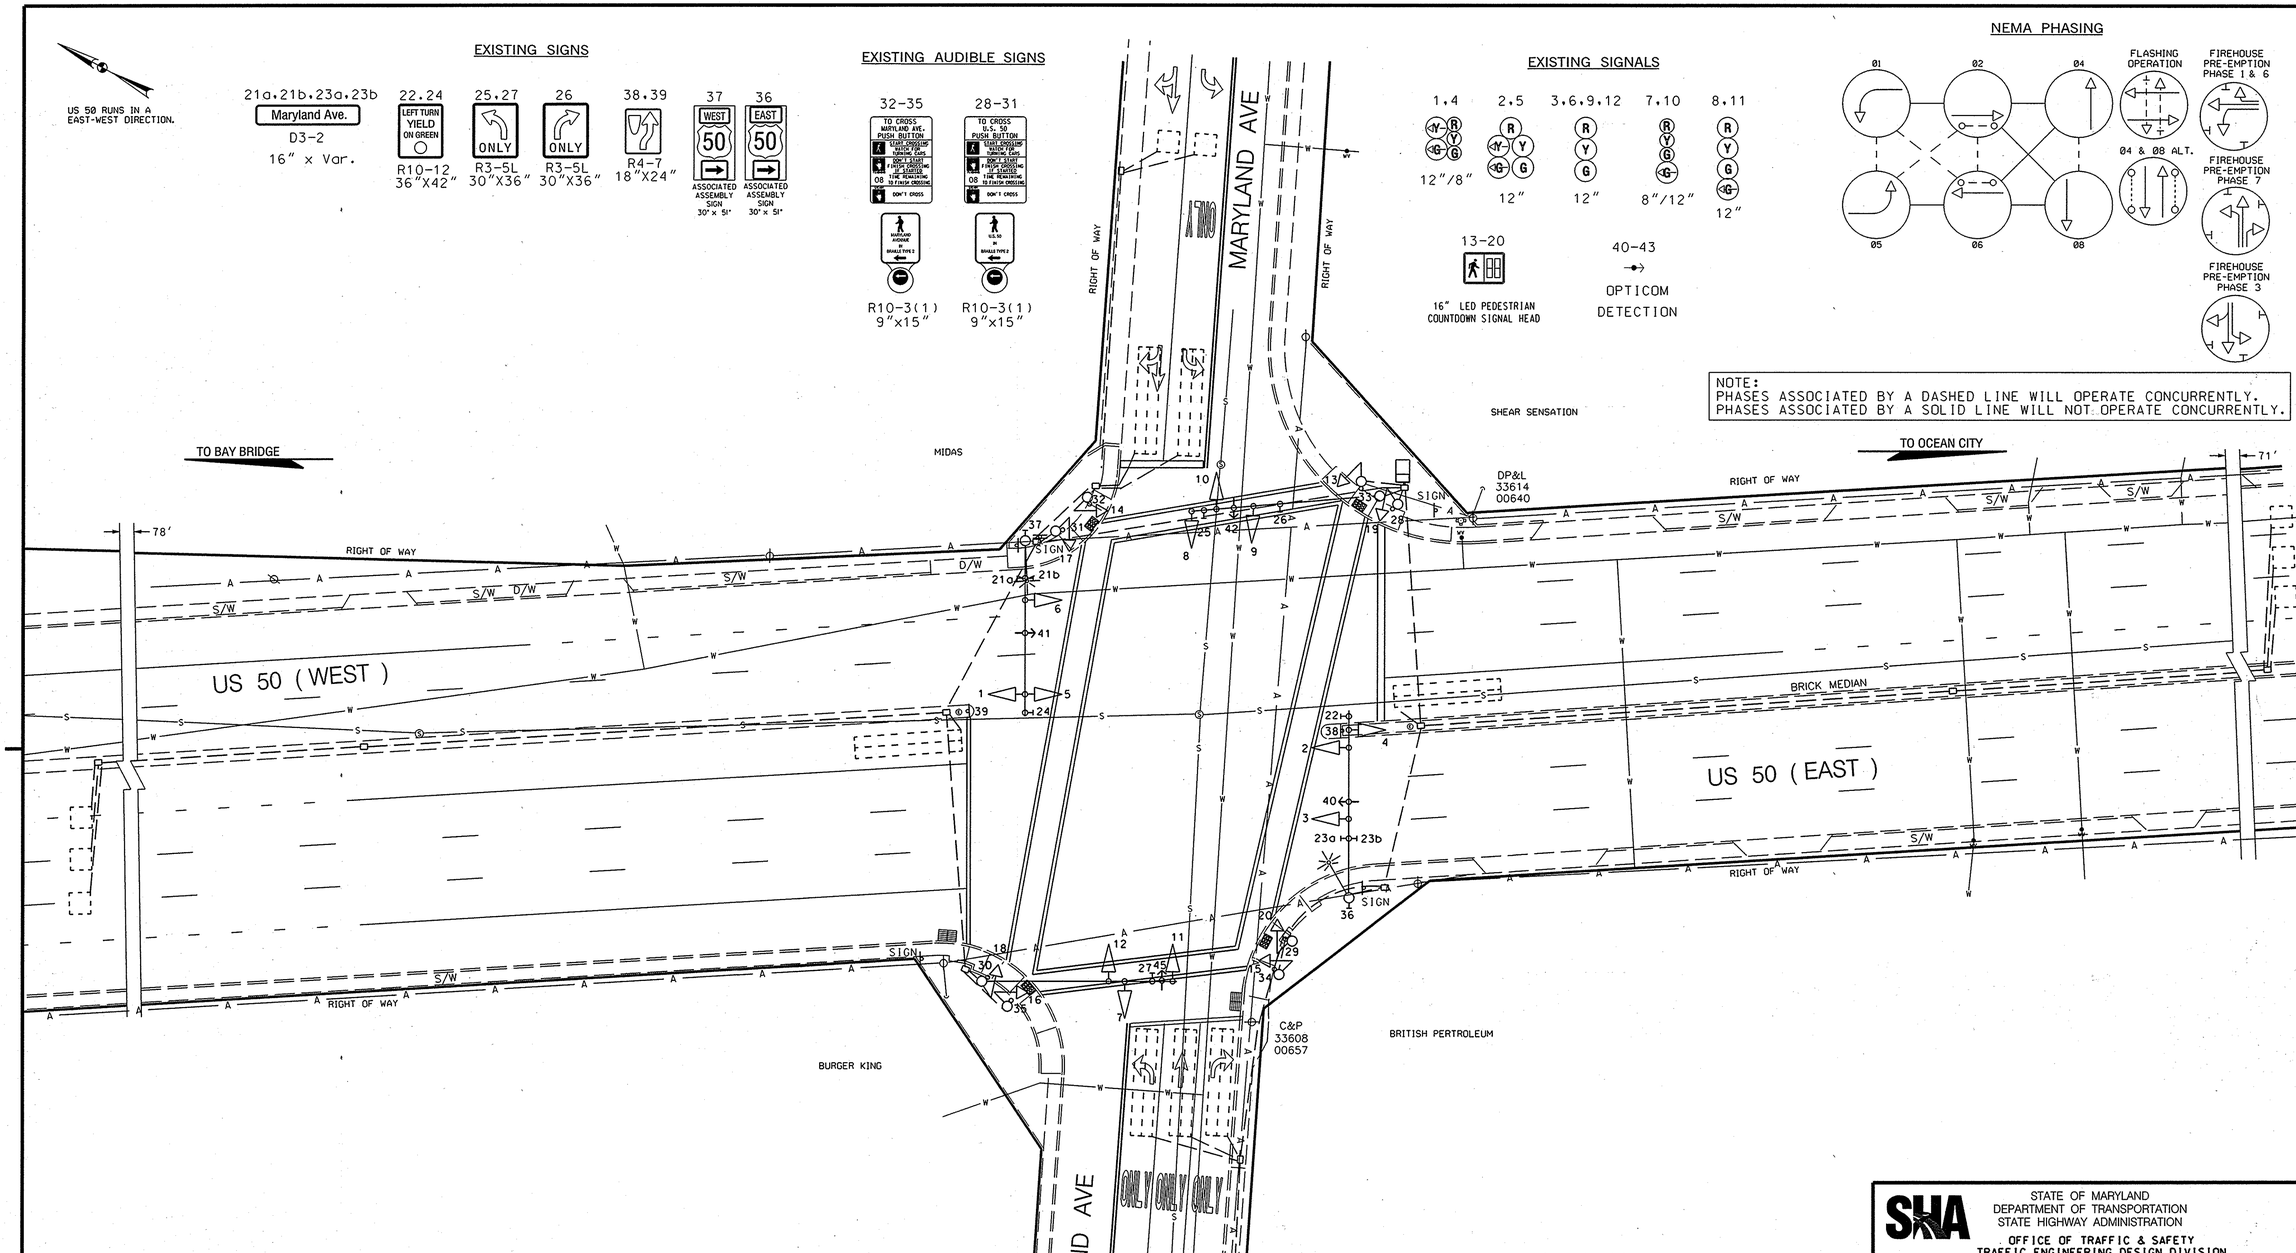

GEOMETRIC LEGEND

EXISTING
PROPOSED

UTILITY LEGEND

SD	SD	STORM DRAIN
G	G	GAS MAIN
W	W	WATER MAIN
S	S	SEWER MAIN
E	E	ELECTRIC CABLES
A	A	AERIAL CABLES
T	T	TELEPHONE CABLES
F	F	FIBER-OPTIC

BY: ROBERT

BAI

BRUDIS & ASSOCIATES, INC.
CONSULTING ENGINEERS
9220 RUMSEY ROAD SUITE 110
COLUMBIA, MARYLAND 21045
410-884-3607 410-884-3609(FAX)

APPROVALS

TEAM LEADER
ASST. DIV. CHIEF
DIVISION CHIEF
OFFICE DIRECTOR

ORIGINAL ON FILE

REVISIONS

(M) AS-BUILT 07-23-2007
M.H.

(G) REPLACED ALL SIGNAL HEADSW/ BLACK FACES & ASSOC. WIRING; ADDED ASSOCIATED ASSEMBLY SIGNS; SHA NO. XX1065185 10/2002
W.M. | D.J.D. | D.A.J. | B.R.K.

(F) ADDED FIREHOUSE PRE-EMPTION TO W/B US 50 & S/B MARYLAND AVENUE SHA NO. AW-2765185 05/1998
W.M. | E.M.M. | D.A.J. | B.R.K.

SHA

STATE OF MARYLAND
DEPARTMENT OF TRANSPORTATION
STATE HIGHWAY ADMINISTRATION
OFFICE OF TRAFFIC & SAFETY
TRAFFIC ENGINEERING DESIGN DIVISION

US 50 AT MARYLAND AVENUE

AS-BUILT PLAN

SCALE 1"= 20' DATE 08/03/1982 CONTRACT NO.

DESIGNED BY
DRAWN BY B. THOMPSON
CHECKED BY
F.A.P. NO.

COUNTY DORCHESTER
LOGMILE 09005001.05
T.I.M.S. NO. ~~1469.1470.1471.1472~~
TOD NO.

DRAWING NO. TS 343H 1 OF 1 SHEET NO. OF

PLOTTED: WEDNESDAY, AUGUST 29, 2007 AT 07:44 AM
FILE: P:\04-005 SIGNALS\US 50 APS\DRAWINGS\US 50 APS ASBUILTS\US 50 & MARYLAND\MSG-P002_US50eMD.DGN
02-06-1992

(07/08/29 07:44)