F H WA REGION NO	STATE	FED. AID PROJ. NO	SHEET NO.	TOTAL SHEETS
3	MD.			

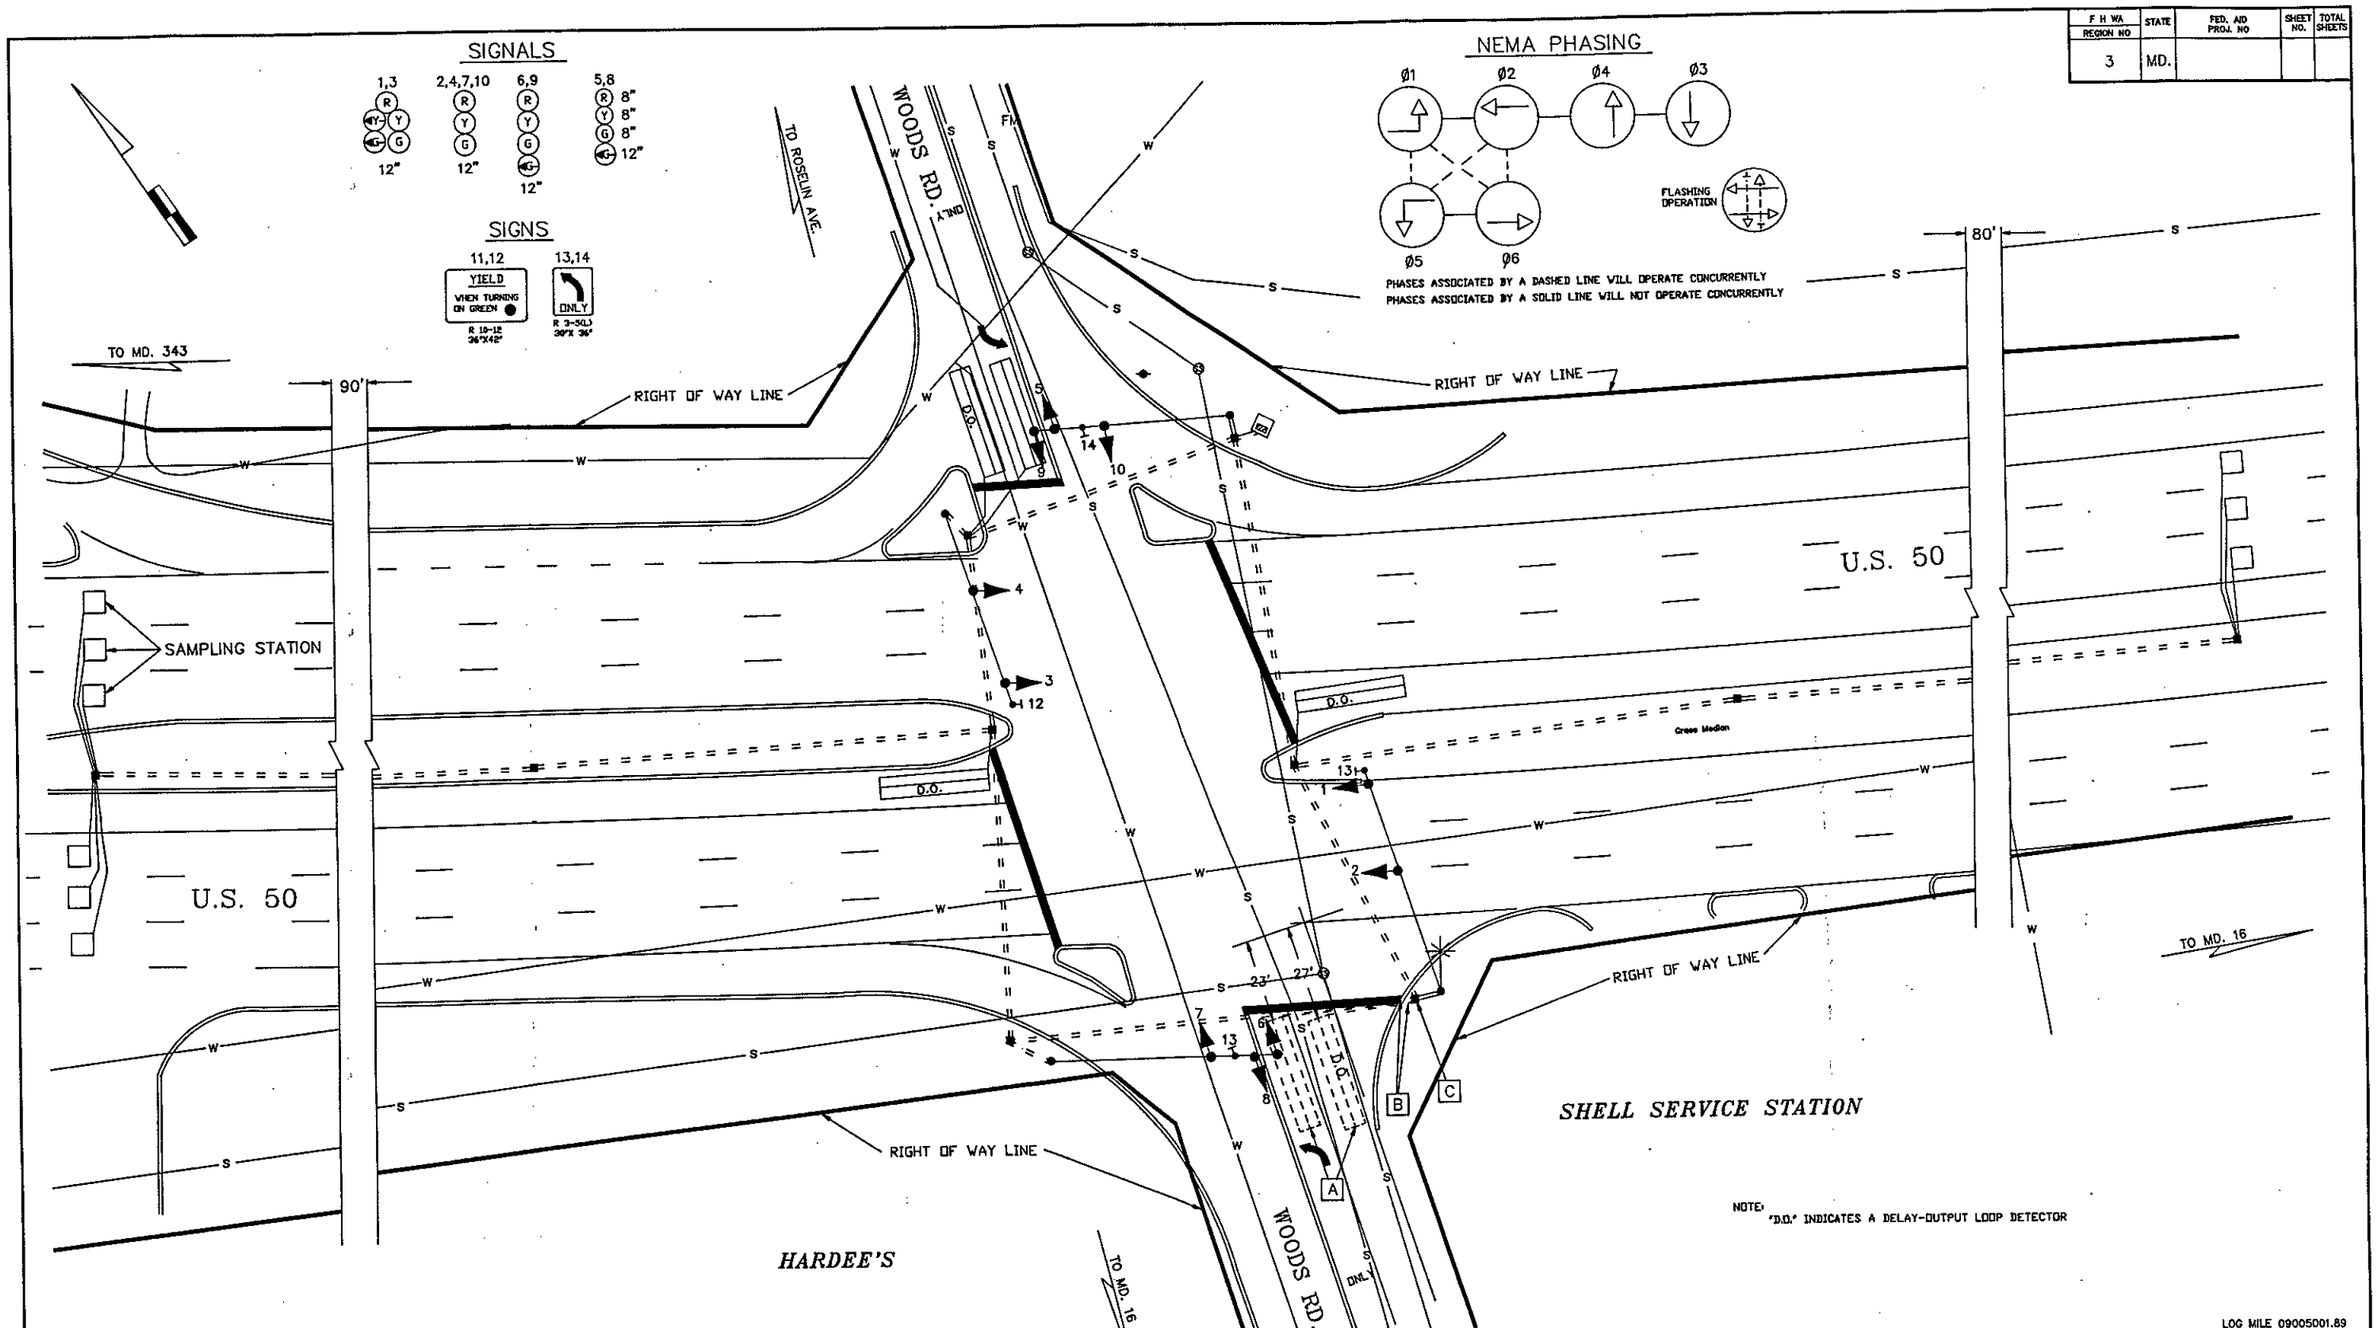

UTILITY LEGEND

—G—G—	GAS MAIN
—W—W—	WATER MAIN
—S—S—	SEWER MAIN
—E—E—	ELECTRIC CABLES
—A—A—	AERIAL CABLES
—T—T—	TELEPHONE CABLES

REVISIONS	APPROVALS
① AS BUILT 1/29/91	ORIGINAL ON FILE
C.J.	CHIEF, SIGNAL DESIGN SECTION
② 1/29/91 RECUT DETECTOR LOOPS ON N/B WOODS RD.	ASST. DISTRICT ENGINEER, TRAFFIC
C.J.	CHIEF, TRAFFIC ENGINEERING DIVISION
	DEPUTY CHIEF ENGINEER, OFFICE OF TRAFFIC

MDOT – STATE HIGHWAY ADMINISTRATION
Office of Traffic
TRAFFIC ENGINEERING DIVISION

SIGNAL #

RE-DRAWN BY: C. JEDNORSKI
DES. BY: THE TRAFFIC GROUP,INC.
CHK. BY:

U.S. 50 AND WOODS RD.

COUNTY: DORCHESTER

DATE: 6/86 (REVISION "H")
SCALE: 1" = 20'
F.A.P. NO.
S.H.A. NO. D 515-501-170

TS/STD. NO. TS-350 J

SHEET NO. ___ OF ___

09005001.89