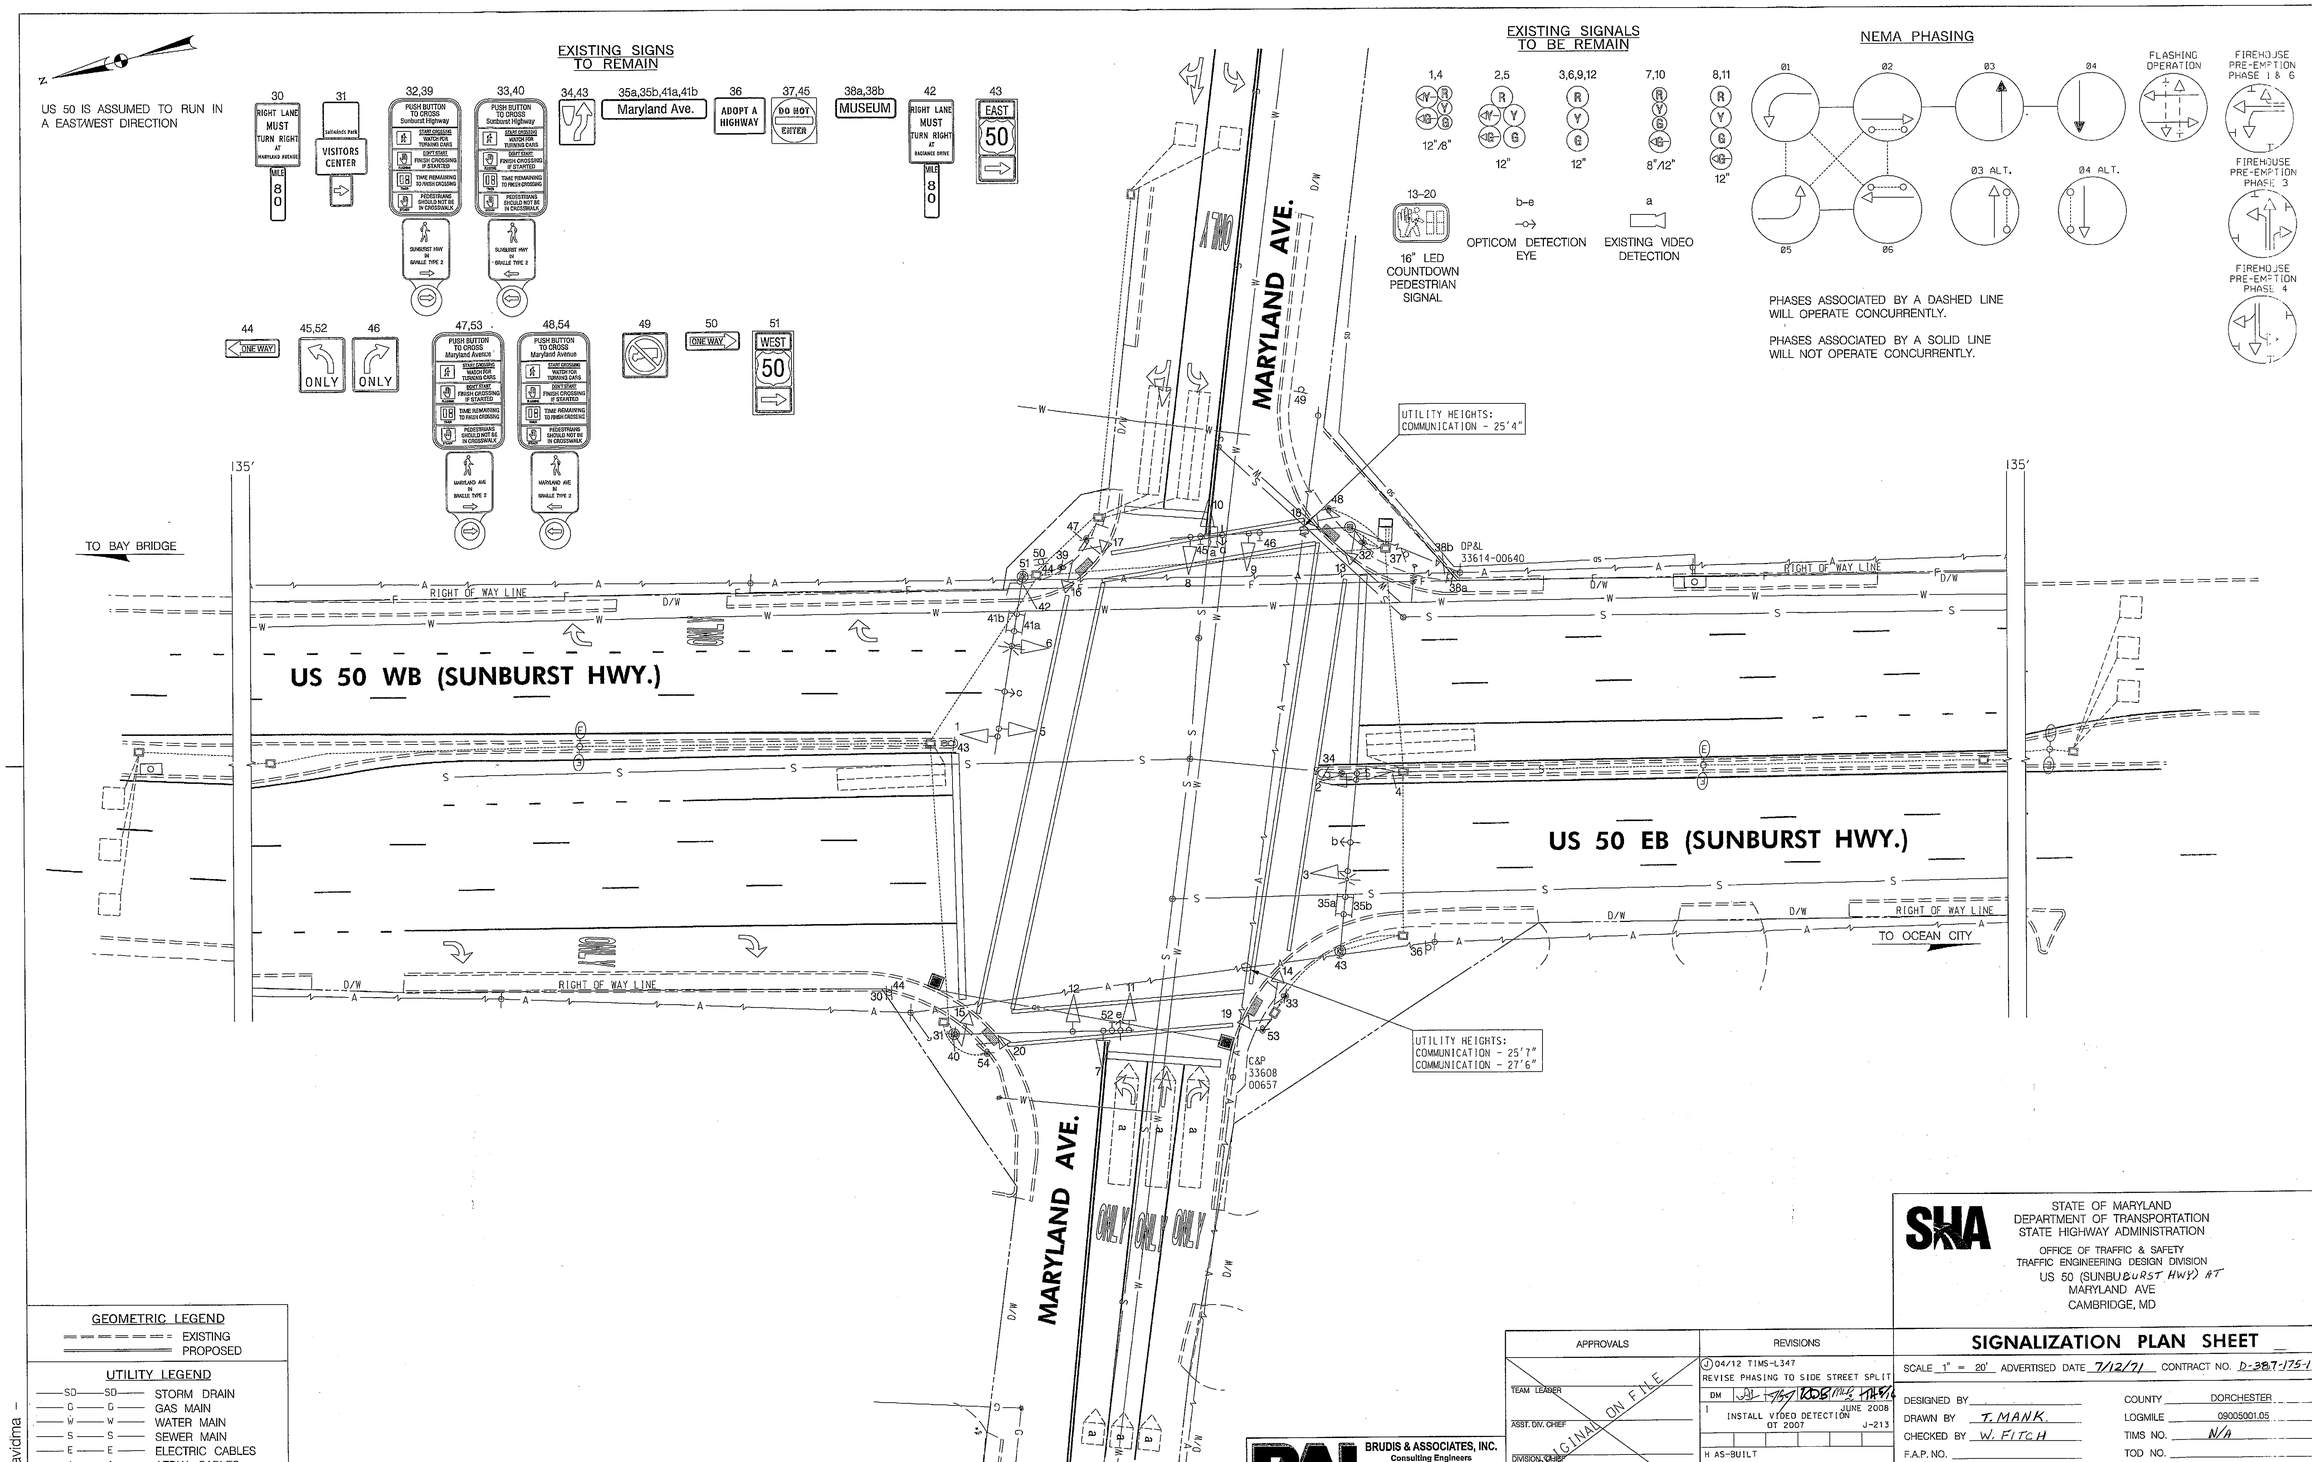

GEOMETRIC LEGEND

EXISTING
PROPOSED

UTILITY LEGEND

SD	STORM DRAIN
G	GAS MAIN
W	WATER MAIN
S	SEWER MAIN
E	ELECTRIC CABLES
A	AERIAL CABLES
T	TELEPHONE CABLES
F	FIBER-OPTIC

BY: davidma -

BRUDIS & ASSOCIATES, INC.
Consulting Engineers
9240 Rumsey Road; Suite 110
Columbia, Maryland 21045
Phone 410-884-3607
www.brudis.com

APPROVALS

TEAM LEADER
ASST. DIV. CHIEF
DIVISION CHIEF
OFFICE DIRECTOR

ORIGINAL ON FILE

REVISIONS

04/12 TIMS-L347
REVISE PHASING TO SIDE STREET SPLIT
DM JUNE 2008
INSTALL VIDEO DETECTION OT 2007 J-213
H AS-BUILT 07-23-2007
M.H.

SHA

STATE OF MARYLAND
DEPARTMENT OF TRANSPORTATION
STATE HIGHWAY ADMINISTRATION
OFFICE OF TRAFFIC & SAFETY
TRAFFIC ENGINEERING DESIGN DIVISION
US 50 (SUNBURST HWY) AT
MARYLAND AVE
CAMBRIDGE, MD

SIGNALIZATION PLAN SHEET

SCALE 1" = 20' ADVERTISED DATE 7/12/71 CONTRACT NO. D-387-175-176

DESIGNED BY
DRAWN BY T. MANK
CHECKED BY W. FITCH
F.A.P. NO.
COUNTY DORCHESTER
LOGMILE 09005001.05
TIMS NO. N/A
TOD NO.

TS NO. 343J | DRAWING SG-1 OF 1 | SHEET NO. 1 OF 2

PLOTTED: Thursday, April 12, 2012 AT 10:18 AM
FILE: P:\09-002 TEDD\Task 85 US 50 & Maryland Ave\Drawings\CADD\Working\pSG-P001_US50@Maryland.dgn