F H WA REGION NO	STATE	FED. AID PROJ. NO	SHEET NO.	TOTAL SHEETS
3	MD.			

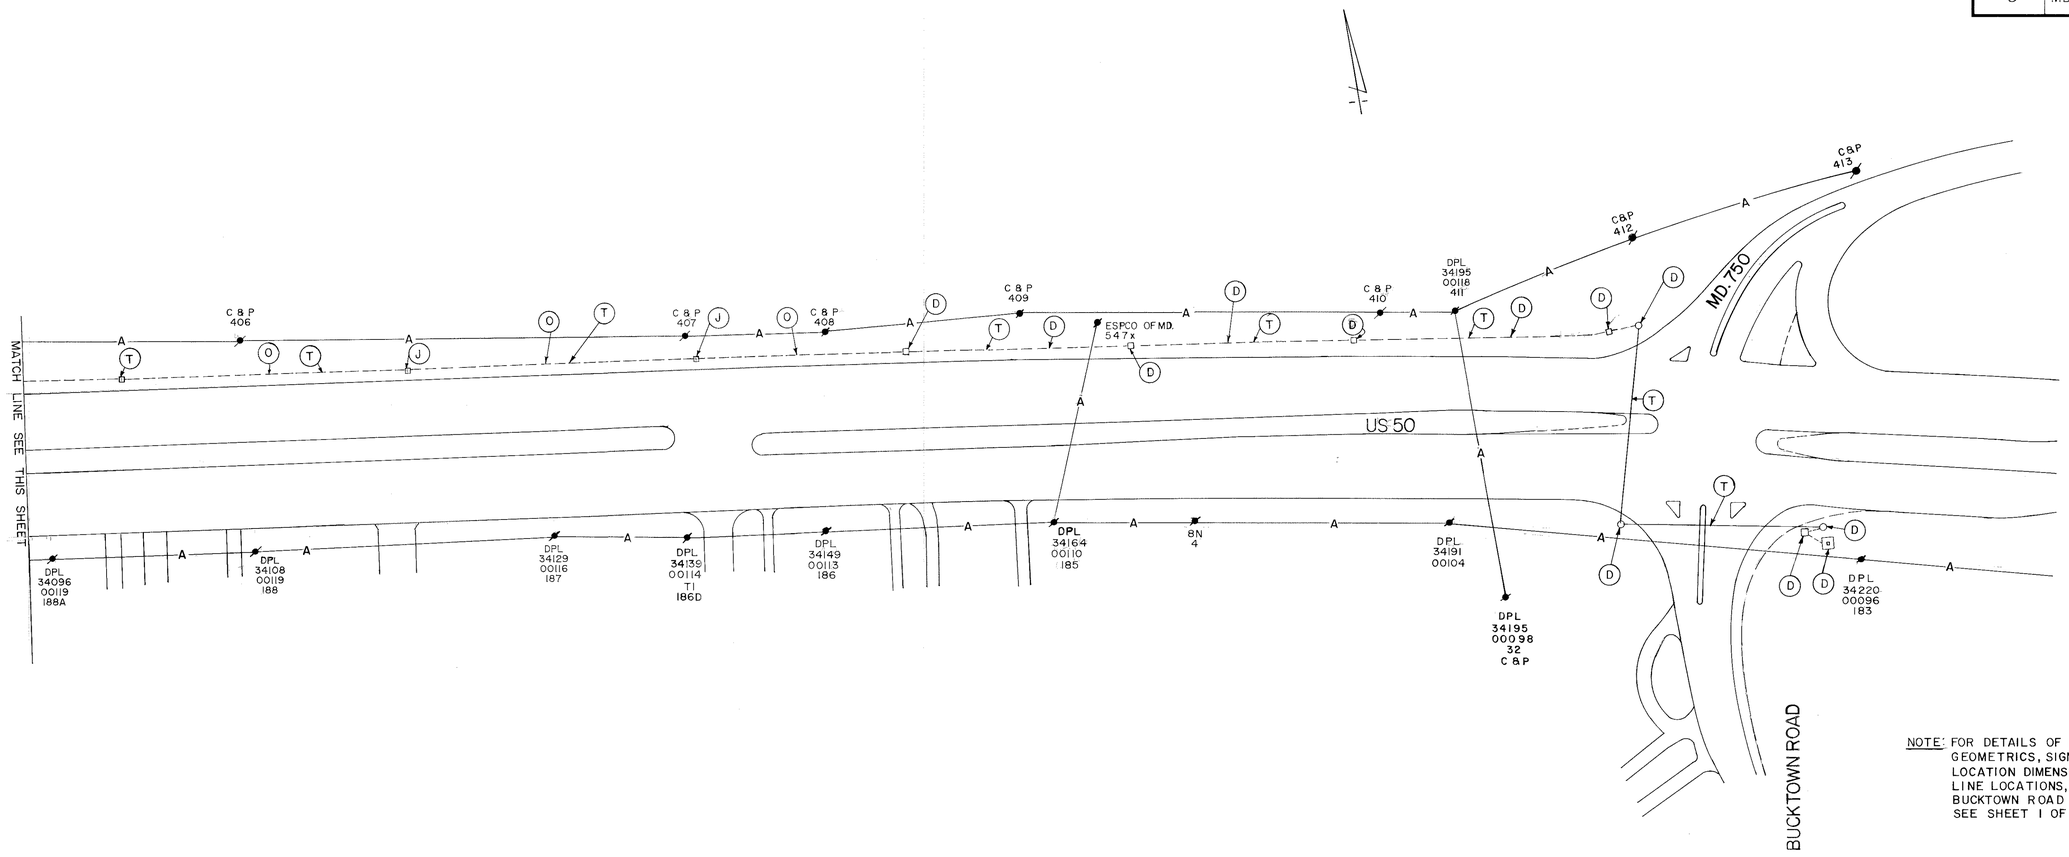

NOTE: FOR DETAILS OF PROPOSED GEOMETRICS, SIGNAL POLE LOCATION DIMENSIONS, STOP LINE LOCATIONS, AT US/50 BUCKTOWN ROAD INTERSECTION SEE SHEET 1 OF 2.

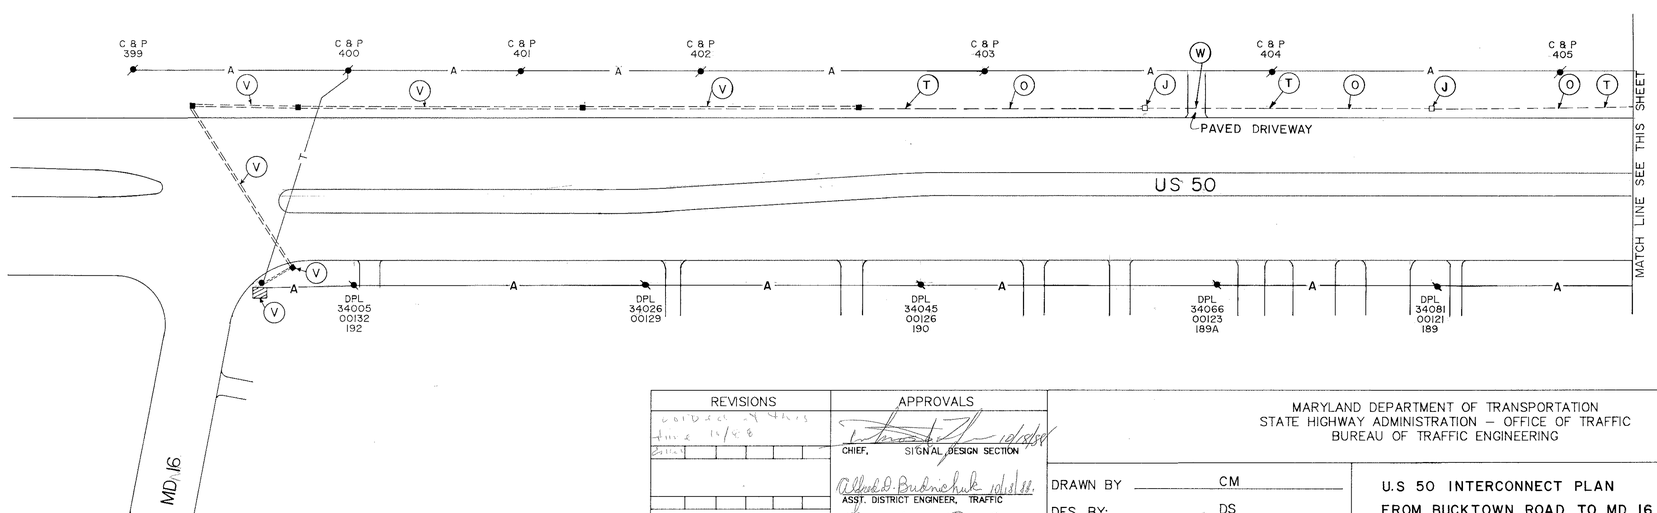

REVISIONS	APPROVALS
	CHIEF, SIGNAL DESIGN SECTION 10/18/88
	ASST. DISTRICT ENGINEER, TRAFFIC 10/18/88
	CHIEF, BUREAU OF TRAFFIC ENGINEERING 10-18
	DEPUTY CHIEF ENGINEER, OFFICE OF TRAFFIC 10-18-88

MARYLAND DEPARTMENT OF TRANSPORTATION
STATE HIGHWAY ADMINISTRATION – OFFICE OF TRAFFIC
BUREAU OF TRAFFIC ENGINEERING

DRAWN BY CM
DES. BY: DS
CHK. BY:

U.S 50 INTERCONNECT PLAN
FROM BUCKTOWN ROAD TO MD. 16

COUNTY: DORCHESTER

DATE: 8/18/88
SCALE: 1"=50'
F.A.P. NO.
S.H.A. NO. D-537-459-185
TS/FILE NO. 2497 X
SHEET NO. 2 OF 2

09005002.92