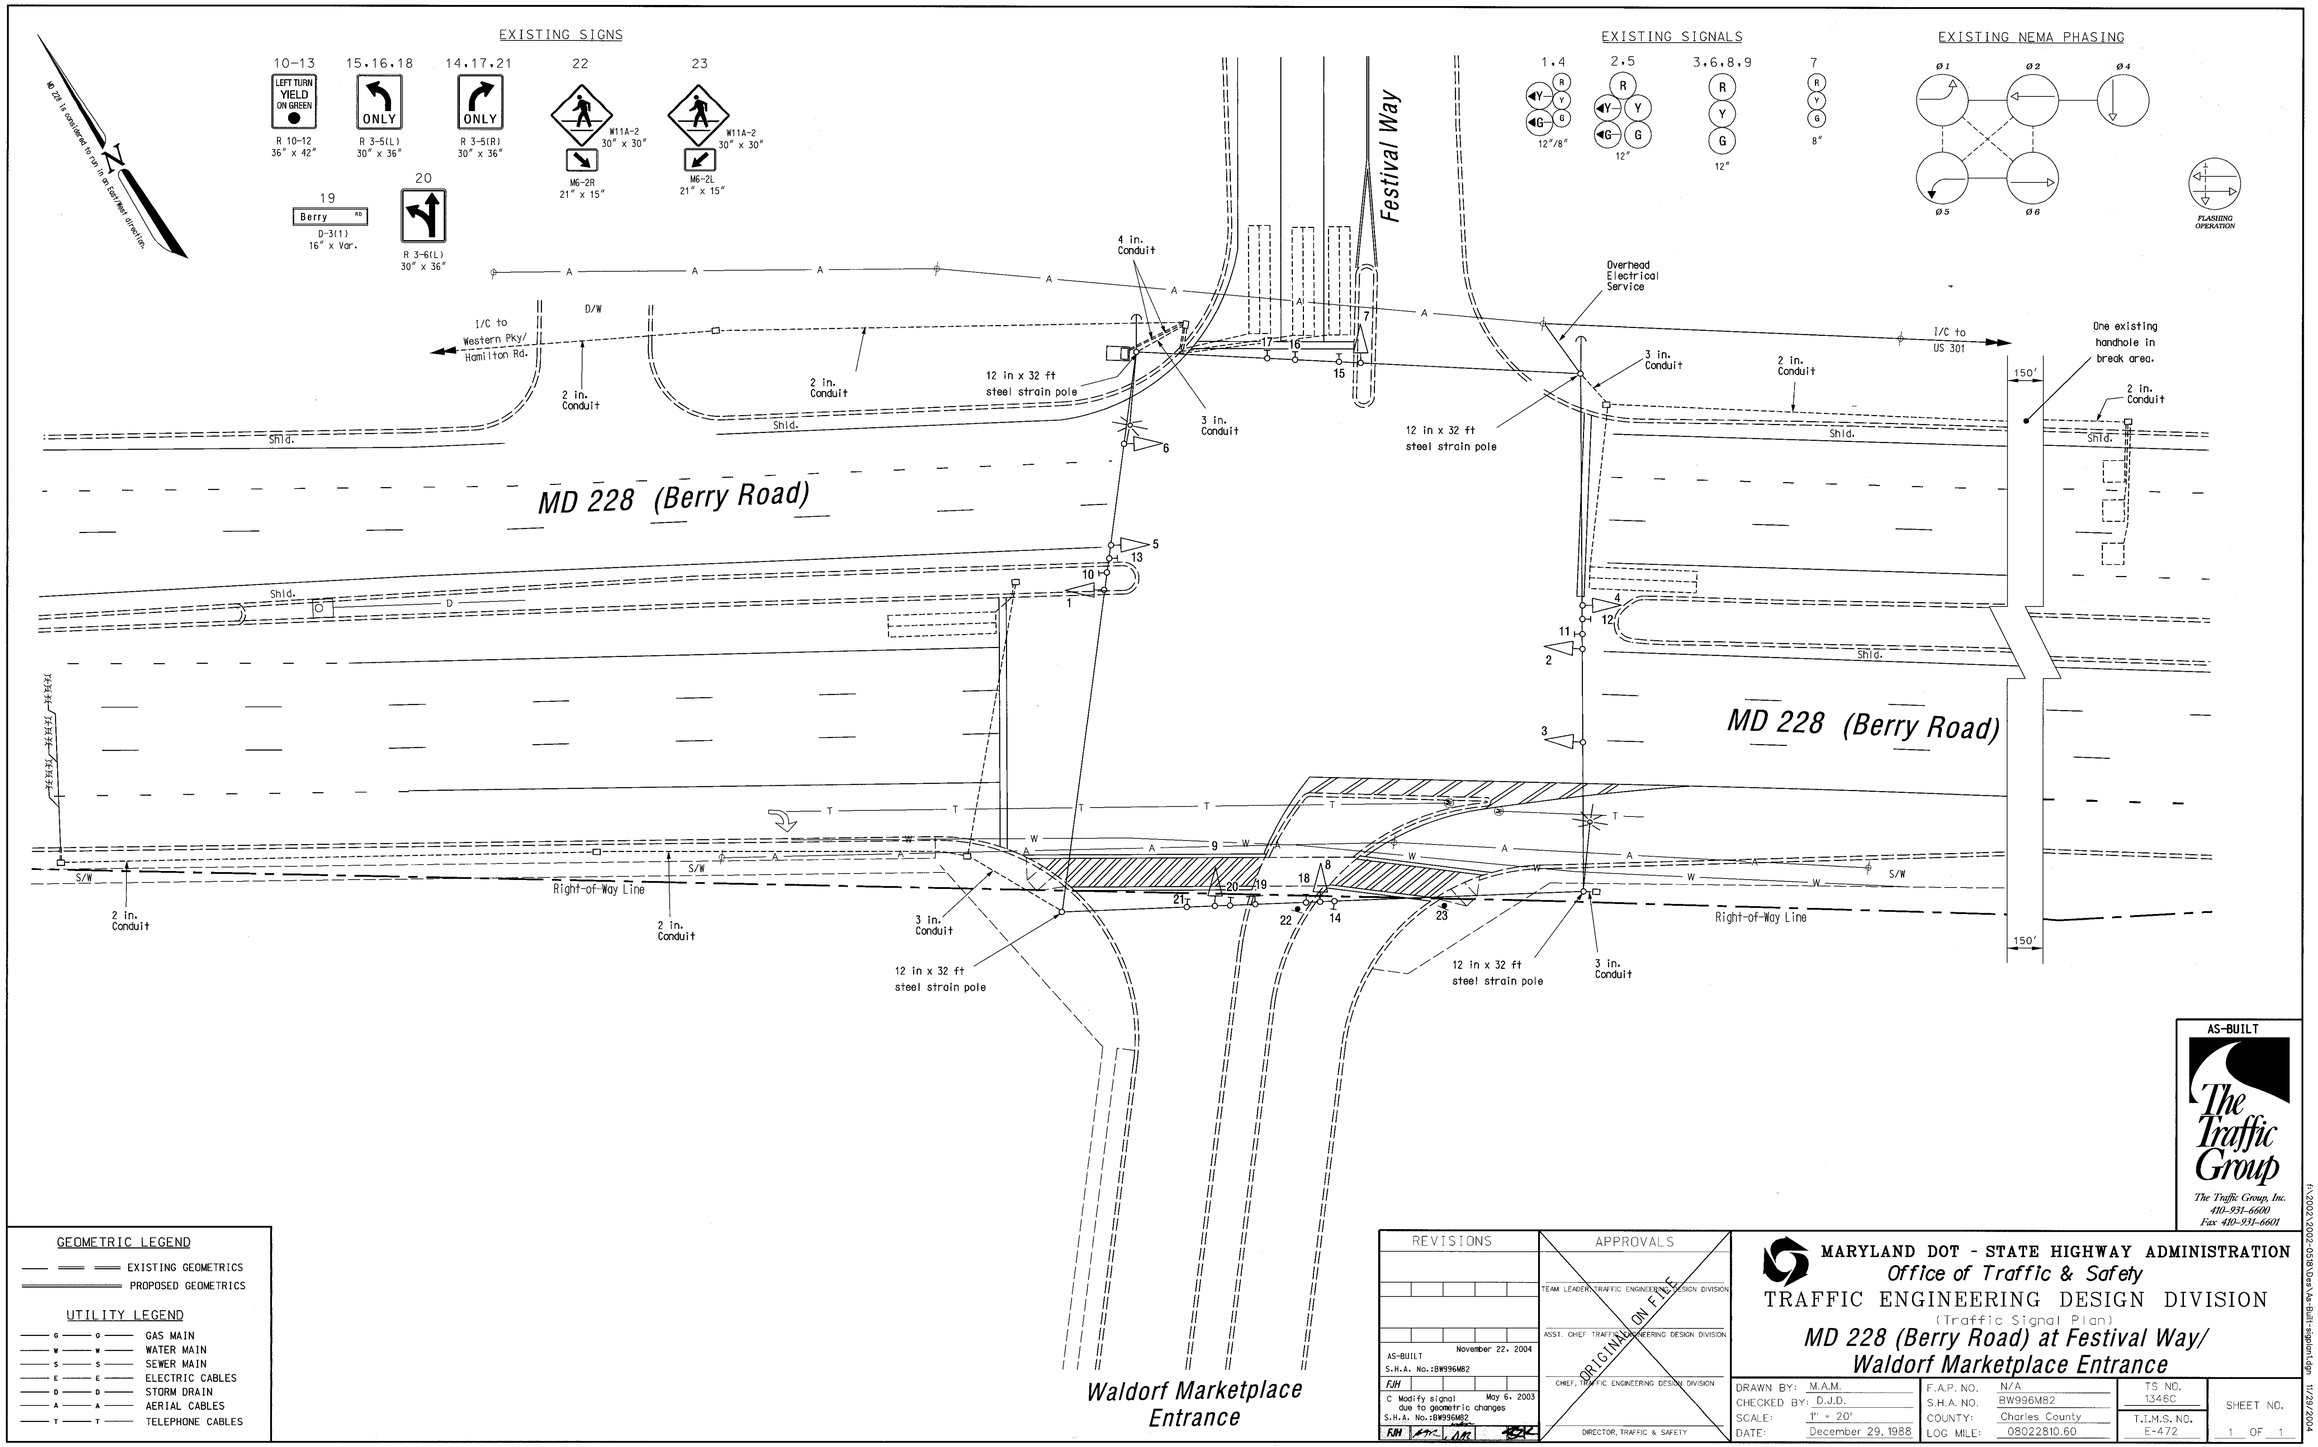

AS-BUILT

The Traffic Group

The Traffic Group, Inc.
410-931-6600
Fax 410-931-6601

GEOMETRIC LEGEND

- EXISTING GEOMETRICS
- PROPOSED GEOMETRICS

UTILITY LEGEND

G	GAS MAIN
W	WATER MAIN
S	SEWER MAIN
E	ELECTRIC CABLES
D	STORM DRAIN
A	AERIAL CABLES
T	TELEPHONE CABLES

REVISIONS	APPROVALS
AS-BUILT November 22, 2004 S.H.A. No.:BW996M82 FJH	TEAM LEADER, TRAFFIC ENGINEERING DESIGN DIVISION
C Modify signal due to geometric changes May 6, 2003 S.H.A. No.:BW996M82 FJH	ASST. CHIEF TRAFFIC ENGINEERING DESIGN DIVISION
	CHIEF, TRAFFIC ENGINEERING DESIGN DIVISION
	DIRECTOR, TRAFFIC & SAFETY

ORIGINAL ON FILE

MARYLAND DOT - STATE HIGHWAY ADMINISTRATION

Office of Traffic & Safety

TRAFFIC ENGINEERING DESIGN DIVISION

(Traffic Signal Plan)

MD 228 (Berry Road) at Festival Way/ Waldorf Marketplace Entrance

DRAWN BY:	M.A.M.	F.A.P. NO.	N/A	TS NO. 1346C	SHEET NO.
CHECKED BY:	D.J.D.	S.H.A. NO.	BW996M82		
SCALE:	1" = 20'	COUNTY:	Charles County	T.I.M.S. NO. E-472	1 OF 1
DATE:	December 29, 1988	LOG MILE:	08022810.60		

f:\2002\2002-0598\Des\As-Built-signal.dgn 11/29/2004