F.H.W.A. REGION NO.	STATE	FED. AID PROJ. NO.	SHEET NO.	TOTAL SHEETS
3	MD.		2	5

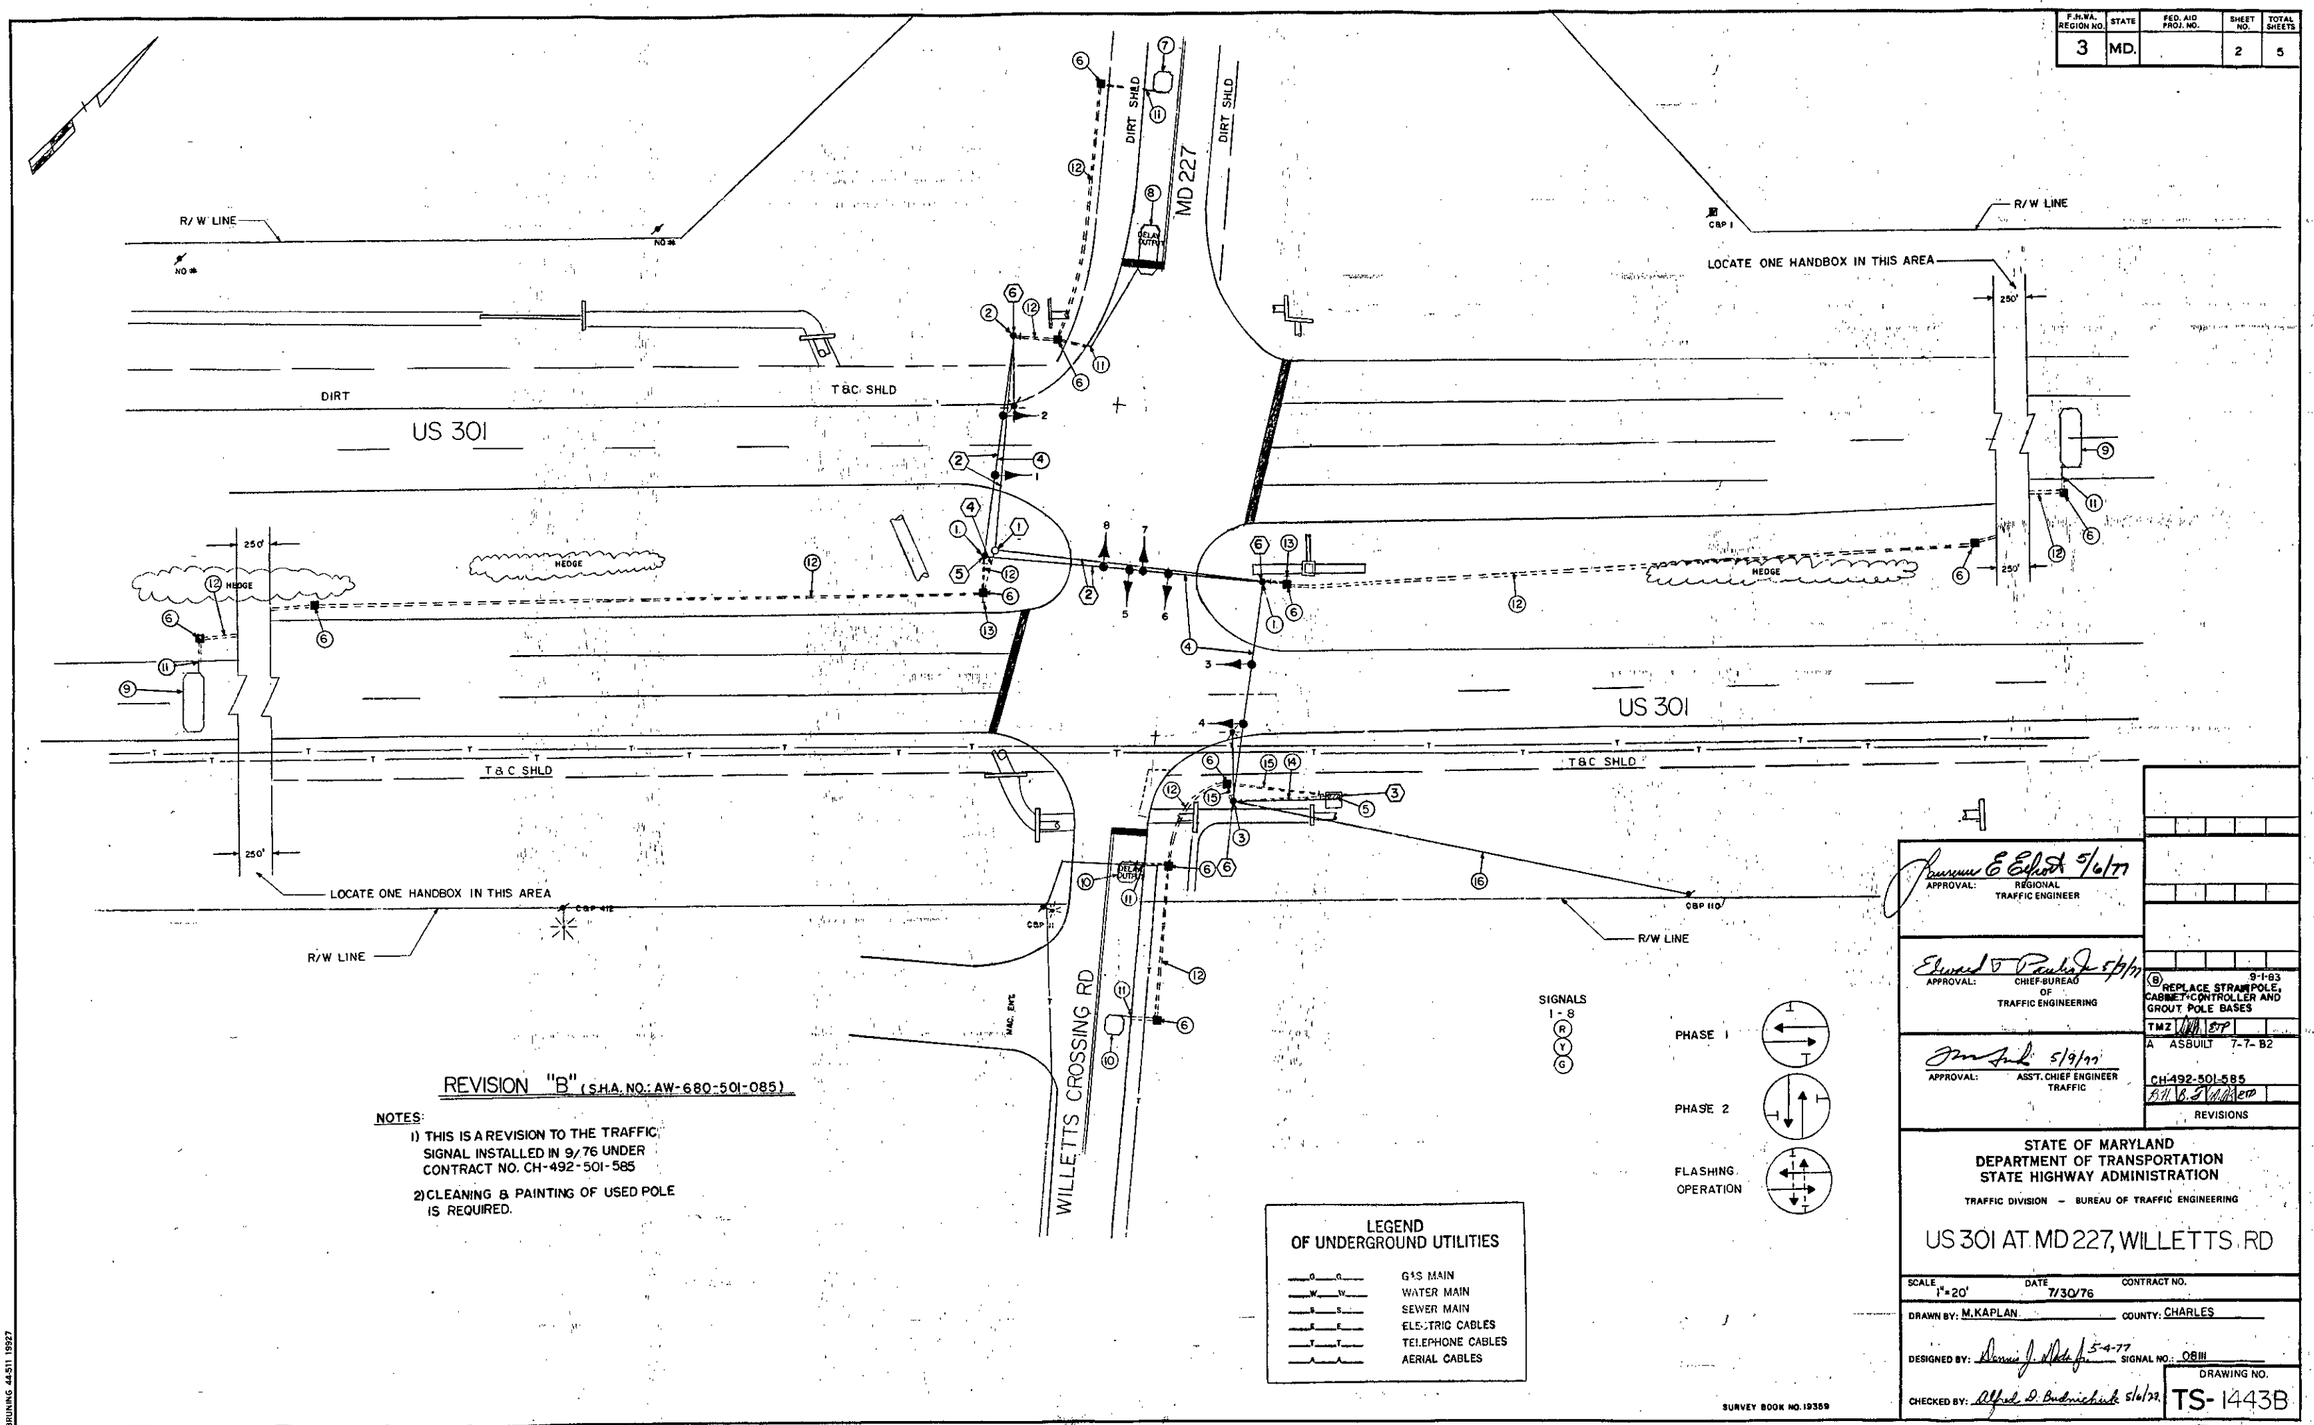

REVISION "B" (S.H.A. NO.: AW-680-501-085)

NOTES:

1) THIS IS A REVISION TO THE TRAFFIC SIGNAL INSTALLED IN 9/76 UNDER CONTRACT NO. CH-492-501-585

2) CLEANING & PAINTING OF USED POLE IS REQUIRED.

APPROVAL: REGIONAL TRAFFIC ENGINEER — 5/6/77

APPROVAL: CHIEF-BUREAU OF TRAFFIC ENGINEERING — 5/9/77

APPROVAL: ASS'T. CHIEF ENGINEER TRAFFIC — 5/9/77

(B) 9-1-83 REPLACE STRAIN POLE, CABINET, CONTROLLER AND GROUT POLE BASES

TMZ

A AS BUILT 7-7-82

CH-492-501-585

REVISIONS

STATE OF MARYLAND
DEPARTMENT OF TRANSPORTATION
STATE HIGHWAY ADMINISTRATION

TRAFFIC DIVISION – BUREAU OF TRAFFIC ENGINEERING

US 301 AT MD 227, WILLETTS RD

SCALE 1"=20' DATE 7/30/76 CONTRACT NO.

DRAWN BY: M. KAPLAN COUNTY: CHARLES

DESIGNED BY: 5-4-77 SIGNAL NO.: OBIII

CHECKED BY: 5/6/77

DRAWING NO. TS-1443B

080227/4.03

BRUNING 44-511 19927