F H W A REGION NO.	STATE	FED. AID PROJ. NO.	SHEET NO.	TOTAL SHEETS
3	MD		2	2

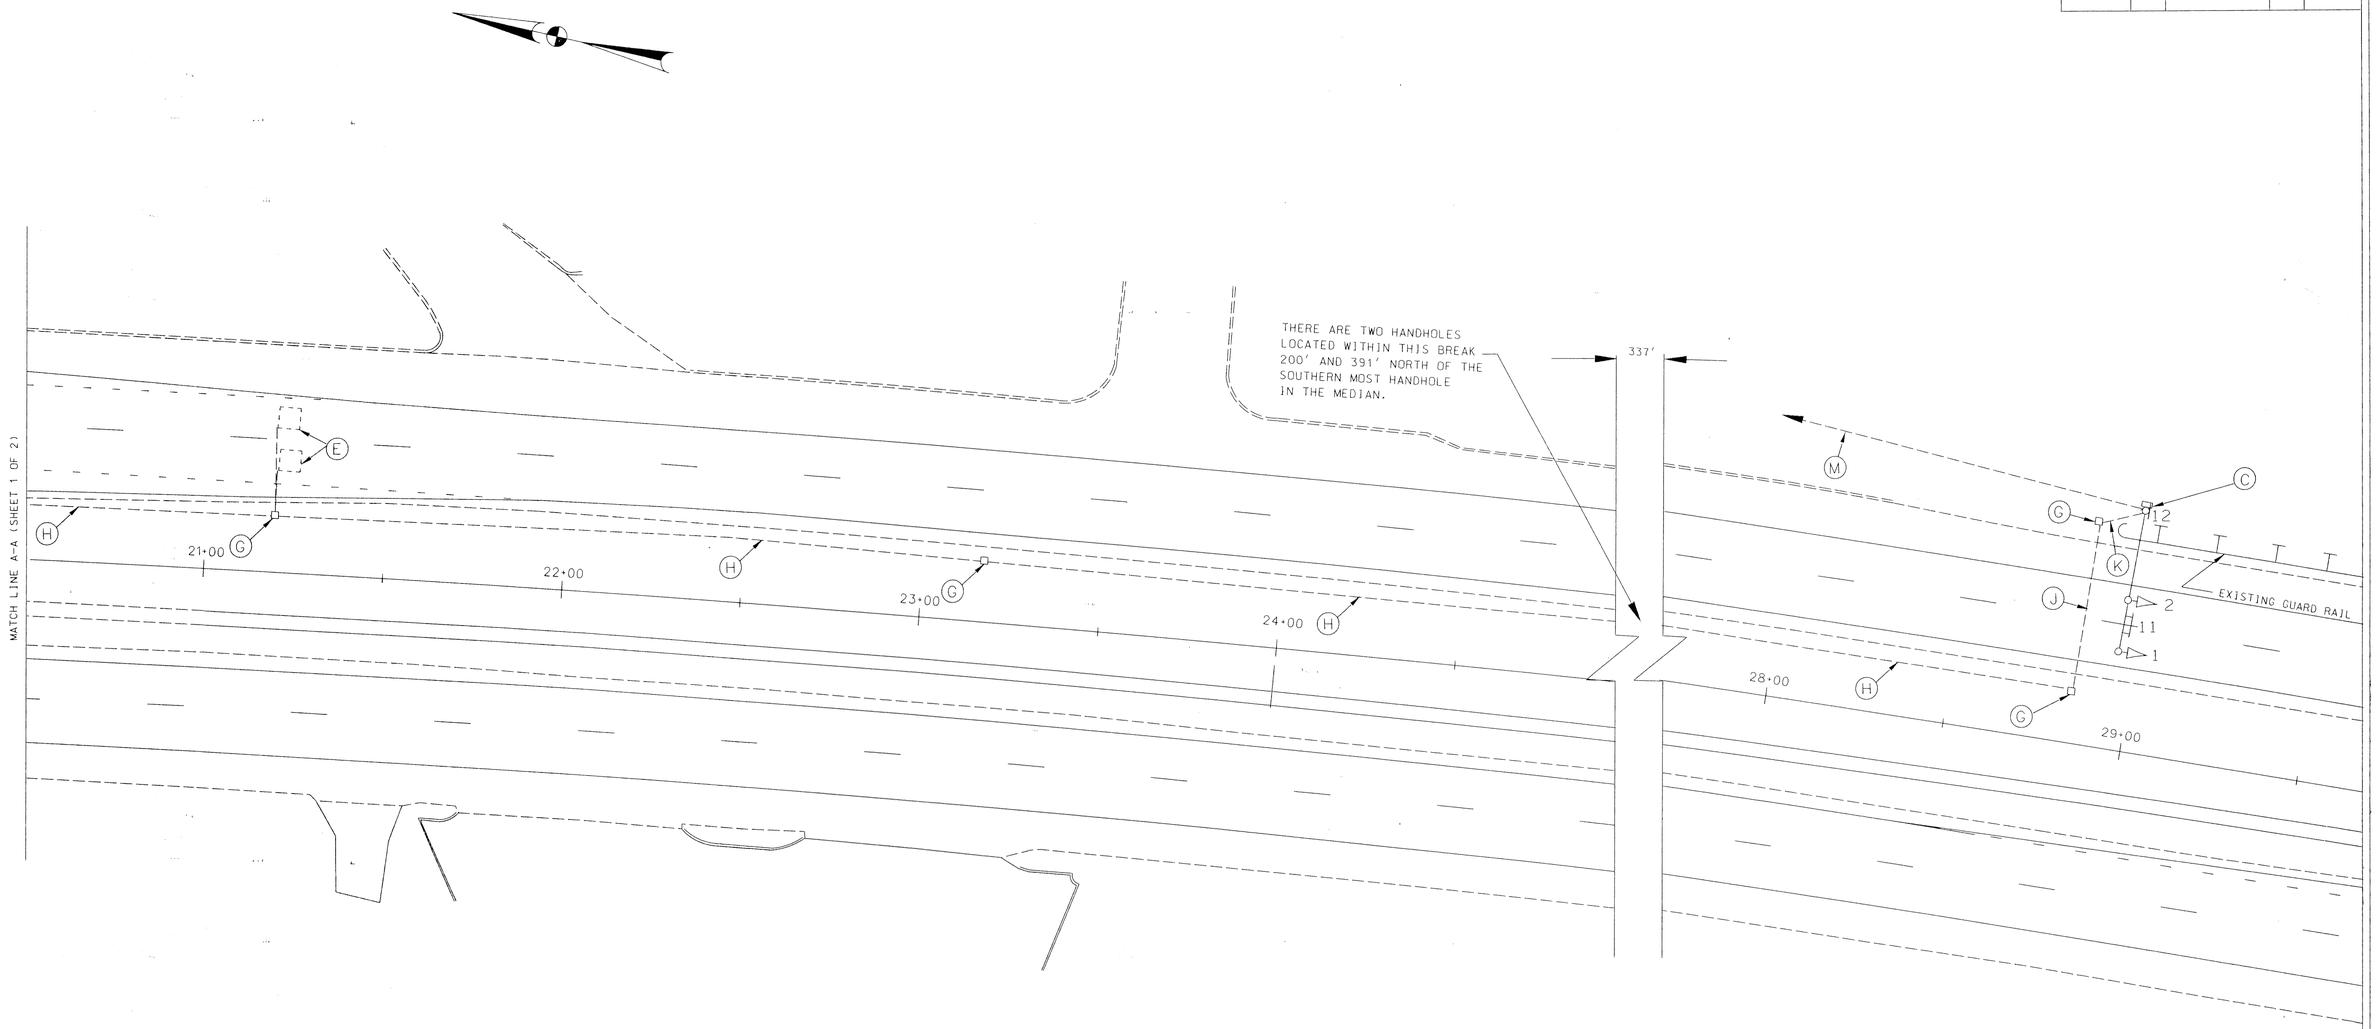

REVISIONS	APPROVALS
	CHIEF, SIGNAL DESIGN SECTION
	ASST. DISTRICT ENGINEER, TRAFFIC
	CHIEF, TRAFFIC ENGINEERING DESIGN DIVISION
Ⓐ 12/12/96 ASBUILT SHA NO. CH 600-501-585 RRZ	DEPUTY CHIEF ENGINEER, OFFICE OF TRAFFIC

STREET TRAFFIC STUDIES, LTD.
Gateway Intercontinental
7300 Corporate Drive, Suite 104
Linthicum, Maryland 21090
(410) 859-3333

MDOT - STATE HIGHWAY ADMINISTRATION
Office of Traffic & Safety
TRAFFIC ENGINEERING DESIGN DIVISION

ORIGINAL DRAWN BY: R. CICCHINI
DES. BY: D. PETERS
CHK. BY:

US 301 AT MD 234

LOG MILE = 08030105.80 COUNTY: CHARLES

DATE: JUNE, 1995 F.A.P. NO.
SCALE: 1" = 20' S.H.A. NO. CH 600-501-585

TS/FILE NO. 3522 AX

SHEET NO. 2 OF 2