F.H.WA. REGION NO.	STATE	FED. AID PROJ. NO.	SHEET NO.	TOTAL SHEETS
3	MD.		2	2

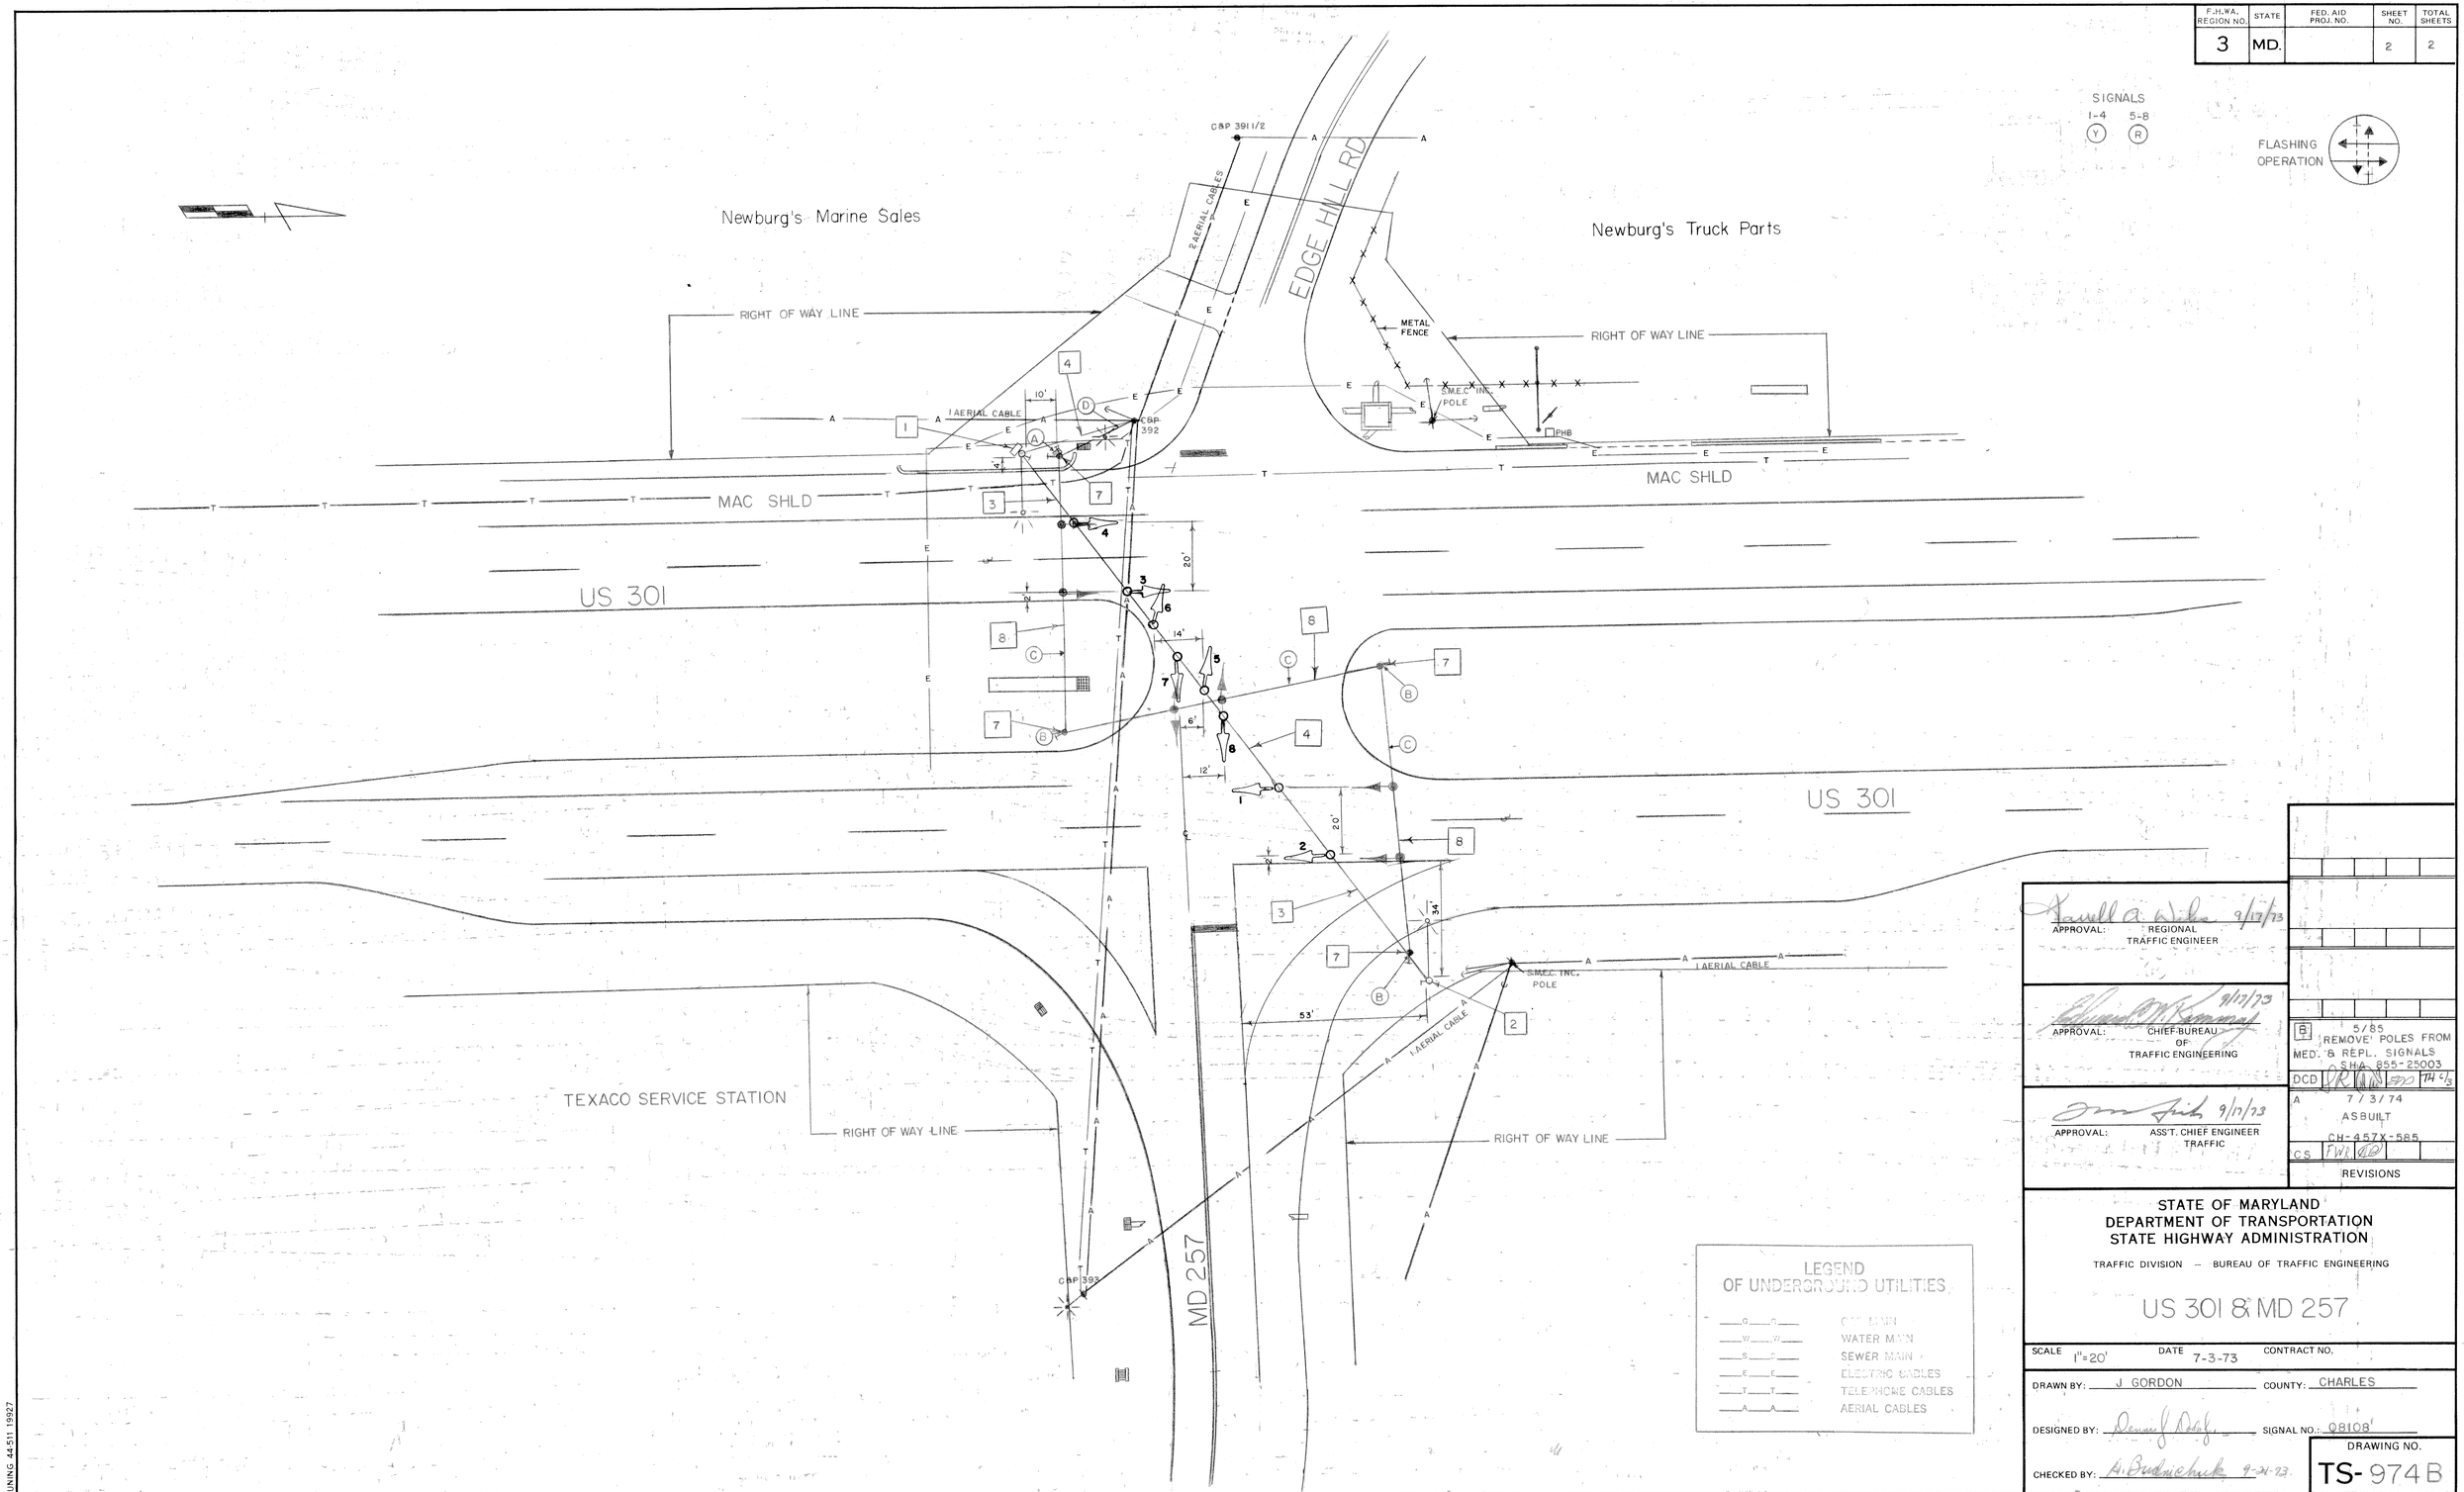

APPROVAL: REGIONAL TRAFFIC ENGINEER 9/17/73

APPROVAL: CHIEF BUREAU OF TRAFFIC ENGINEERING 9/17/73

APPROVAL: ASS'T. CHIEF ENGINEER TRAFFIC 9/17/73

B 5/85 REMOVE POLES FROM MED. & REPL. SIGNALS SHA 855-25003

DCD

A 7/3/74 ASBUILT CH-457X-585

CS FWR

REVISIONS

STATE OF MARYLAND
DEPARTMENT OF TRANSPORTATION
STATE HIGHWAY ADMINISTRATION

TRAFFIC DIVISION – BUREAU OF TRAFFIC ENGINEERING

US 301 & MD 257

SCALE 1"=20' DATE 7-3-73 CONTRACT NO.

DRAWN BY: J GORDON COUNTY: CHARLES

DESIGNED BY: SIGNAL NO.: 08108

CHECKED BY: A. Budnichuk 9-21-73

DRAWING NO. TS-974B

BRUNING 44-511 19927