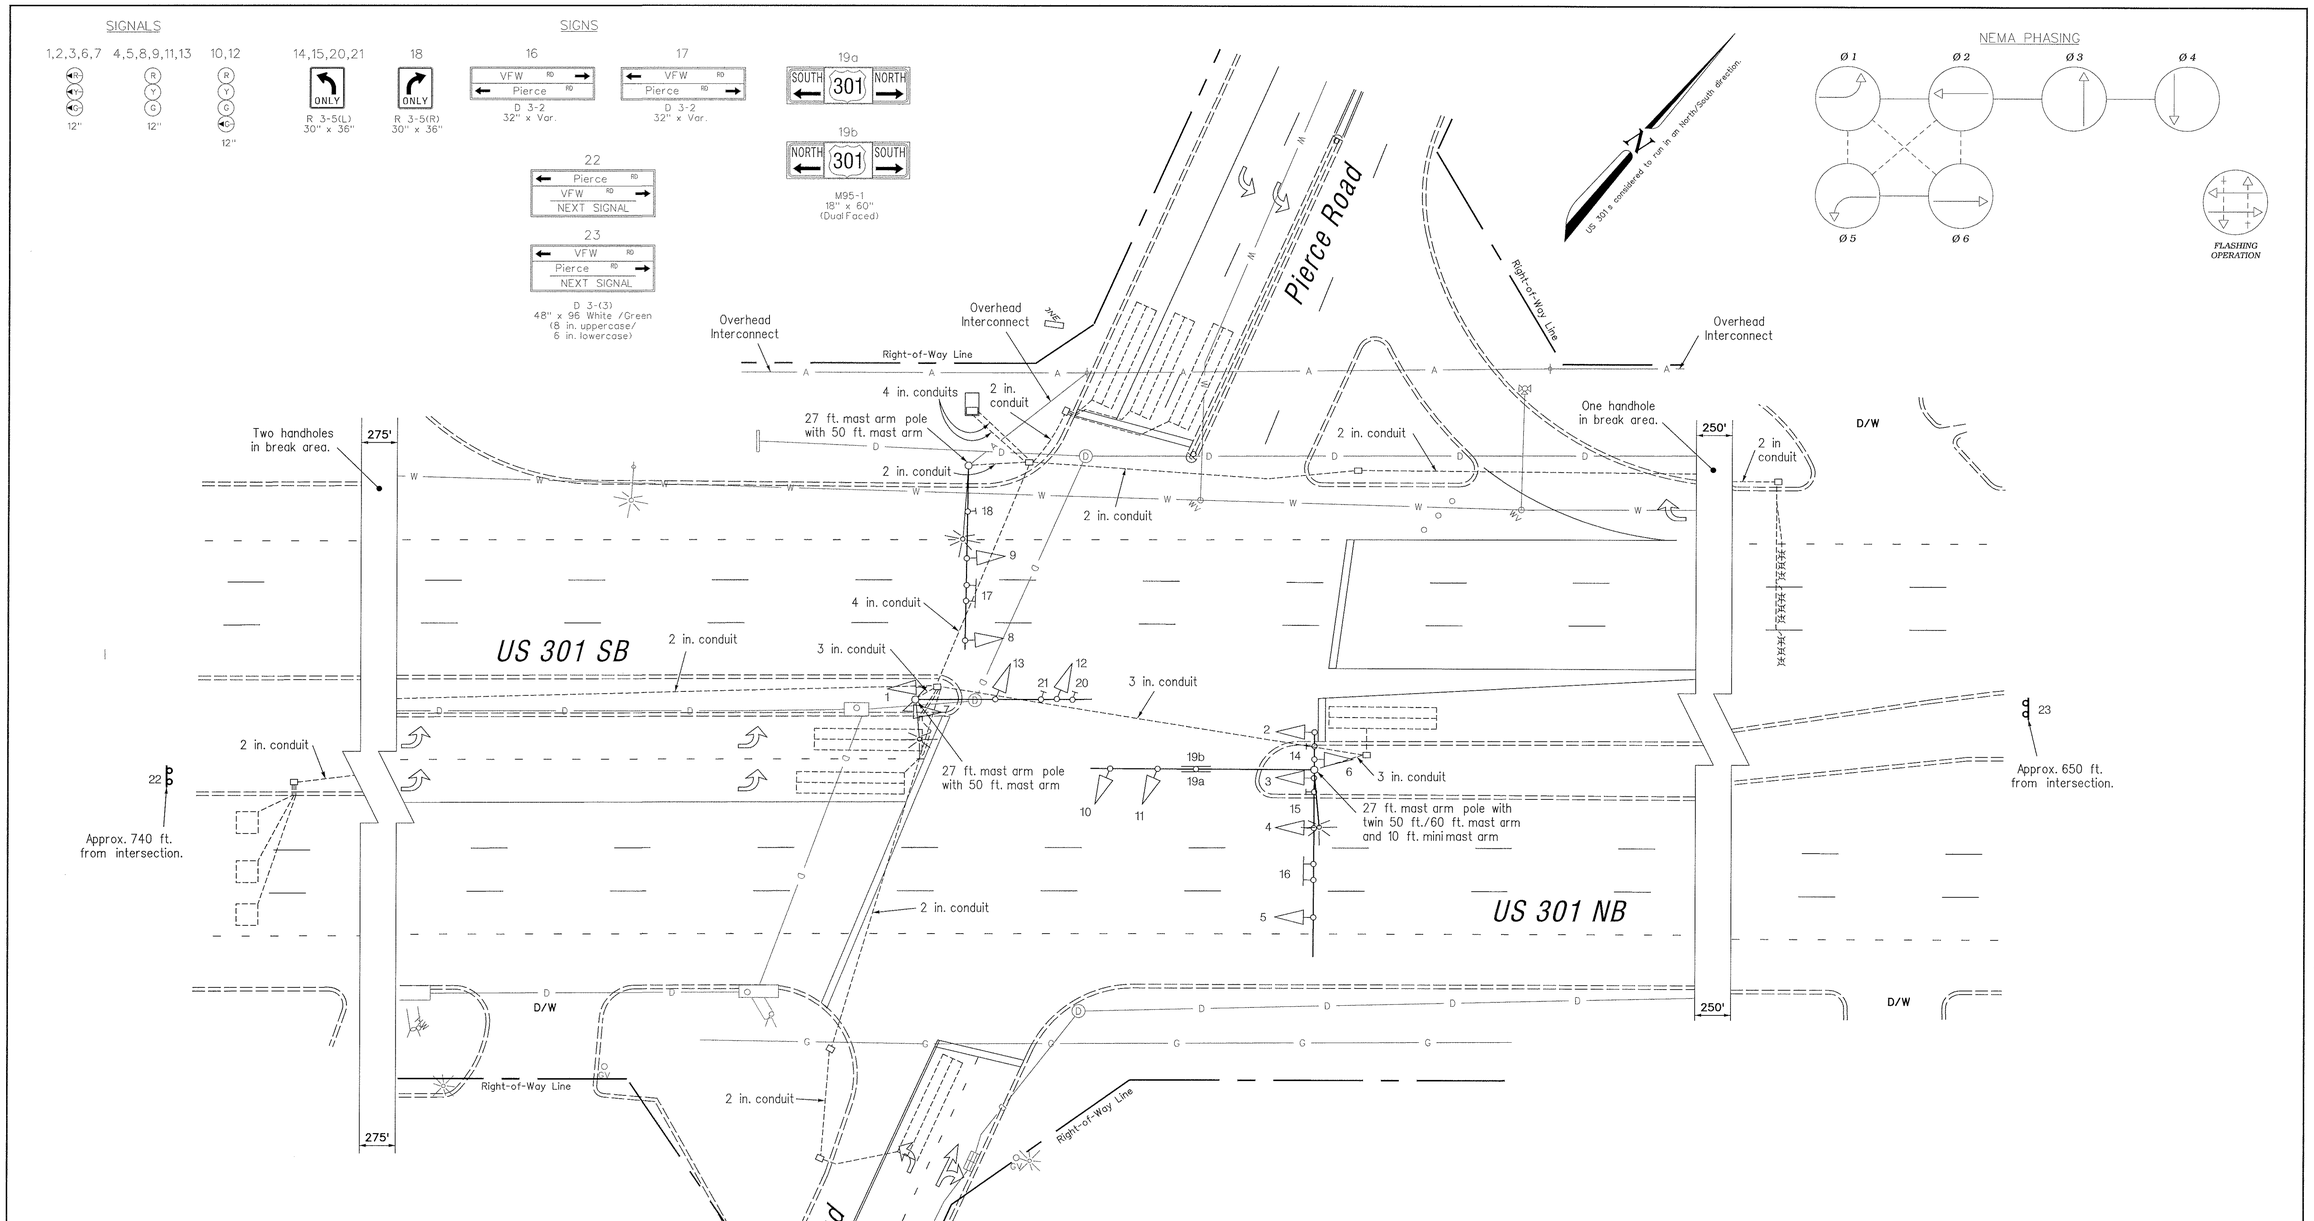

GEOMETRIC LEGEND

EXISTING GEOMETRICS

PROPOSED GEOMETRICS

UTILITY LEGEND

G	GAS MAIN
W	WATER MAIN
S	SEWER MAIN
E	ELECTRIC CABLES
D	STORM DRAIN
A	AERIAL CABLES
T	TELEPHONE CABLES

"AS-BUILT"

The Traffic Group

The Traffic Group, Inc.
410-931-6600
Fax 410-931-6601

REVISIONS

AS BUILT January 9, 2001
SHA NO. BW996M82
FDB

APPROVALS

ORIGINAL ON FILE

TEAM LEADER, TRAFFIC ENGINEERING DESIGN DIVISION

ASST. CHIEF TRAFFIC ENGINEERING DESIGN DIVISION

CHIEF, TRAFFIC ENGINEERING DESIGN DIVISION

DIRECTOR, TRAFFIC & SAFETY

MARYLAND DOT - STATE HIGHWAY ADMINISTRATION

Office of Traffic & Safety

TRAFFIC ENGINEERING DESIGN DIVISION

(Traffic Signal Plan)

US 301 at Pierce Road/VFW Road

DRAWN BY:	M. Cook	F.A.P. NO.	N/A	TS NO. 3486 A	SHEET NO.
CHECKED BY:	D. Dodo	S.H.A. NO.	BW996M82		
SCALE:	1" = 20'	COUNTY:	Charles	T.I.M.S. NO.	1 OF 1
DATE:	March, 1995	LOG MILE:	08030125.48		

F:\1997\1997-C92A\ces\cassiu11.dgn 09 JAN 2001