F H WA REGION NO	STATE	FED. AID PROJ. NO	SHEET NO.	TOTAL SHEETS
3	MD.			

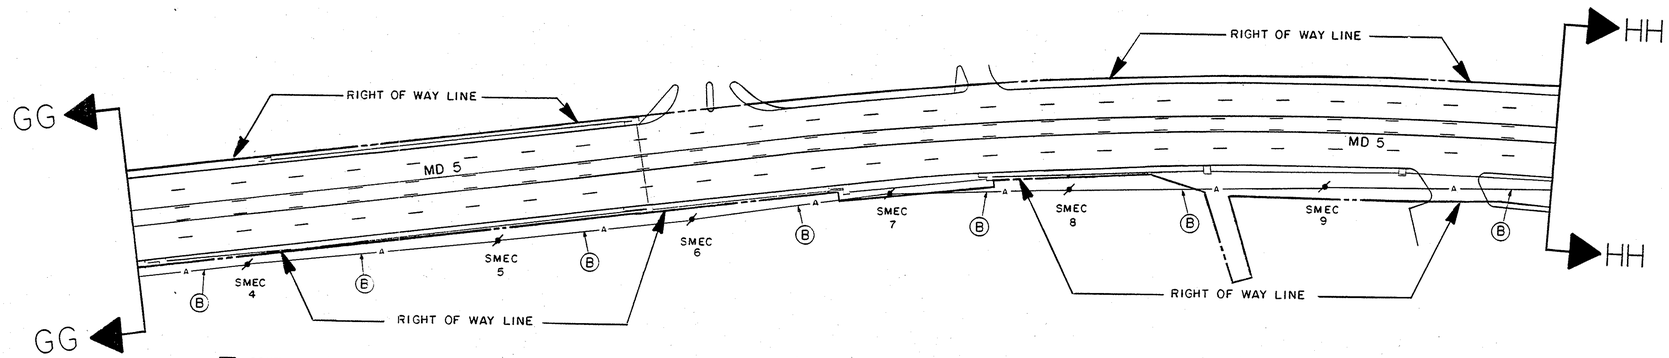

1 CONTRACTOR TO INSTALL INTERCONNECT CABLE IN EXISTING SIGNAL RINGS FROM PIKA DR. (BOTH DIRECTIONS)

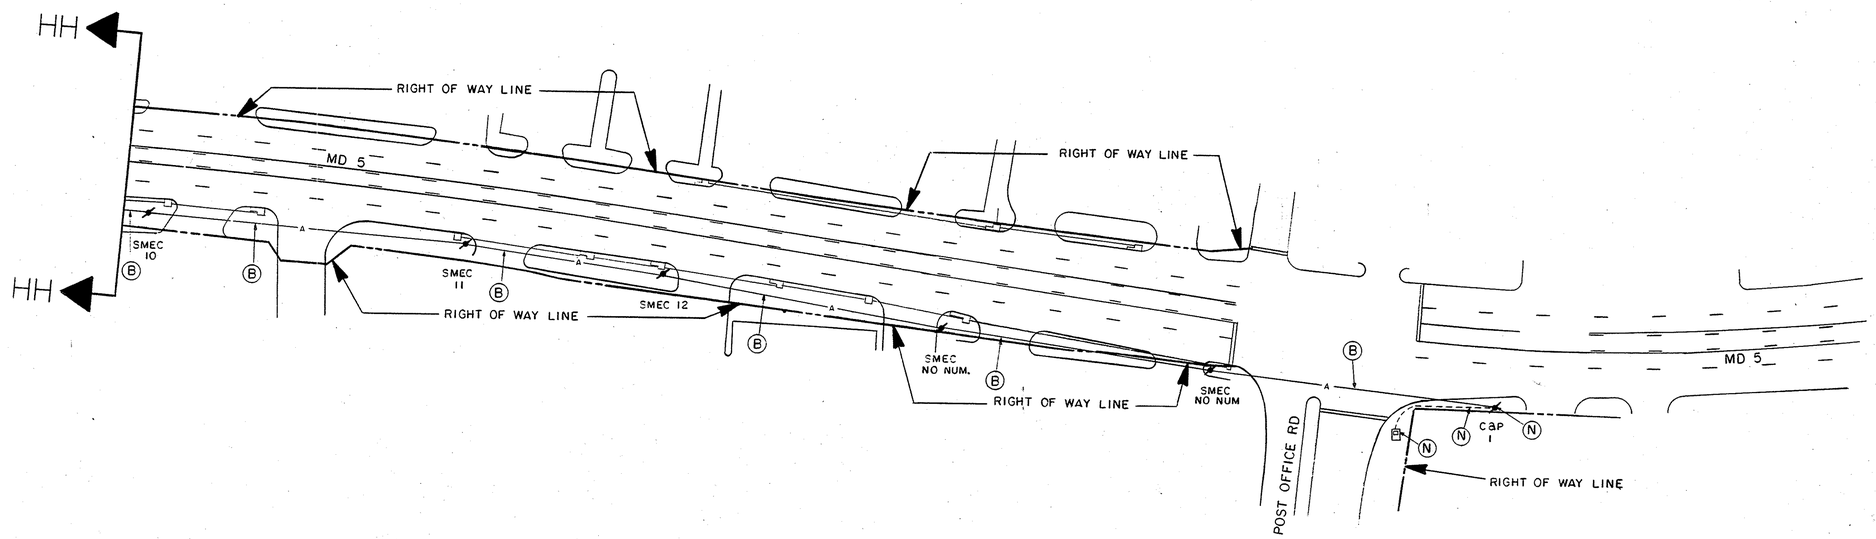

INTERCONNECT PLAN

1 Revision

LEGEND OF UNDERGROUND AND OVERHEAD UTILITIES

AERIAL CABLE	—— A —— A —— A —— A
ELECTRIC	—— E —— E —— E —— E
TELEPHONE	—— T —— T —— T —— T
GAS	—— G —— G —— G —— G
SEWER	—— S —— S —— S —— S
WATER	—— W —— W —— W —— W
CABLE TV	—— TV —— TV —— TV —— TV

STREET TRAFFIC STUDIES, LTD.
Gateway International
1302 Concourse Drive, Suite 104
Linthicum, Maryland 21090
(301) 859-3553

REVISIONS

1 REVISE INTERCONNECT CABLES 11/5/90

APPROVALS

CHIEF, SIGNAL DESIGN SECTION

ASST. DISTRICT ENGINEER, TRAFFIC

CHIEF, TRAFFIC ENGINEERING DIVISION

DEPUTY CHIEF ENGINEER, OFFICE OF TRAFFIC

MARYLAND DEPARTMENT OF TRANSPORTATION
STATE HIGHWAY ADMINISTRATION – OFFICE OF TRAFFIC
TRAFFIC ENGINEERING DIVISION

DRAWN BY B K MILLER (FOR STS)
DES. BY: R R ZACHERL (FOR STS)
CHK. BY: 4/22/90

US 301 AND MD 5 / MD 228
EAST TO POST OFFICE RD

COUNTY: CHARLES

DATE: 12-15-88
SCALE: 1" = 50'
F.A.P. NO.
S.H.A. NO. CH-555-501-570
TS/FILE NO. 2629-IC-21
TS-
SHEET NO. 191 OF 239