F H WA REGION NO	STATE	FED. AID PROJ. NO	SHEET NO.	TOTAL SHEETS
3	MD.			

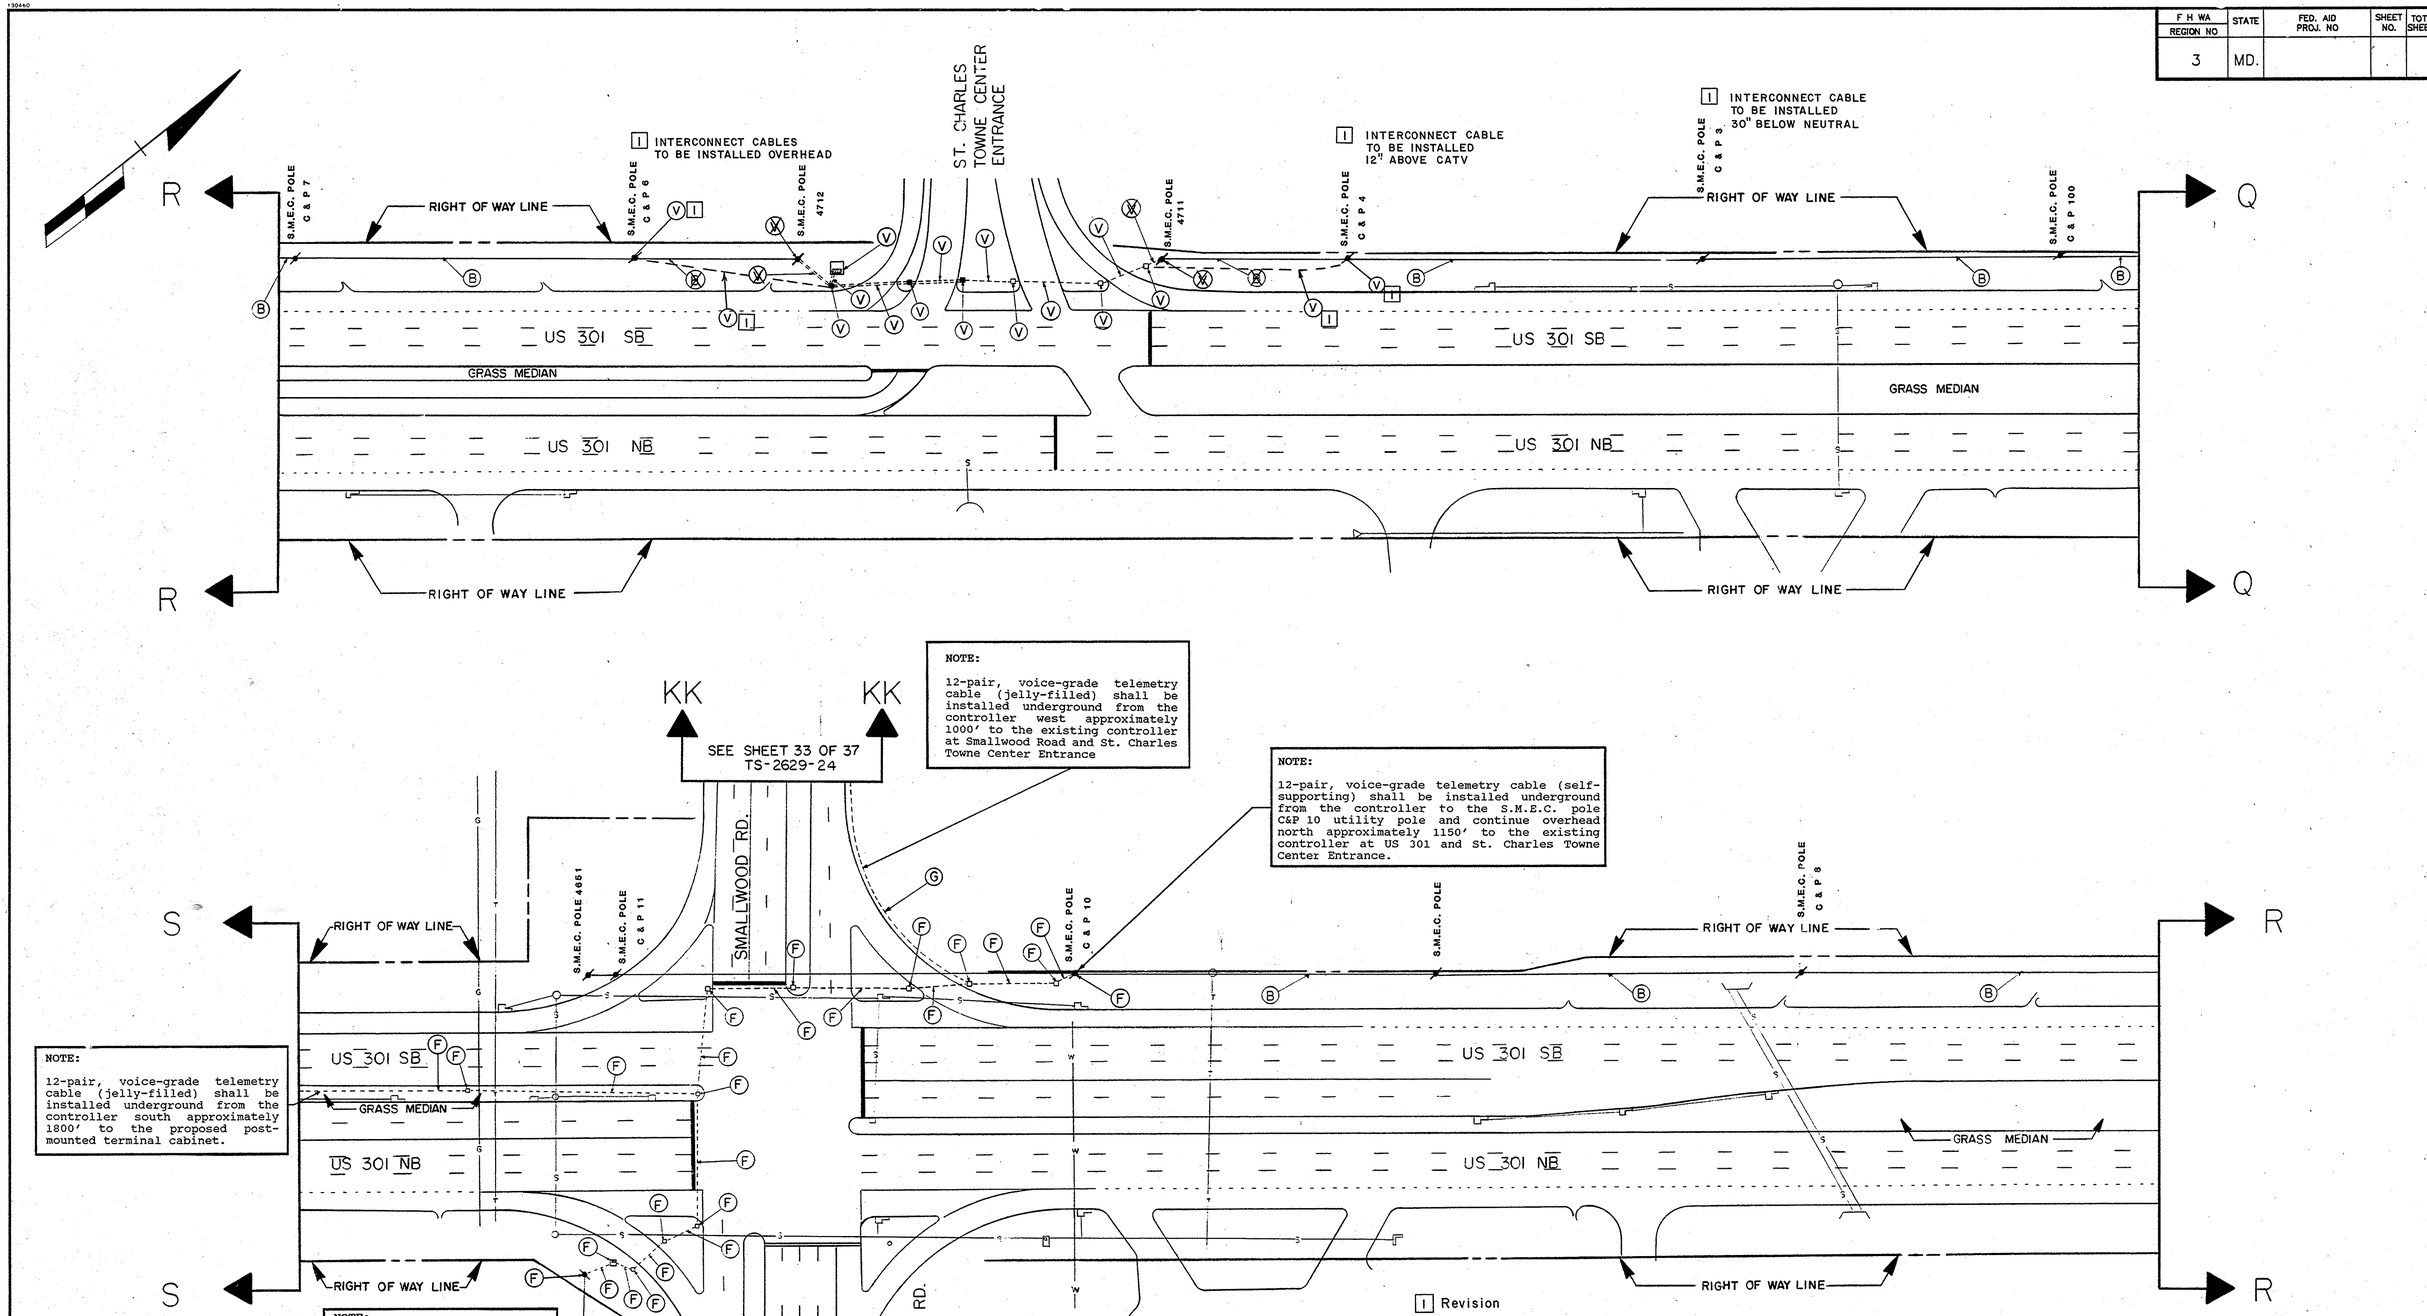

NOTE:

12-pair, voice-grade telemetry cable (jelly-filled) shall be installed underground from the controller west approximately 1000' to the existing controller at Smallwood Road and St. Charles Towne Center Entrance

NOTE:

12-pair, voice-grade telemetry cable (self-supporting) shall be installed underground from the controller to the S.M.E.C. pole C&P 10 utility pole and continue overhead north approximately 1150' to the existing controller at US 301 and St. Charles Towne Center Entrance.

NOTE:

12-pair, voice-grade telemetry cable (jelly-filled) shall be installed underground from the controller south approximately 1800' to the proposed post-mounted terminal cabinet.

NOTE:

12-pair, voice-grade telemetry cable (self-supporting) shall be installed overhead from the controller east approximately 1000' to the existing controller at Smallwood Road and MD 925.

1 Revision

LEGEND OF UNDERGROUND AND OVERHEAD UTILITIES

AERIAL CABLE — A — A — A — A
ELECTRIC — E — E — E — E
TELEPHONE — T — T — T — T
GAS — G — G — G — G
SEWER — S — S — S — S
WATER — W — W — W — W
CABLE TV — TV — TV — TV — TV

STREET TRAFFIC STUDIES, LTD.
Gateway International
1302 Concourse Drive, Suite 104
Linthicum, Maryland 21090
(301) 859-3553

REVISIONS	APPROVALS
	CHIEF, SIGNAL DESIGN SECTION
	ASST. DISTRICT ENGINEER, TRAFFIC
	CHIEF, TRAFFIC ENGINEERING DIVISION
1 REVISE INTERCONNECT CABLE 11/5/90	DEPUTY CHIEF ENGINEER, OFFICE OF TRAFFIC

MARYLAND DEPARTMENT OF TRANSPORTATION
STATE HIGHWAY ADMINISTRATION – OFFICE OF TRAFFIC
TRAFFIC ENGINEERING DIVISION

DRAWN BY B.K. MILLER (FOR STS)
DES. BY: R.R. ZACHERL (FOR STS)
CHK. BY: Emm 4/12/90

US 301 INTERCONNECT SYSTEM FROM CEDARVILLE RD SOUTH TO MD 227

COUNTY: CHARLES

DATE: 12-8-88
SCALE: 1"= 50'
F.A.P. NO.
S.H.A. NO. CH-555-501-570
TS/FILE NO. TS-2629-IC-11
SHEET NO. 181 OF 239