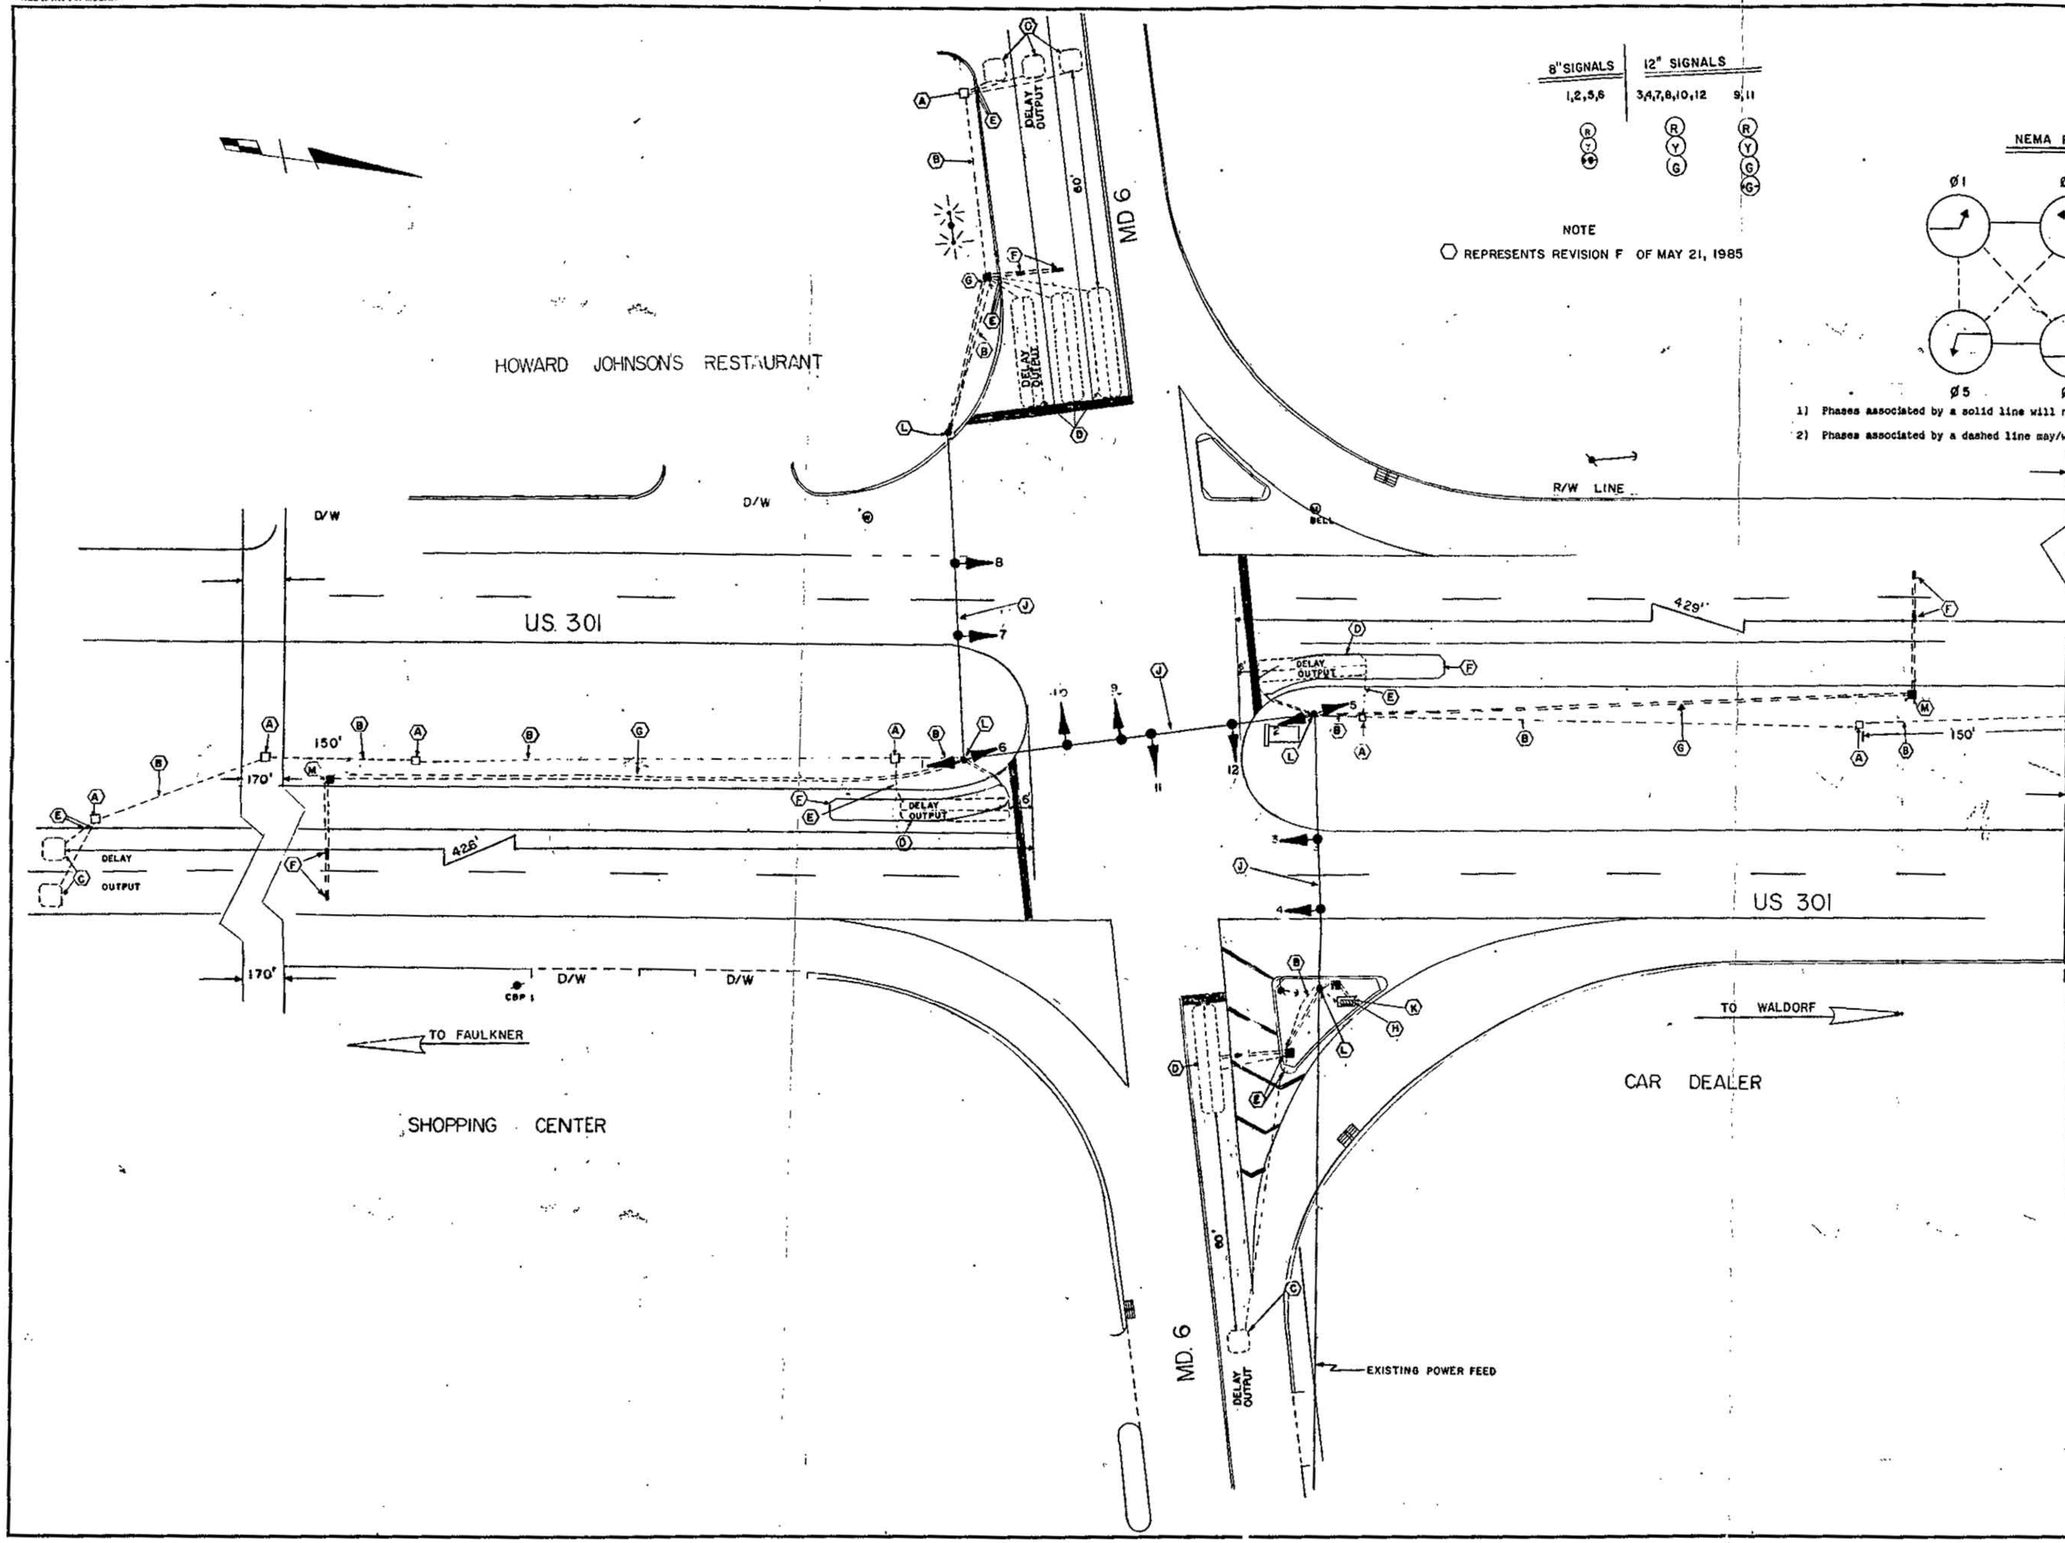

F.H.W.A. REGION NO.	STATE	FED. AID PROJ. NO.	SHEET NO.	TOTAL SHEETS
3	MD.			

APPROVAL: CHIEF SIGNAL DESIGN SECTION	F MAY 21, 1985 NEW GEOMETRICS, ADDED LOOP DETECTOR S.H.A. No. 855-25003 D.L.A.
APPROVAL: REGIONAL TRAFFIC ENGINEER	E 6/20/84 ADDED LOOP DETECTORS. 855-25003 DA
APPROVAL: CHIEF-BUREAU OF TRAFFIC ENGINEERING	D REDRAWN 9-20-82 JH
APPROVAL: ASS'T. CHIEF ENGINEER TRAFFIC	C ASBUILT 8-3-73 PM
	B ADDED INDIC. ON SIGNAL NO 10 & 11 12-26-72 BCP
	A ASBUILT 10-2-72
	REVISIONS

STATE OF MARYLAND
DEPARTMENT OF TRANSPORTATION
STATE HIGHWAY ADMINISTRATION

TRAFFIC DIVISION – BUREAU OF TRAFFIC ENGINEERING

US 301 & MD 6

SCALE 1"=20' DATE 9-20-82 CONTRACT NO. CH-447X-575

DRAWN BY: J HOYAS WFF COUNTY: CHARLES

DESIGNED BY: DAVE ANDREWS SIGNAL NO.: 08005

CHECKED BY:

DRAWING NO. TS-82 F

08000625.35
08030114.99