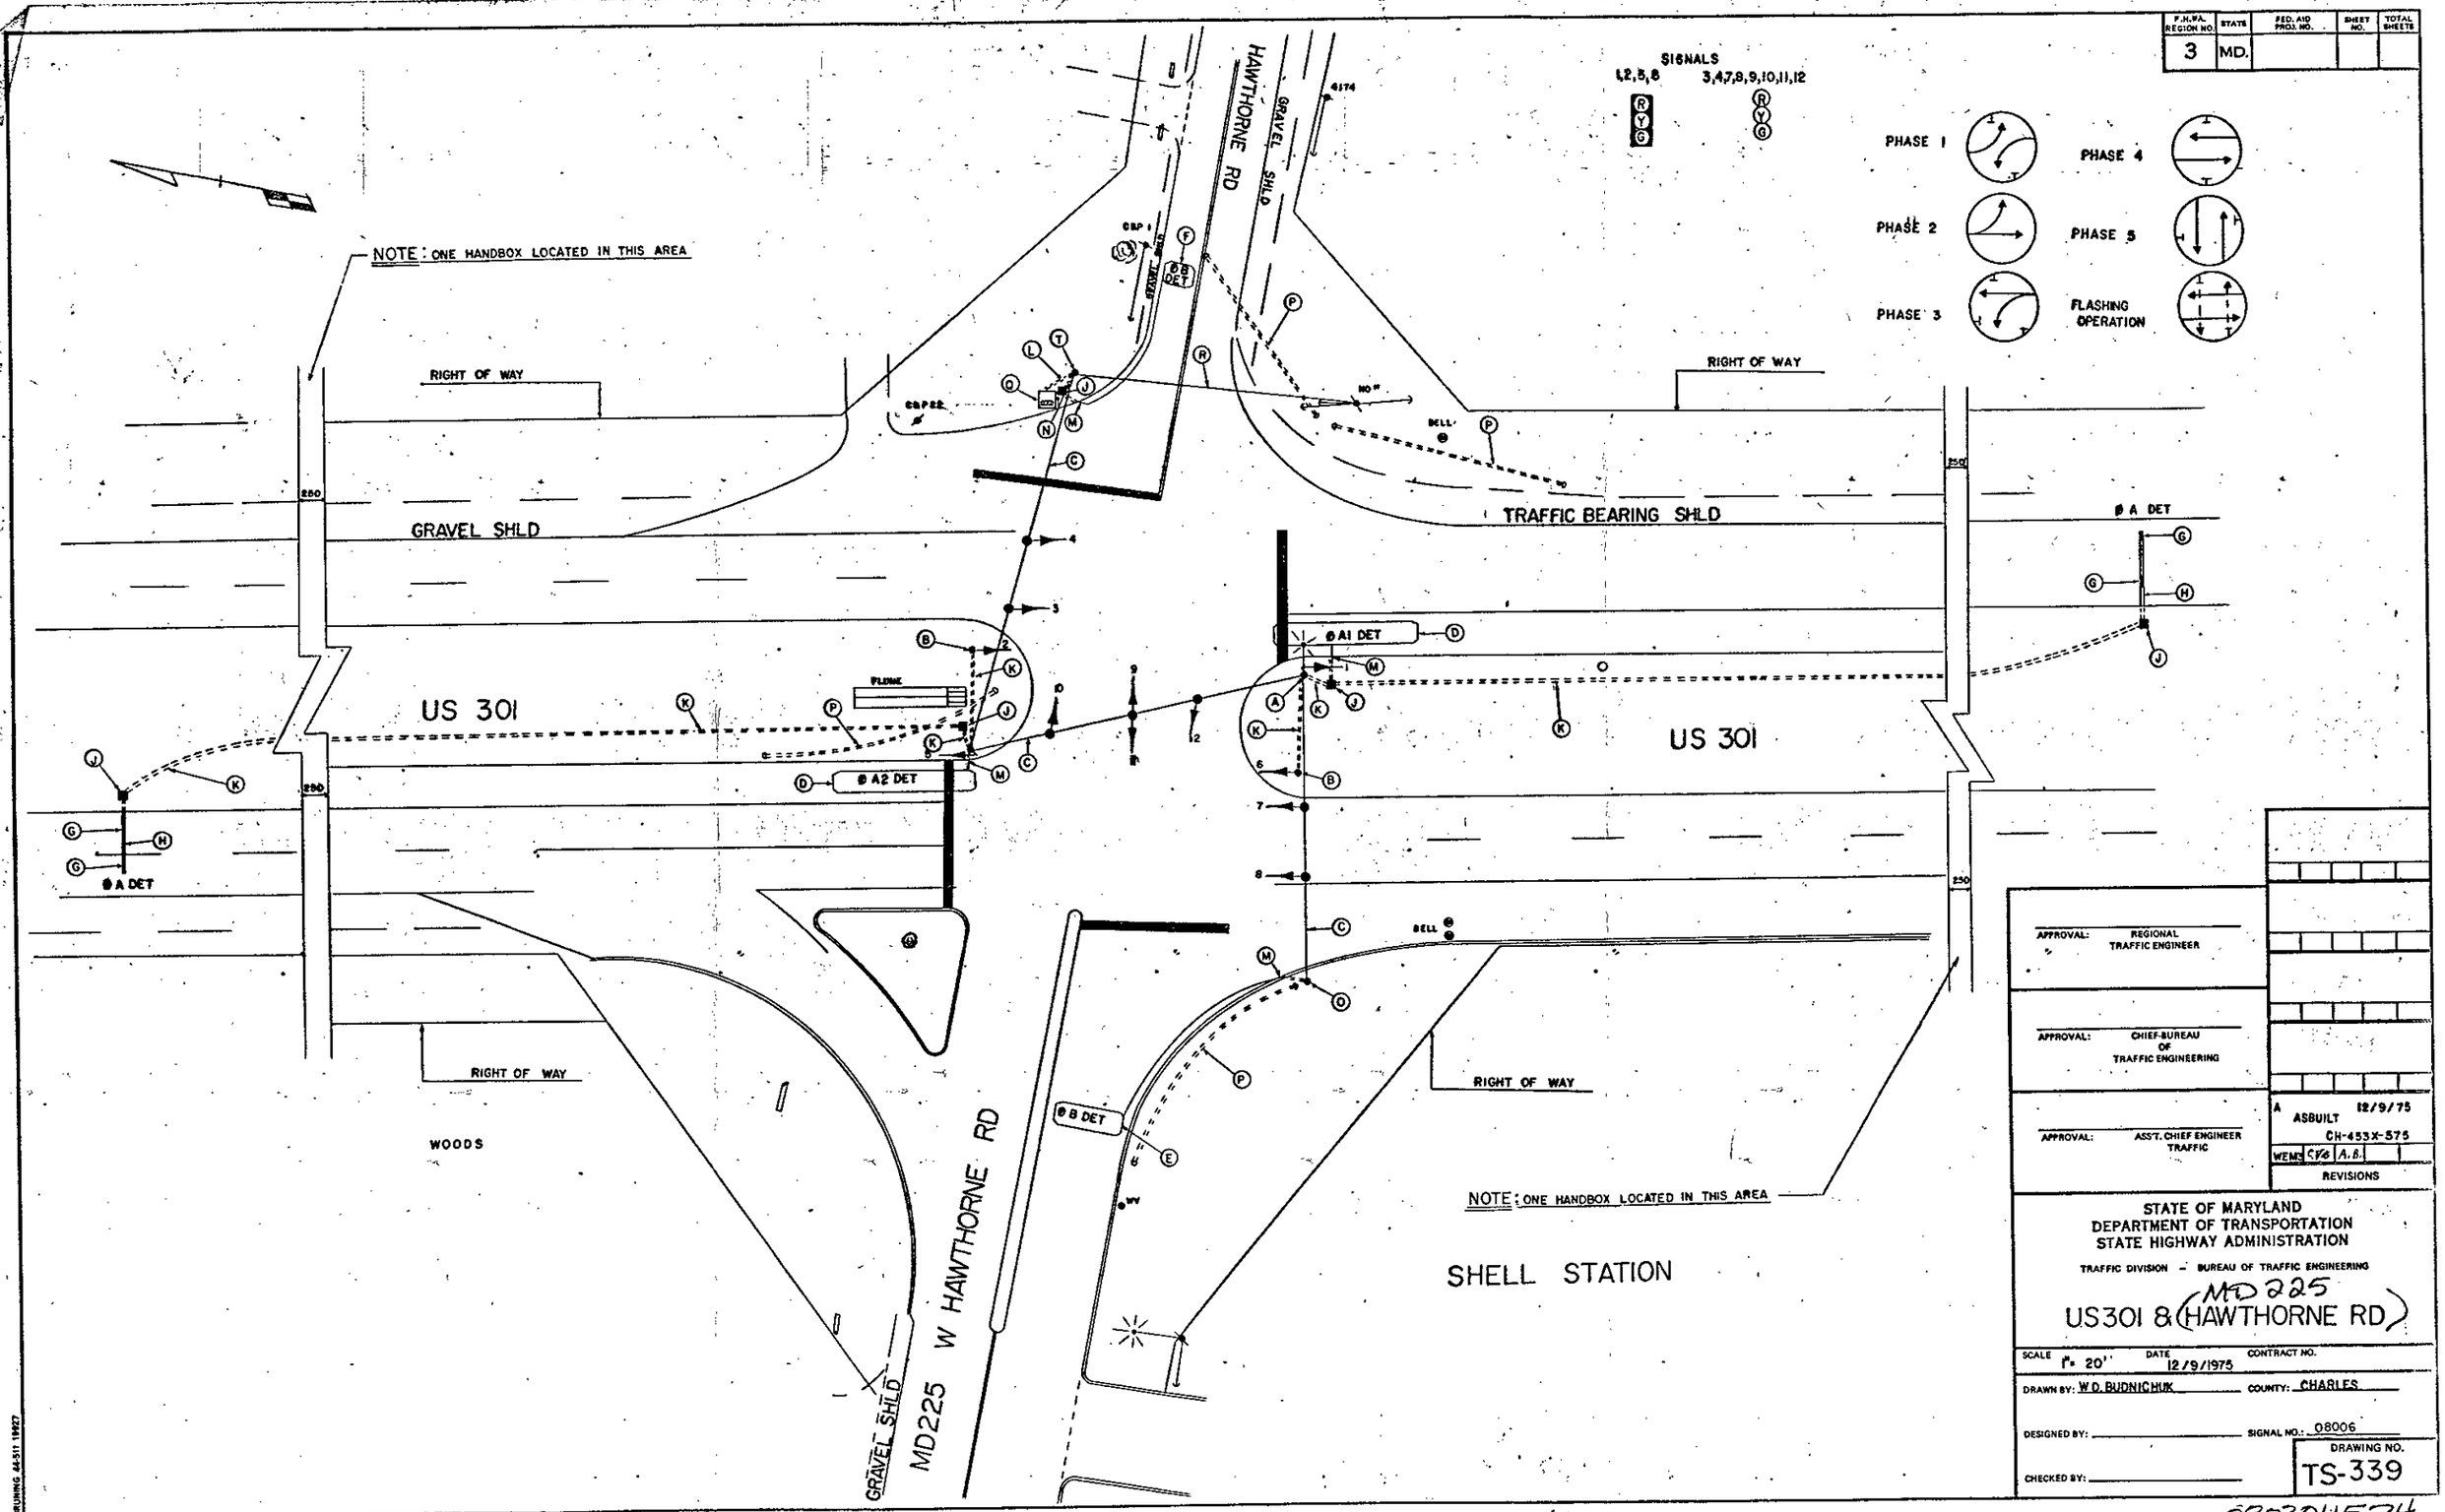

F.H.W.A. REGION NO. 3
STATE MD.
FED. AID PROJ. NO.
SHEET NO.
TOTAL SHEETS
SIGNALS
1,2,5,8
3,4,7,8,9,10,11,12
PHASE 1
PHASE 2
PHASE 3
PHASE 4
PHASE 5
FLASHING OPERATION
NOTE: ONE HANDBOX LOCATED IN THIS AREA
RIGHT OF WAY
GRAVEL SHLD
HAWTHORNE RD
TRAFFIC BEARING SHLD
US 301
Ø A DET
Ø A1 DET
Ø A2 DET
Ø B DET
FLUME
BELL
WOODS
MD225 W HAWTHORNE RD
SHELL STATION
APPROVAL: REGIONAL TRAFFIC ENGINEER
APPROVAL: CHIEF-BUREAU OF TRAFFIC ENGINEERING
APPROVAL: ASS'T. CHIEF ENGINEER TRAFFIC
A ASBUILT 12/9/75
CH-453X-575
WEMS CVG A.B.
REVISIONS
STATE OF MARYLAND
DEPARTMENT OF TRANSPORTATION
STATE HIGHWAY ADMINISTRATION
TRAFFIC DIVISION - BUREAU OF TRAFFIC ENGINEERING
US301 & (MD 225 HAWTHORNE RD)
SCALE 1" = 20'
DATE 12/9/1975
CONTRACT NO.
DRAWN BY: W.D. BUDNICHUK
COUNTY: CHARLES
DESIGNED BY:
SIGNAL NO.: 08006
CHECKED BY:
DRAWING NO. TS-339

- 08030115.74