F H WA REGION NO	STATE	FED. AID PROJ. NO	SHEET NO.	TOTAL SHEETS
3	MD.			

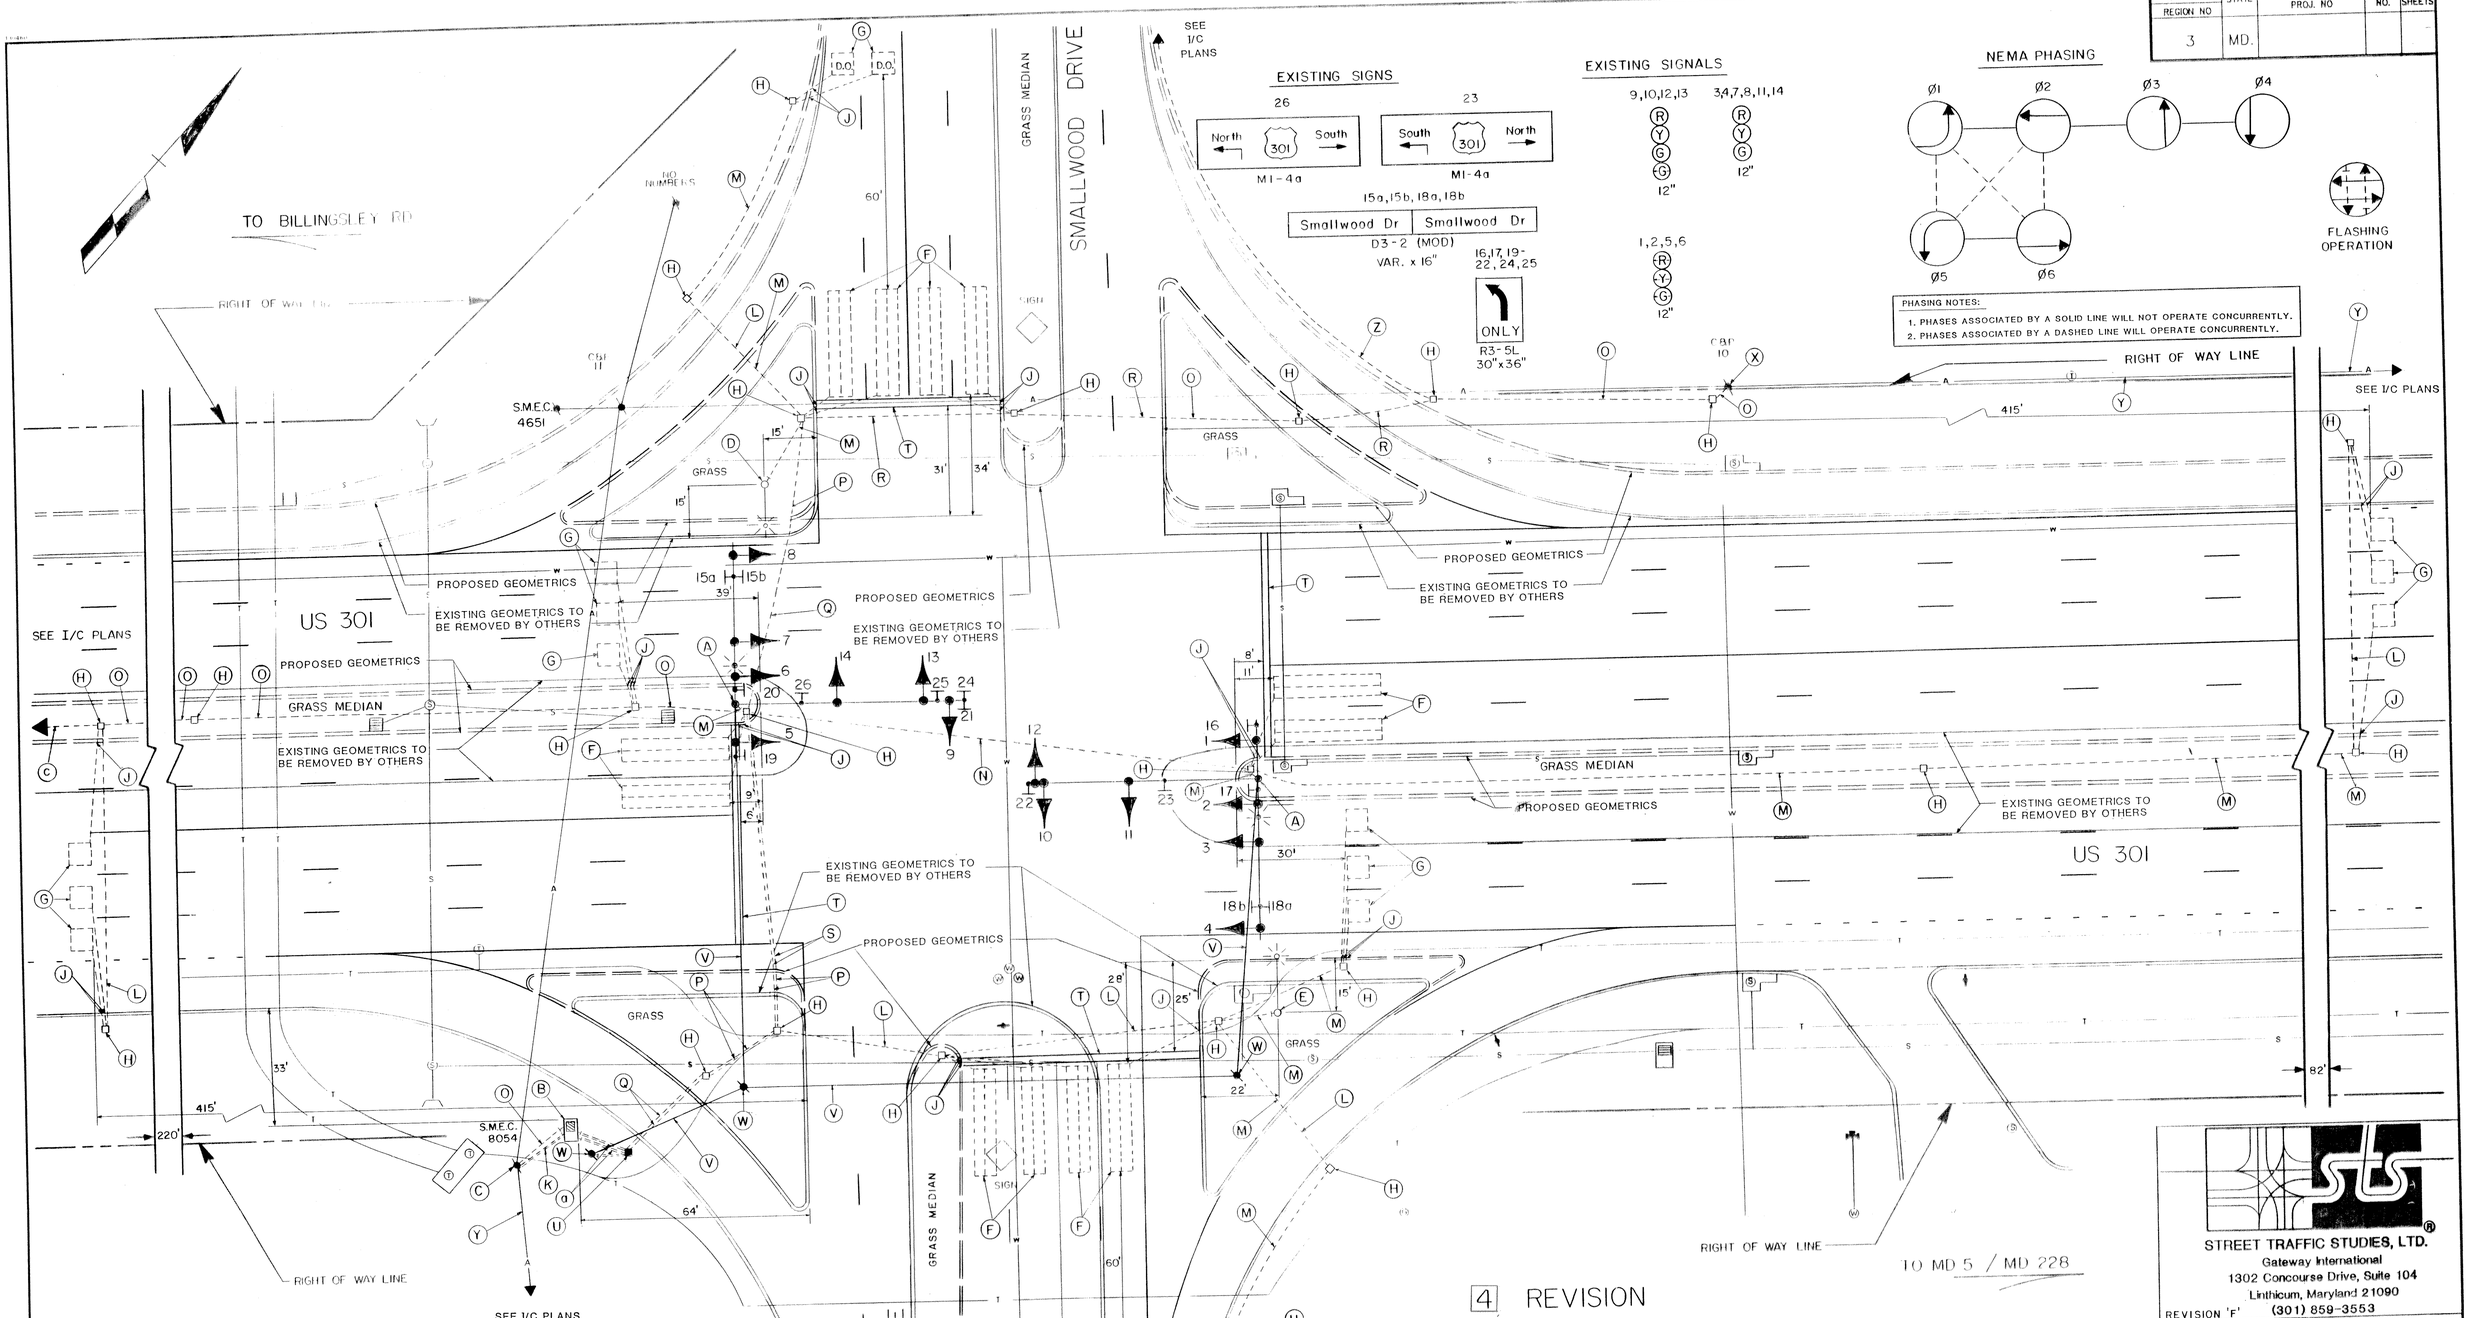

STREET TRAFFIC STUDIES, LTD.
Gateway International
1302 Concourse Drive, Suite 104
Linthicum, Maryland 21090
(301) 859-3553
REVISION 'F'

LEGEND OF UNDERGROUND AND OVERHEAD UTILITIES

AERIAL CABLE — A — A — A — A
ELECTRIC — E — E — E — E
TELEPHONE — T — T — T — T
GAS — G — G — G — G
SEWER — S — S — S — S
WATER — W — W — W — W
CABLE TV — TV — TV — TV — TV

GENERAL NOTES:

1. Pavement markings detailed are proposed and are to be installed by the Contractor in accordance with S..H.A. standards.
2. "D.O." indicates a delay-output loop detector.
3. The loop detectors and conduit are to be installed prior to the installation of pavement markings.
4. The contractor must verify the location of proposed geometrics prior to the installation of the signal equipment.
5. This is a revision to the traffic signal installed in 1978 under Contract #AW-705-451-085.

REVISIONS	APPROVALS
4 1-24-89 REBUILDING SIGNAL DUE TO GEOMETRIC CHANGES. SHA NO. CH-555-501-570 RRZ	CHIEF, SIGNAL DESIGN SECTION ASST. DISTRICT ENGINEER, TRAFFIC CHIEF, BUREAU OF TRAFFIC ENGINEERING DEPUTY CHIEF ENGINEER, OFFICE OF TRAFFIC ORIGINAL ON FILE

MARYLAND DEPARTMENT OF TRANSPORTATION
STATE HIGHWAY ADMINISTRATION – OFFICE OF TRAFFIC
BUREAU OF TRAFFIC ENGINEERING

DRAWN BY
DES. BY:
CHK. BY: A.E.M.
DATE: 5-3-78
SCALE: 1" = 20'
F.A.P. NO.
S.H.A. NO. AW-705-451-085

US 301 AND SMALLWOOD DRIVE

COUNTY: CHARLES

TS/FILE NO. TS-1650#G

SHEET NO. 9 OF 37

FH 22

08030122.25