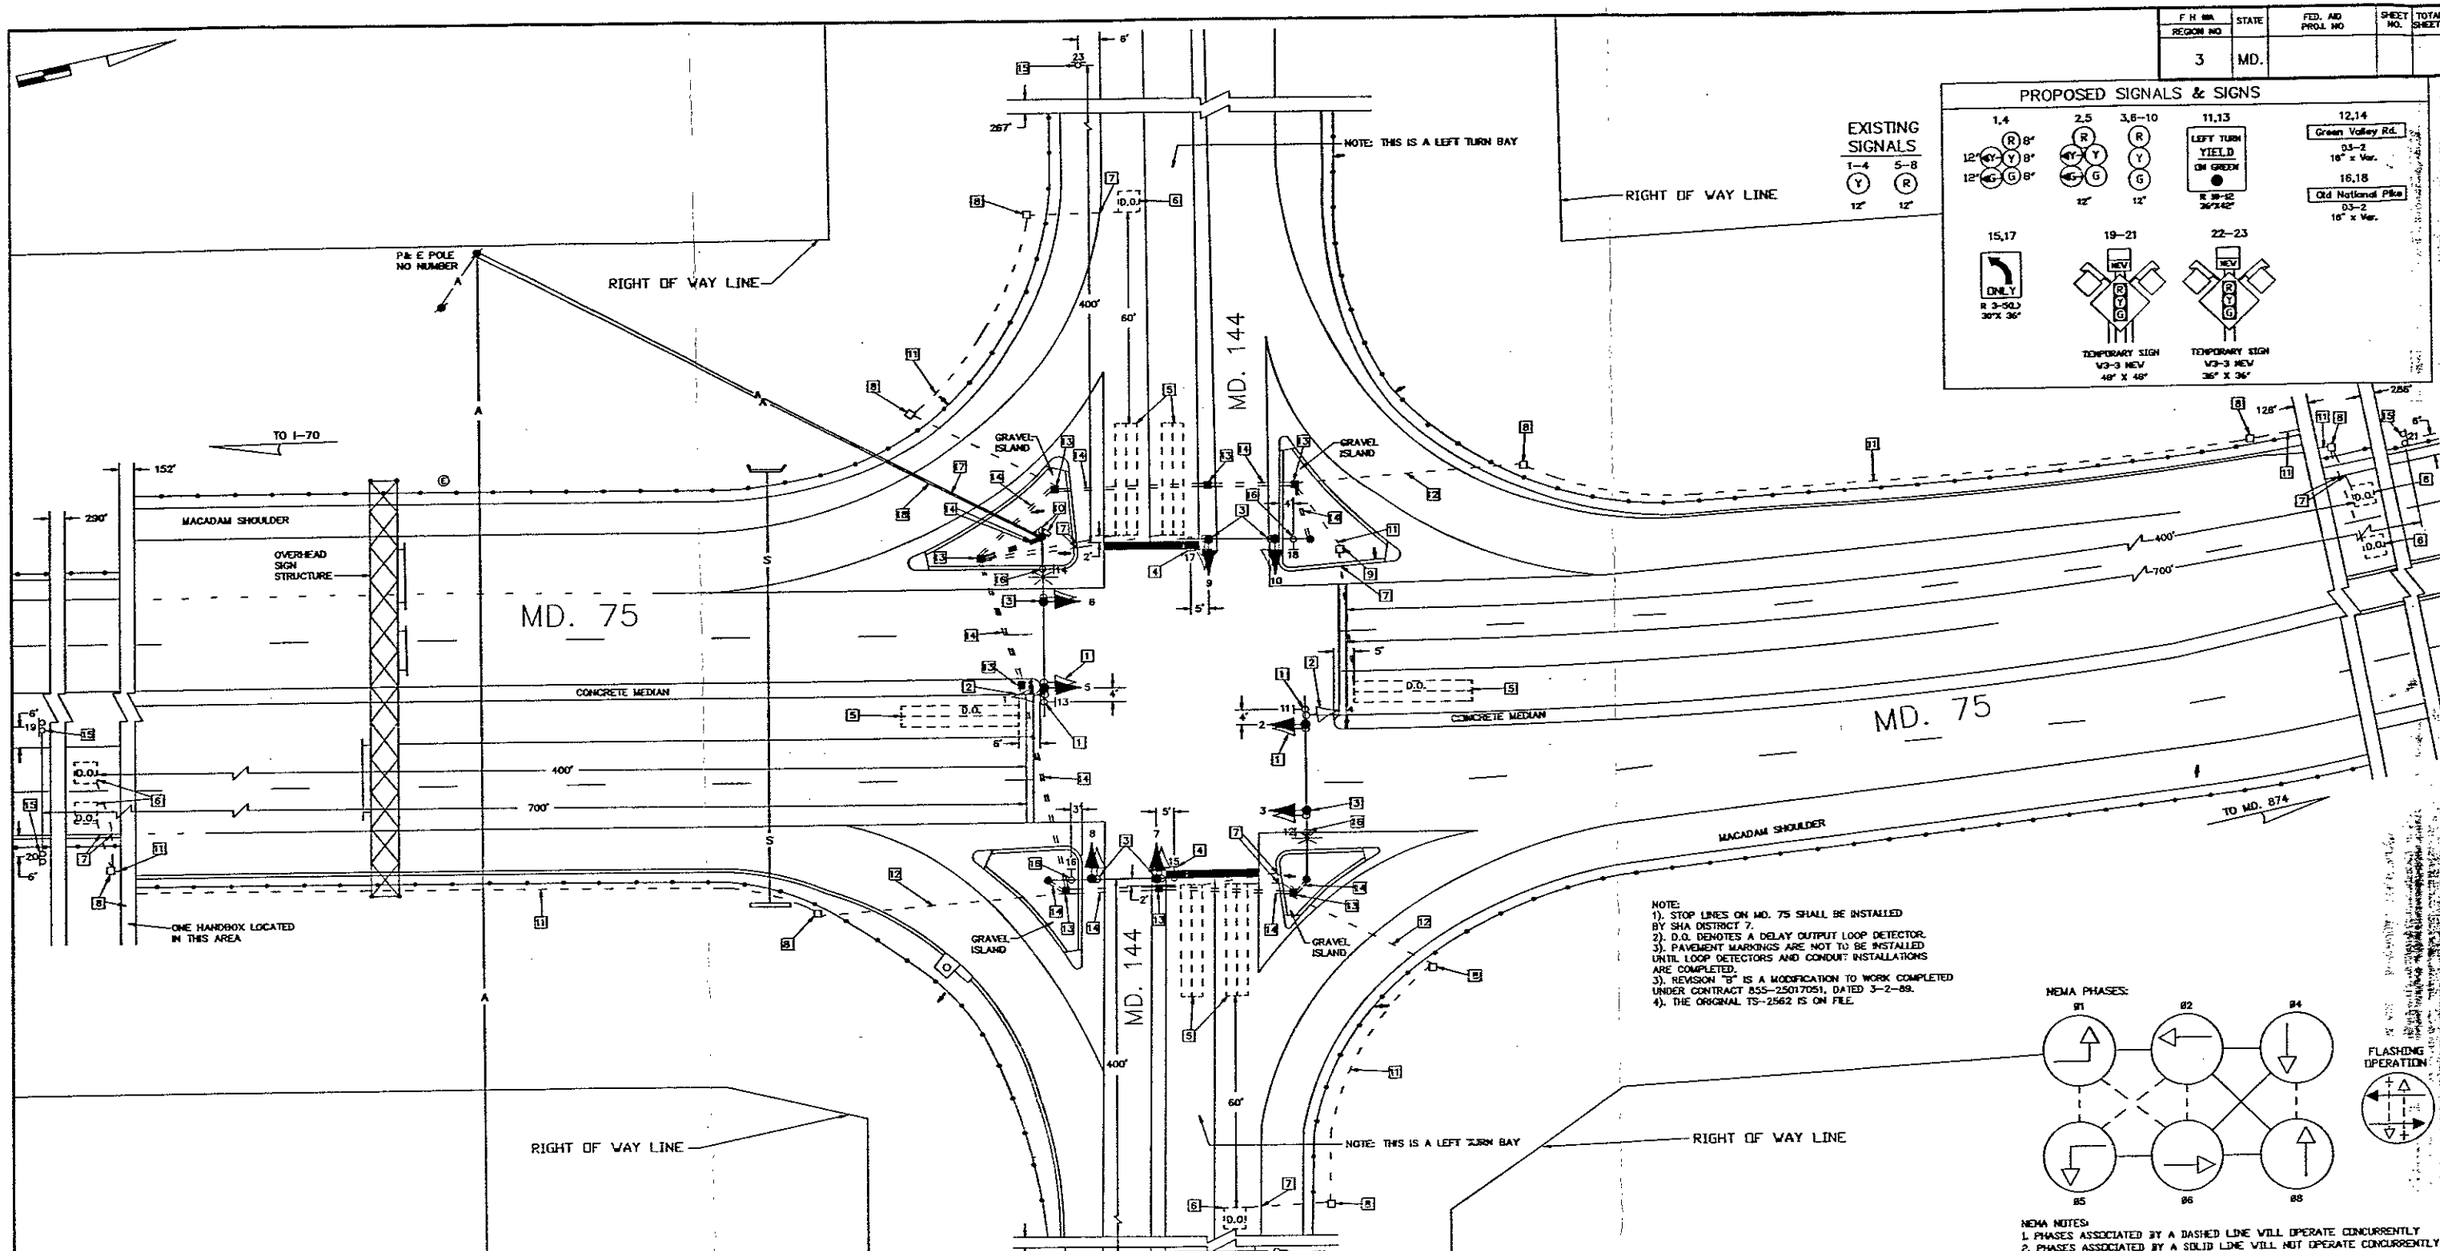

F H WA REGION NO 3
STATE MD.
FED. AID PROJ. NO
SHEET NO.
TOTAL SHEETS
PROPOSED SIGNALS & SIGNS
EXISTING SIGNALS
1-4 5-8
12" 12"
1,4
2,5
3,6-10
11,13
LEFT TURN YIELD ON GREEN
R 10-12 36"X42"
12,14
Green Valley Rd.
03-2 16" x Ver.
16,18
Old National Pike
03-2 16" x Ver.
15,17
ONLY
R 3-5(L) 30"X 36"
19-21
22-23
TEMPORARY SIGN W3-3 NEW 48" X 48"
TEMPORARY SIGN W3-3 NEW 36" X 36"
NOTE: THIS IS A LEFT TURN BAY
RIGHT OF WAY LINE
P& E POLE NO NUMBER
TO I-70
MACADAM SHOULDER
OVERHEAD SIGN STRUCTURE
MD. 75
MD. 144
GRAVEL ISLAND
CONCRETE MEDIAN
ONE HANDBOX LOCATED IN THIS AREA
TO MD. 874
NOTE:
1). STOP LINES ON MD. 75 SHALL BE INSTALLED BY SHA DISTRICT 7.
2). D.O. DENOTES A DELAY OUTPUT LOOP DETECTOR.
3). PAVEMENT MARKINGS ARE NOT TO BE INSTALLED UNTIL LOOP DETECTORS AND CONDUIT INSTALLATIONS ARE COMPLETED.
3). REVISION "B" IS A MODIFICATION TO WORK COMPLETED UNDER CONTRACT 855-25017051, DATED 3-2-89.
4). THE ORIGINAL TS-2562 IS ON FILE.
NEMA PHASES:
FLASHING OPERATION
NEMA NOTES:
1. PHASES ASSOCIATED BY A DASHED LINE WILL OPERATE CONCURRENTLY
2. PHASES ASSOCIATED BY A SOLID LINE WILL NOT OPERATE CONCURRENTLY
UTILITY LEGEND
GAS MAIN
WATER MAIN
SEWER MAIN
ELECTRIC CABLES
AERIAL CABLES
TELEPHONE CABLES
REVISIONS
A. 07/91 AS BUILT
B. 07/91 - UPGRADE TO FULL SIGNAL & E/P LT MD. 75 S.H.A.
APPROVALS
NOTE: THIS IS A REVISION TO 855-25017051 DATED 3-2-89 ORIGINAL PLAN ON FILE
DEPUTY CHIEF ENGINEER, OFFICE OF TRAFFIC
MDOT - STATE HIGHWAY ADMINISTRATION
Office of Traffic
TRAFFIC ENGINEERING DIVISION
SIGNAL # 10007508.35
DRAWN BY: B. K. MILLER (for STS)
DES. BY: R. R. ZACHERL (for STS)
CHK. BY: D. J. DODA 6-8-89
MD. 75 & MD. 144
COUNTY: FREDERICK
DATE: 3-2-89
SCALE: 1" = 20'
F.A.P. NO.
S.H.A. NO. 855-25017051
TS/STD. NO. TS-2562 B
SHEET NO. 1 OF 1