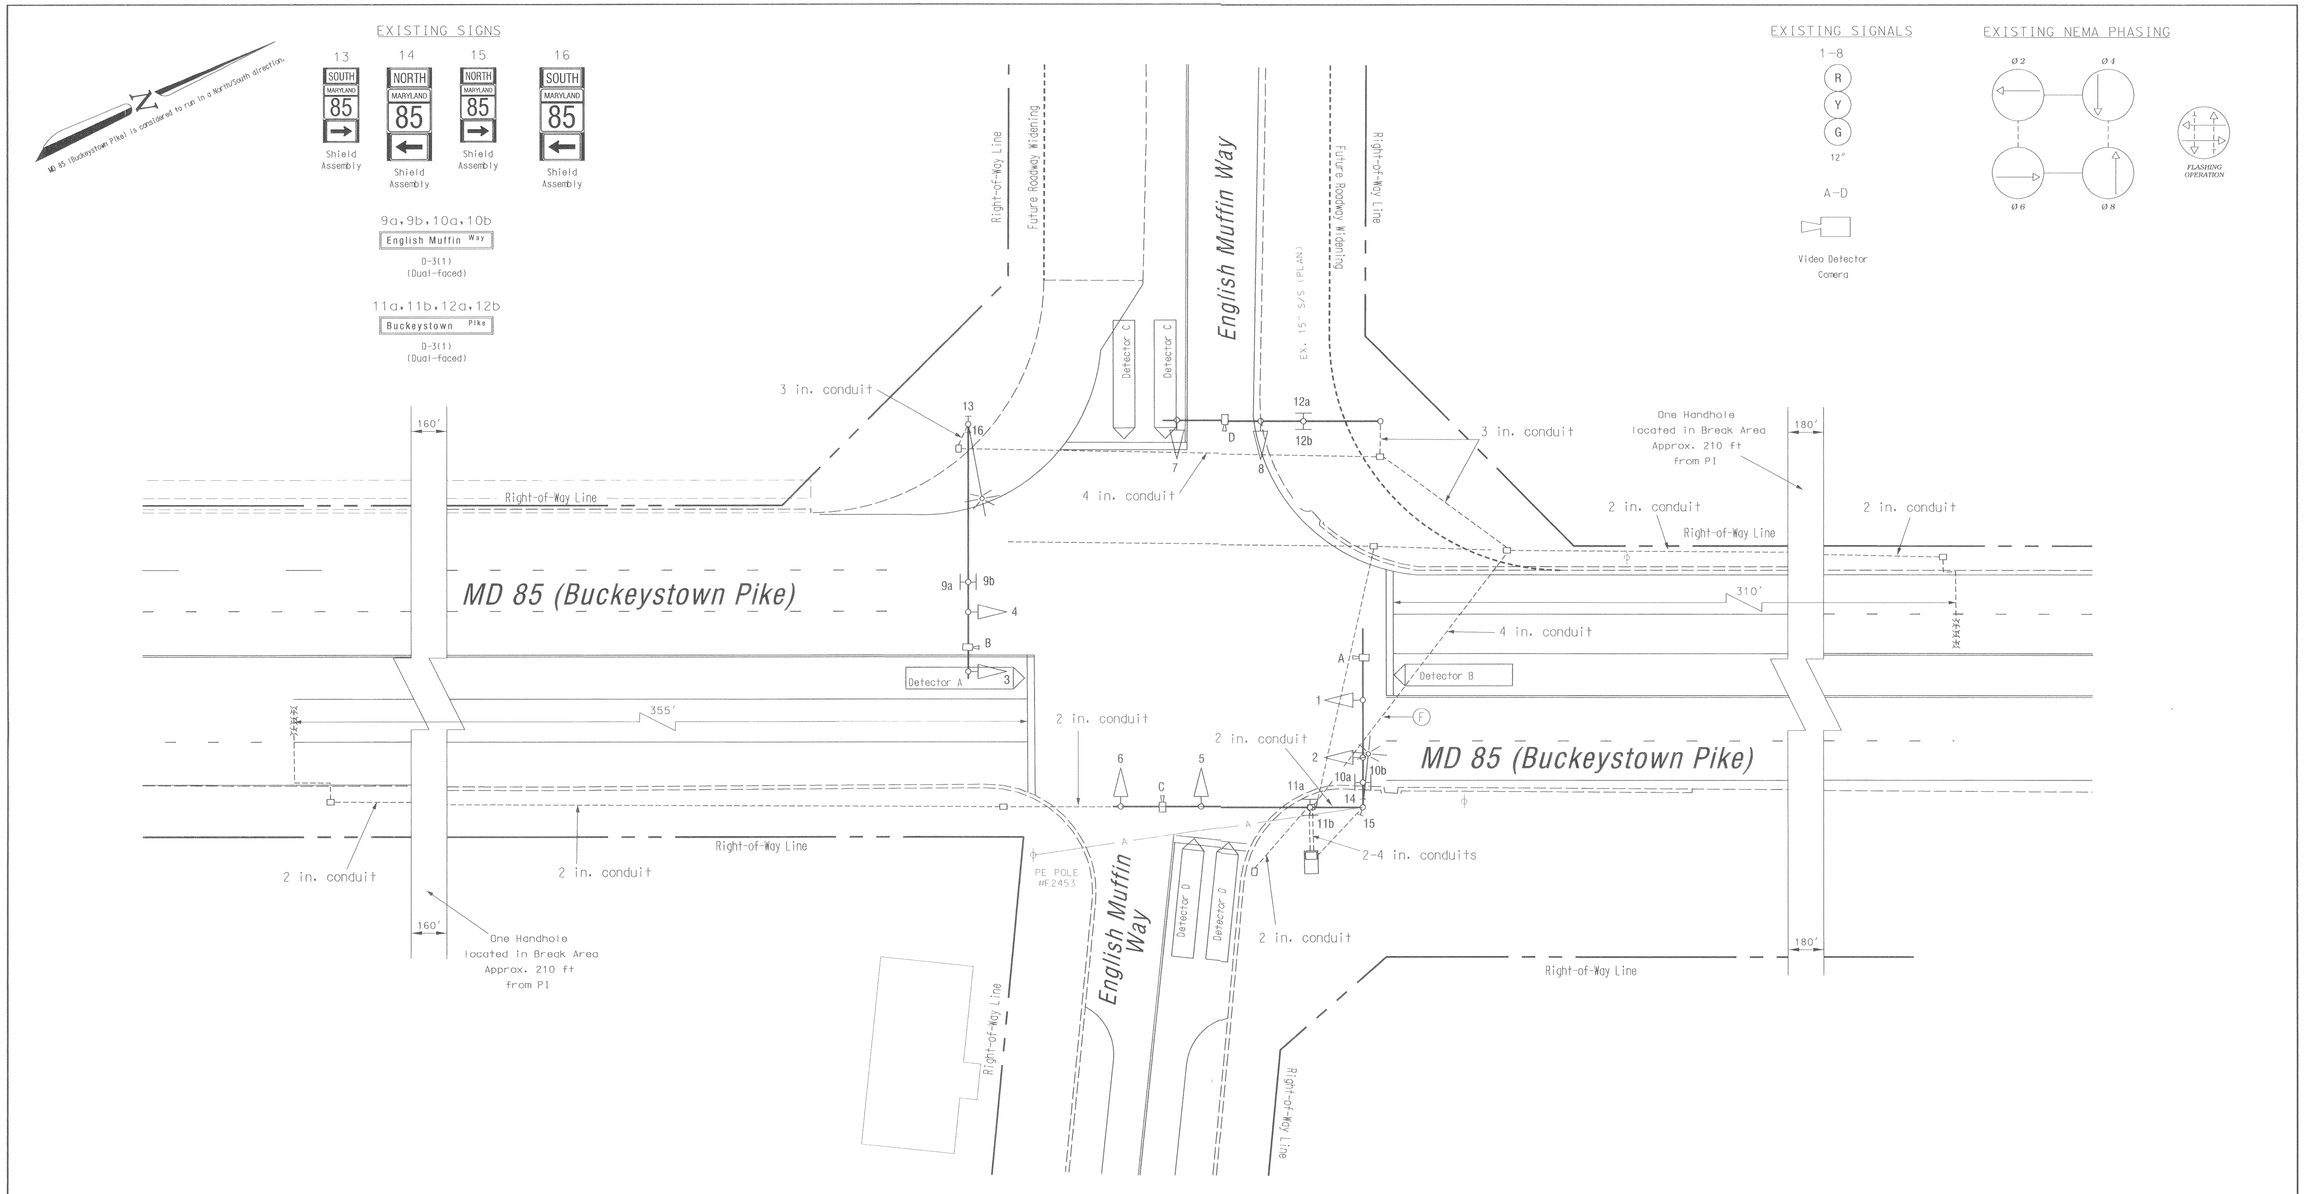

GEOMETRIC LEGEND

EXISTING GEOMETRICS

PROPOSED GEOMETRICS

UTILITY LEGEND

G	GAS MAIN
W	WATER MAIN
S	SEWER MAIN
E	ELECTRIC CABLES
D	STORM DRAIN
A	AERIAL CABLES
T	TELEPHONE CABLES

"As-Built"

The Traffic Group

The Traffic Group, Inc.
410-931-6600
Fax 410-931-6601

REVISIONS

August 24, 2005
As-Built
S.H.A. No.:BW996M82
jjd

August 2, 2004
A
Traffic Signal Modification
S.H.A. No.:BW996M82
FDB

APPROVALS

TEAM LEADER, TRAFFIC ENGINEERING DESIGN DIVISION

ASST. CHIEF TRAFFIC ENGINEERING DESIGN DIVISION

CHIEF, TRAFFIC ENGINEERING DESIGN DIVISION

DIRECTOR, TRAFFIC & SAFETY

ORIGINAL ON FILE

MARYLAND DOT - STATE HIGHWAY ADMINISTRATION

Office of Traffic & Safety

TRAFFIC ENGINEERING DESIGN DIVISION

(Traffic Signal Plan)

MD 85 (Buckeystown Pike) at English Muffin Way

DRAWN BY:	T. Zaydel	F.A.P. NO.	N/A	TS NO. 3664-A	SHEET NO.
CHECKED BY:	Name	S.H.A. NO.	AW105H5B		
SCALE:	1" = 20'	COUNTY:	Frederick	T.I.M.S. NO. F-151	1 OF 2
DATE:	June 9, 1997	LOG MILE:	-		

f:\2001\2001-0306\Des\as-built.dgn 08/29/2005