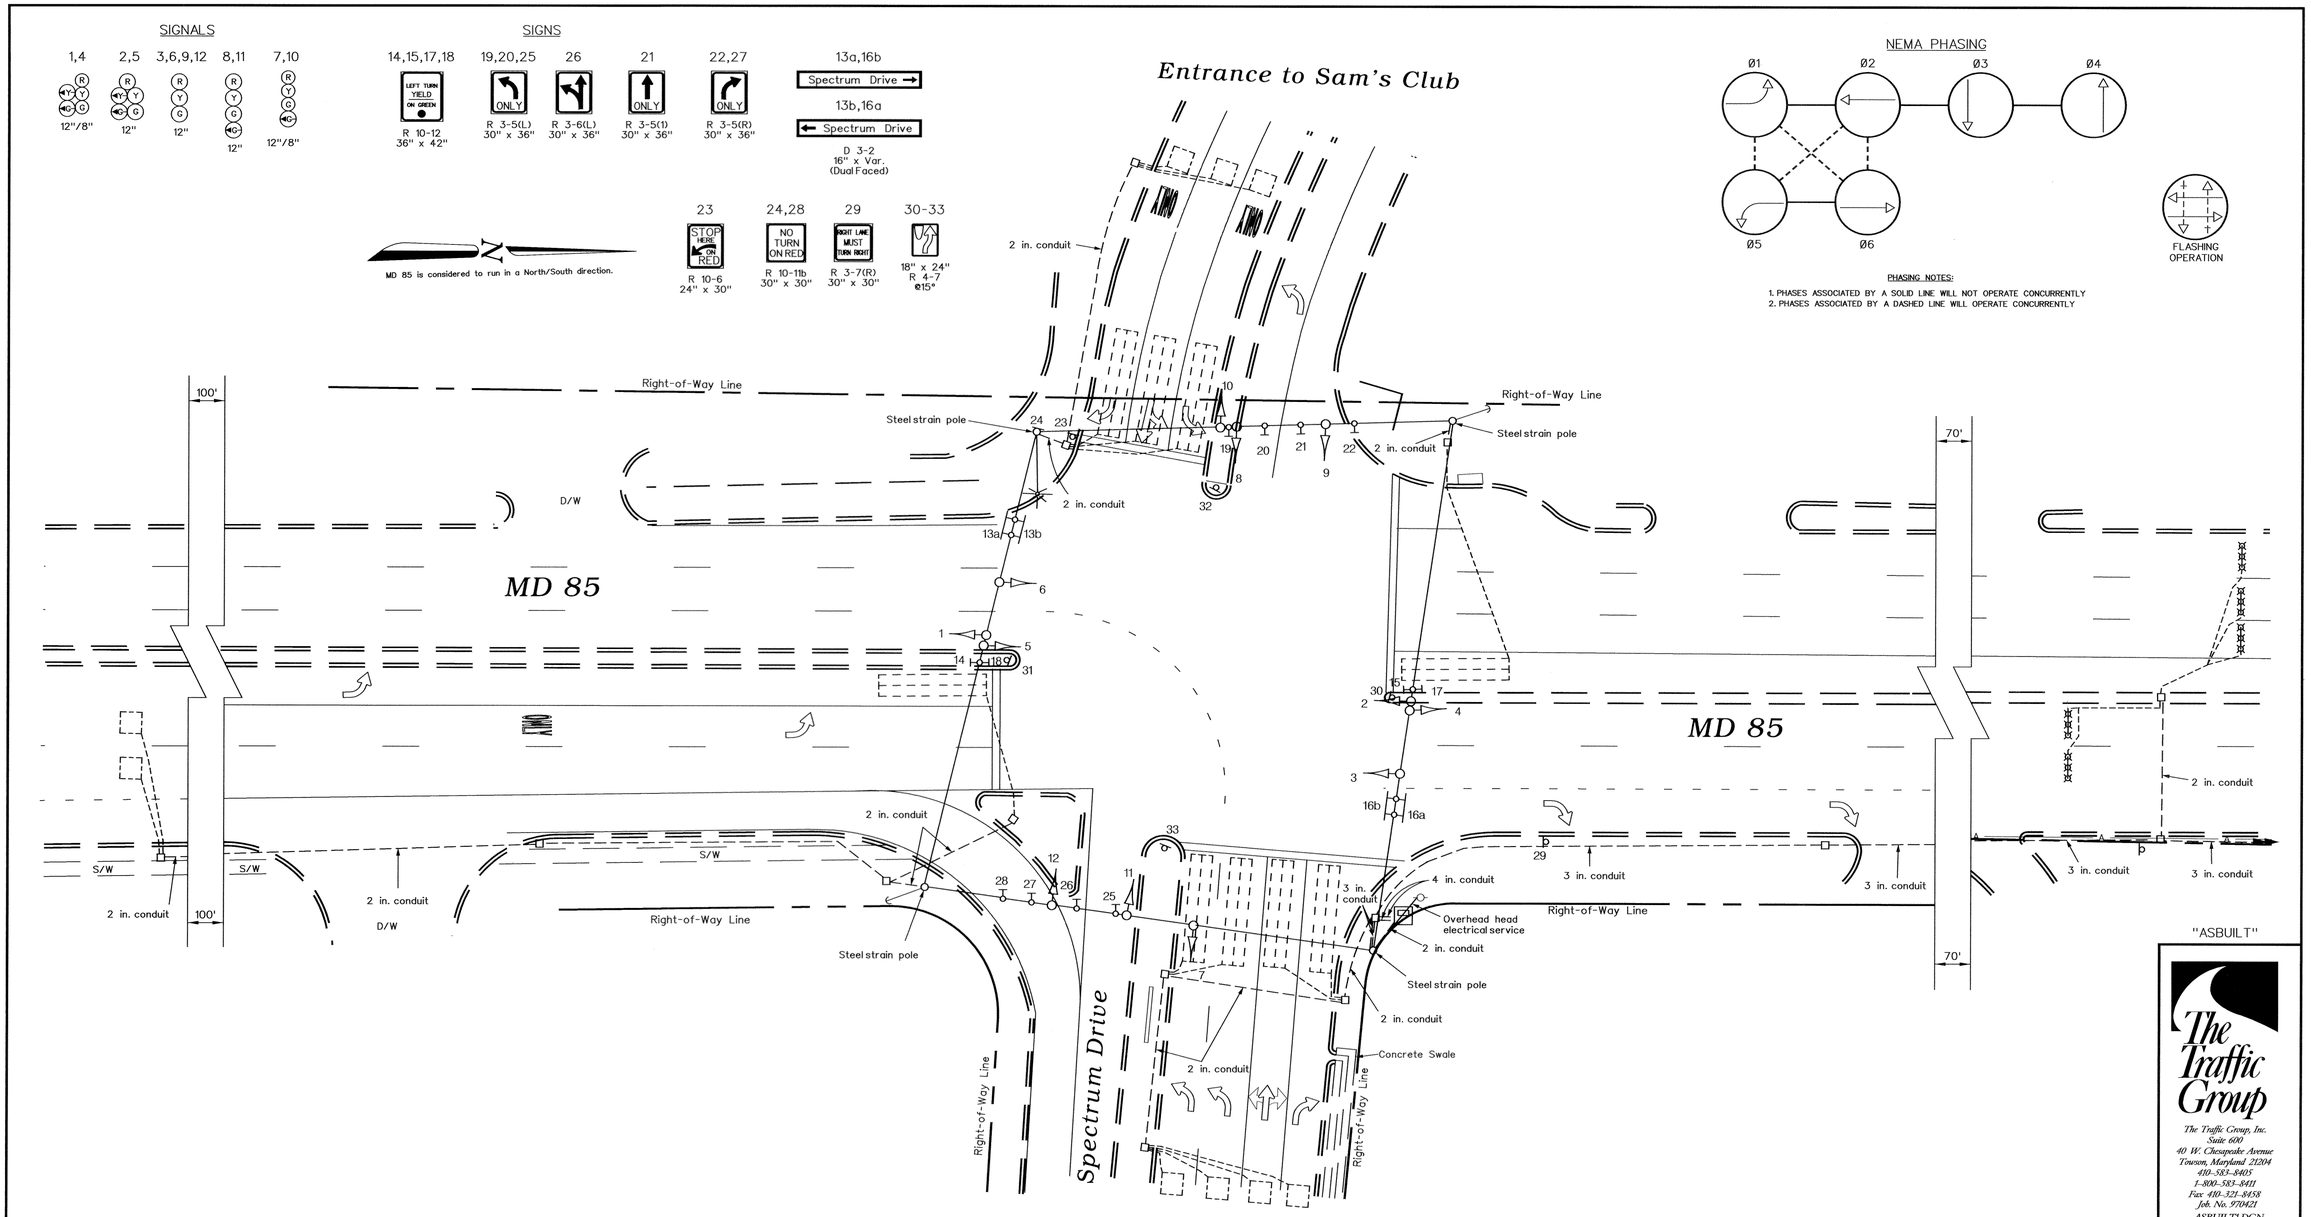

The Traffic Group

The Traffic Group, Inc.
Suite 600
40 W. Chesapeake Avenue
Towson, Maryland 21204
410-583-8405
1-800-583-8411
Fax 410-321-8458
Job. No. 970421
ASBUILT1.DGN

GEOMETRIC LEGEND

EXISTING GEOMETRICS
PROPOSED GEOMETRICS

UTILITY LEGEND

G	GAS MAIN
W	WATER MAIN
S	SEWER MAIN
E	ELECTRIC CABLES
D	STORM DRAIN
A	AERIAL CABLES
T	TELEPHONE CABLES

REVISIONS

ASBUILT
August 20, 1998
S.H.A. No.:BW996M82
FJH

APPROVALS

ASST. TRAFFIC ENGINEERING DESIGN DIVISION
ASST. DISTRICT ENGINEER - TRAFFIC
CHIEF, TRAFFIC ENGINEERING DESIGN DIVISION
DIRECTOR, OFFICE OF TRAFFIC & SAFETY

ORIGINAL ON FILE

MDOT - STATE HIGHWAY ADMINISTRATION
Office of Traffic & Safety
TRAFFIC ENGINEERING DESIGN DIVISION
(Traffic Signal Plan)

MD 85 at Spectrum Drive/Entrance to Sam's Club

DATE: January, 1996
LOG MILE •

DRAWN BY:	F. Mulis	F.A.P. NO.	N/A	PLAN SHEET NO.:	SHEET NO.
CHK. BY:	N/A	S.H.A. NO.	BW-524-802-712	2277J	1 of 1
SCALE:	1" = 20'	COUNTY:	FREDERICK		

f:\970421\des\asbuilt1.dgn 24 AUG 199