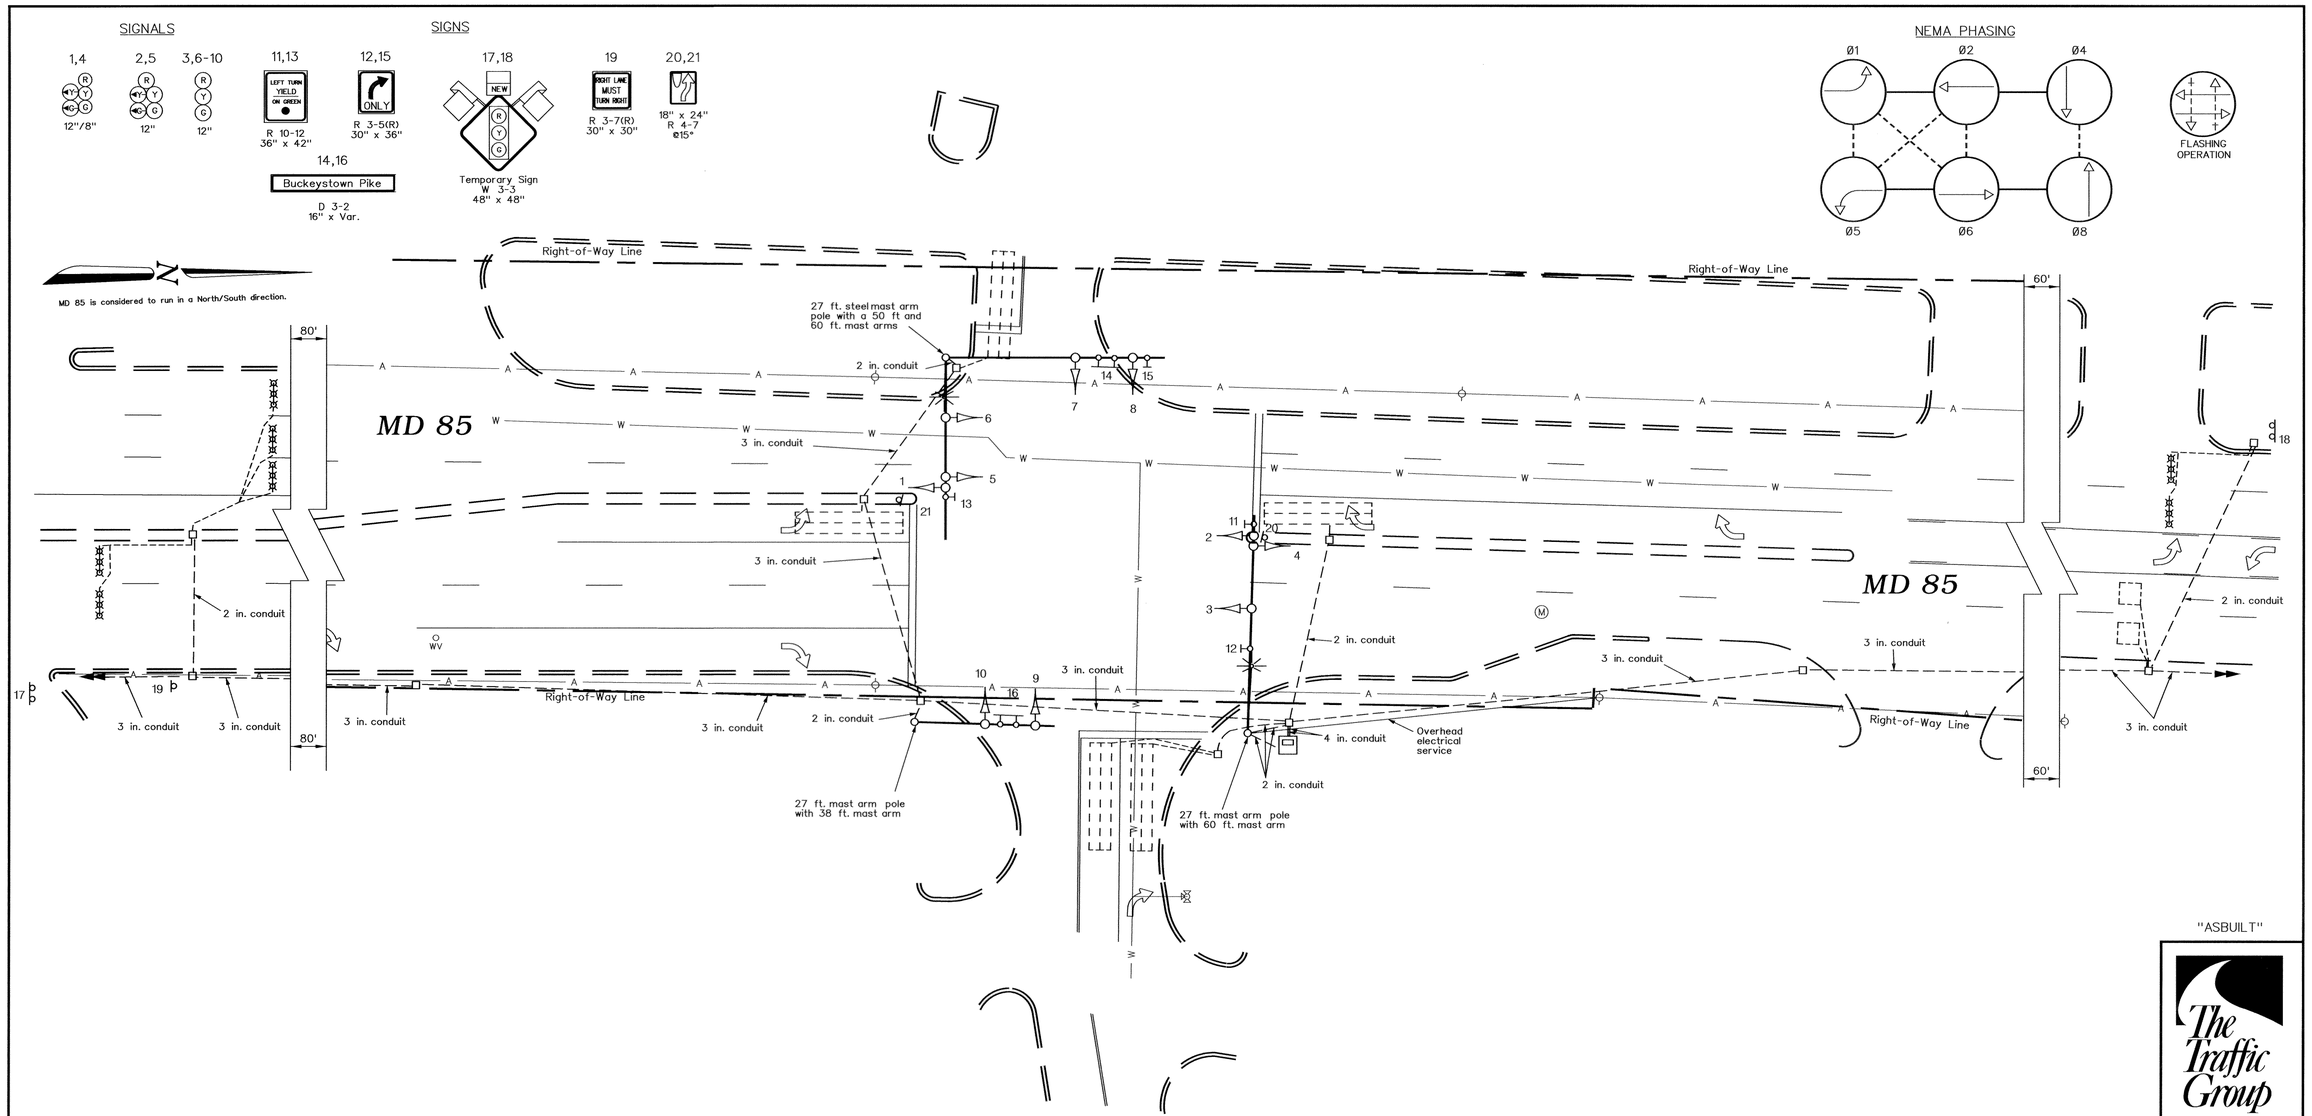

"ASBUILT"

The Traffic Group
The Traffic Group, Inc.
Suite 600
40 W. Chesapeake Avenue
Towson, Maryland 21204
410-583-8405
1-800-583-8411
Fax 410-321-8458
Job. No. 970421
ASBUIT2.DGN

GEOMETRIC LEGEND

EXISTING GEOMETRICS
PROPOSED GEOMETRICS

UTILITY LEGEND

G	GAS MAIN
W	WATER MAIN
S	SEWER MAIN
E	ELECTRIC CABLES
D	STORM DRAIN
A	AERIAL CABLES
T	TELEPHONE CABLES

REVISIONS

(A) ASBUILT August 20, 1999
S.H.A. No.:BW996M82
FJH

APPROVALS

ASST. TRAFFIC ENGINEERING DESIGN DIVISION
ASST. DISTRICT ENGINEER - TRAFFIC
CHIEF, TRAFFIC ENGINEERING DESIGN DIVISION
DIRECTOR, OFFICE OF TRAFFIC & SAFETY

ORIGINAL ON FILE

MDOT – STATE HIGHWAY ADMINISTRATION
Office of Traffic & Safety
TRAFFIC ENGINEERING DESIGN DIVISION
(Traffic Signal Plan)

MD 85 at Entrance to Lowes

DATE: June 17, 1998 LOG MILE *

DRAWN BY:	F. Hoeckel	F.A.P. NO.	N/A	PLAN SHEET NO.:	SHEET NO.
CHK. BY:		S.H.A. NO.	BW996M82	3738A	1 of 1
SCALE:	1" = 20'	COUNTY:	FREDERICK		

f:\970421\des\asbuilt2.dgn 24 AUG 1999