DIMENSION DIAGRAM

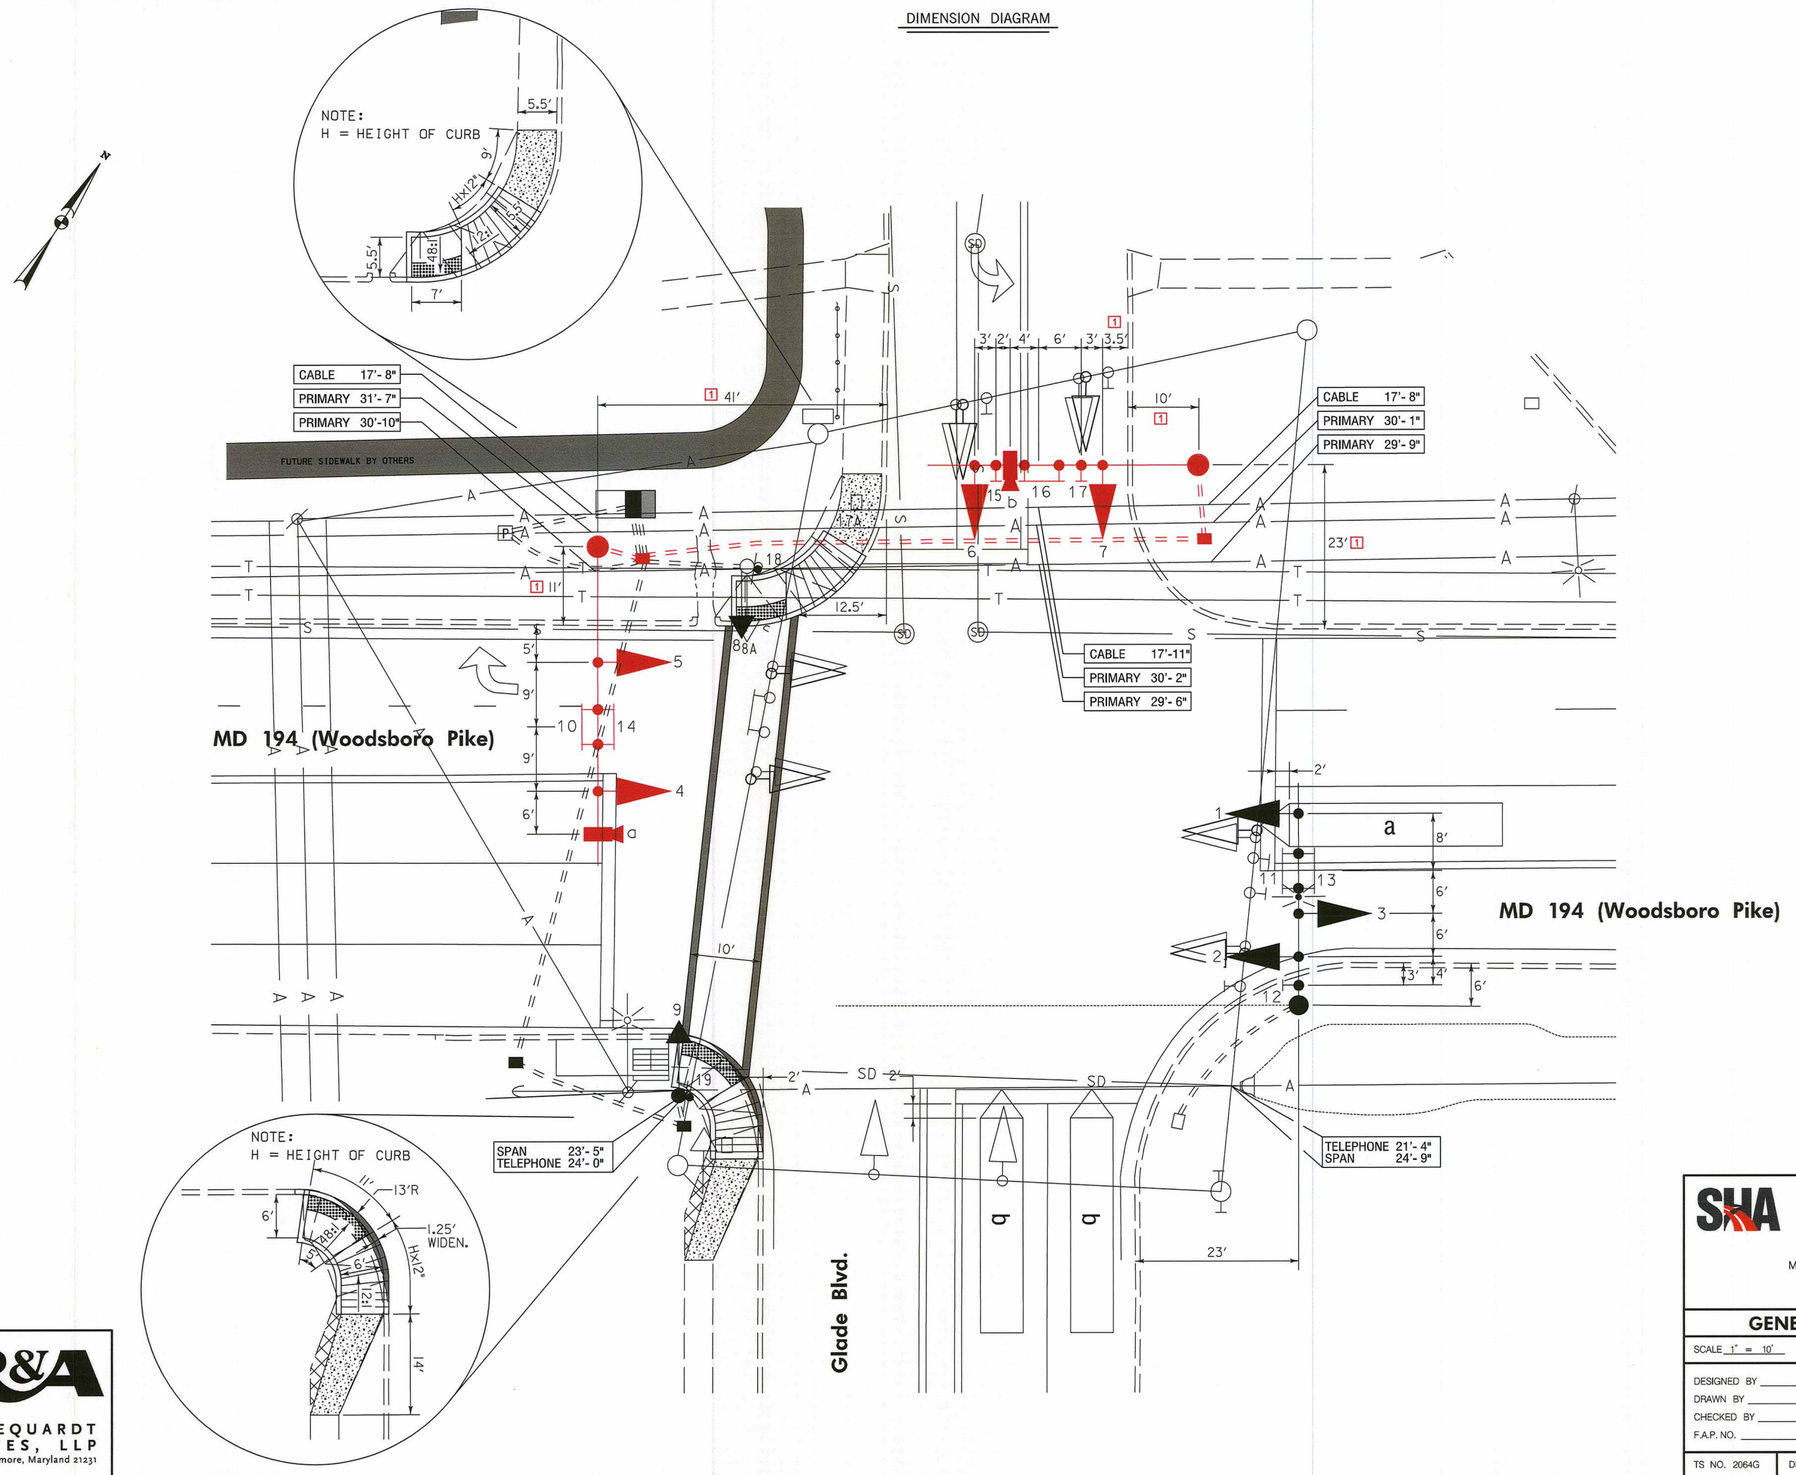

1 REDLINE REVISION NO. 1
REVISED DIMENSIONS
8/01/2012

WR&A
WHITMAN, REQUARDT & ASSOCIATES, LLP
801 South Caroline Street, Baltimore, Maryland 21231

BY: sbloss

SHA
STATE OF MARYLAND
DEPARTMENT OF TRANSPORTATION
STATE HIGHWAY ADMINISTRATION
OFFICE OF TRAFFIC & SAFETY
TRAFFIC ENGINEERING DESIGN DIVISION

MD 194 (Woodsboro Pike) and Glade Blvd.
Walkersville, Maryland

GENERAL INFORMATION SHEET

SCALE 1" = 10' DATE 5/08/2012 CONTRACT NO. XX6505185

DESIGNED BY S. Bloss
DRAWN BY S. Bloss
CHECKED BY N. Leary
F.A.P. NO.

COUNTY Frederick
LOGMILE 10019402.83
TIMS NO. L270
TOD NO.

TS NO. 2064G | DRAWING TSP – 2 OF 3 | SHEET NO. 2 OF 3

PLOTTED: August 03, 2012
FILE: N:\31669-195\CADD\Redline1_2012.07\pSG-N002_L270-R.1.dgn