K&E BALTIMORE 17 0153 PHOENIX 10-75 MC 4156

F.H.W.A. REGION NO.	STATE	FED. AID PROJ. NO.	SHEET NO.	TOTAL SHEETS
3	MD.	F-228-1(1) TCD-228-1(1)	4	16

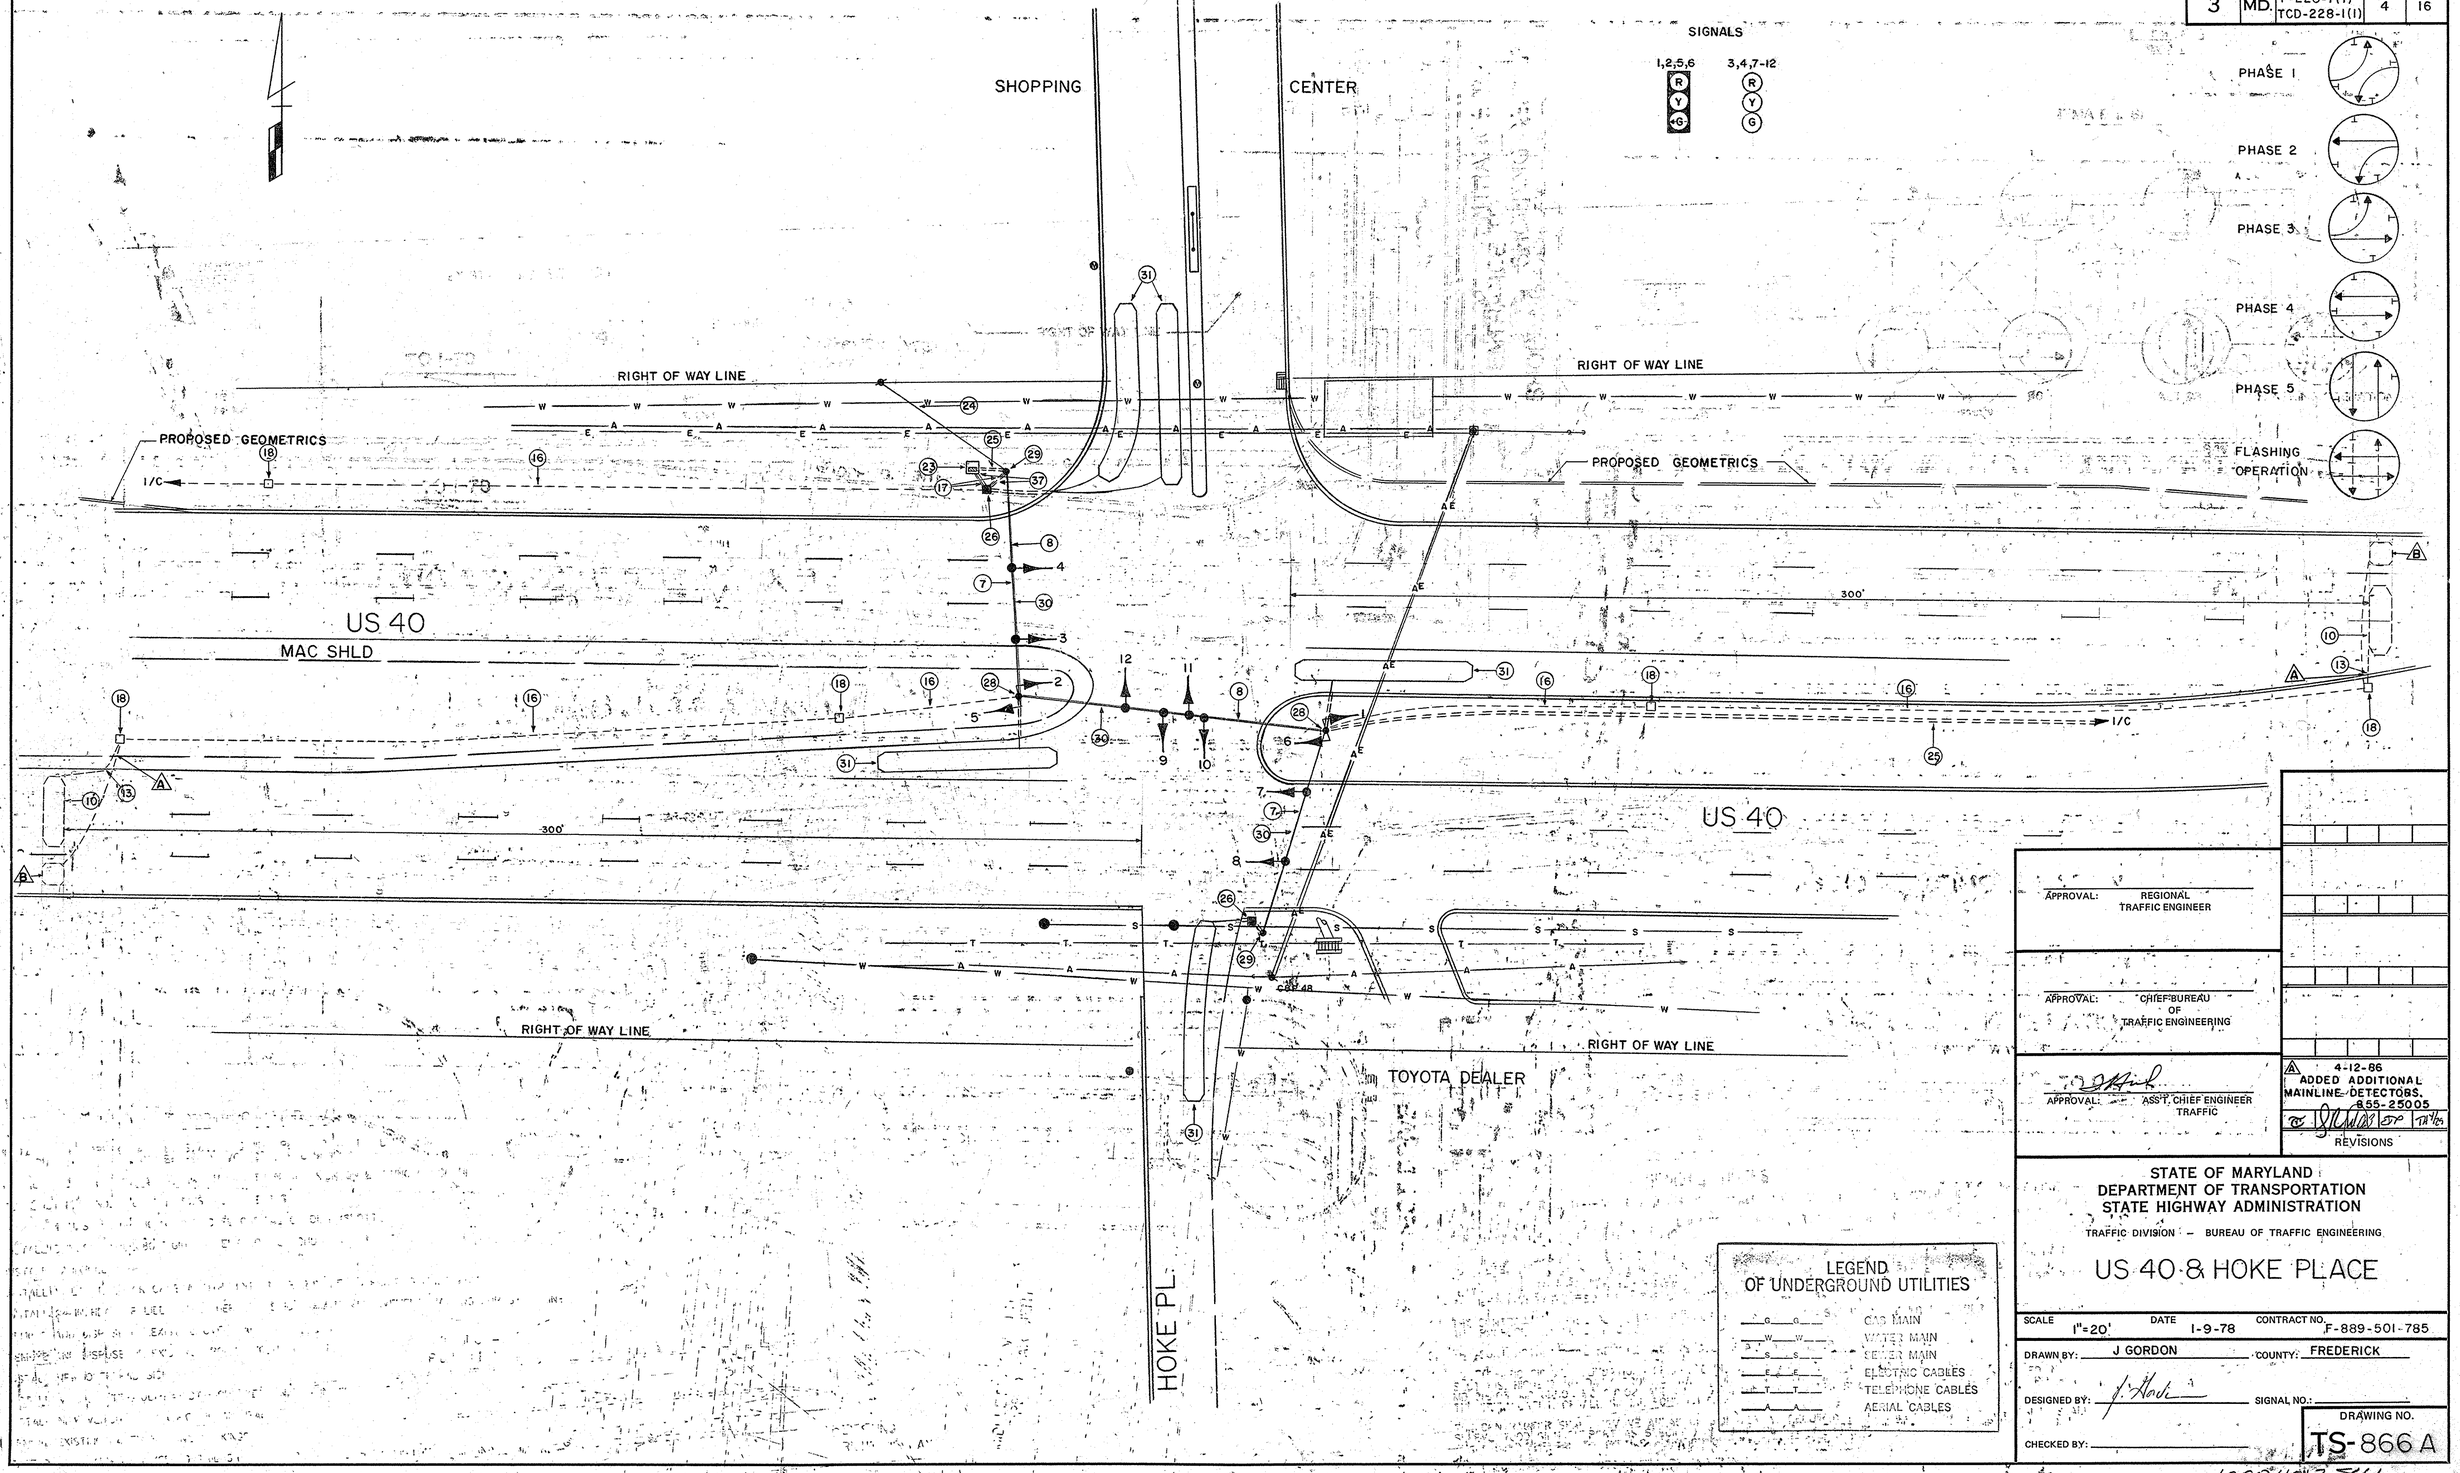

APPROVAL: REGIONAL TRAFFIC ENGINEER

APPROVAL: CHIEF BUREAU OF TRAFFIC ENGINEERING

APPROVAL: ASS'T. CHIEF ENGINEER TRAFFIC

4-12-86 ADDED ADDITIONAL MAINLINE DETECTORS. 855-25005

REVISIONS

STATE OF MARYLAND
DEPARTMENT OF TRANSPORTATION
STATE HIGHWAY ADMINISTRATION

TRAFFIC DIVISION – BUREAU OF TRAFFIC ENGINEERING

US 40 & HOKE PLACE

SCALE	DATE	CONTRACT NO.
1"=20'	1-9-78	F-889-501-785

DRAWN BY: J GORDON COUNTY: FREDERICK

DESIGNED BY: SIGNAL NO.:

CHECKED BY:

DRAWING NO. TS-866 A

1000402.84