OFFICE OF TRAFFIC
TRAFFIC CONTROL DEVICE
STAR PROJECT

DATE: SEPT. 30, 1993

LOCATION: U.S. 40 @ md. 17 COUNTY: FREDERICK

CONTRACT NO: 855-2504 3075 PHASING: I.C.B.

PEDESTRIANS: N/A ACTUATION: NONE

SIGNING: STREET NAME ONLY LIGHTING: YES

R/W STAKEOUT: N/A UTILITY STAKEOUT: YES

ATTENDEES:

T.E.D.	T.O.D.
GENE SIMMERS	GEORGE DEDOULIS

DIST.	UTILITY REP.
DON DISTANCE	LUTHER CROMERS REPRESENTATIVE

AWARD DATE:

N.T.P.

WORKING DAYS:

EXPECTED COMPLETION DATE: ~~OCT. 31, 1993~~

CONTRACTOR

CLYDE ANDERSEN

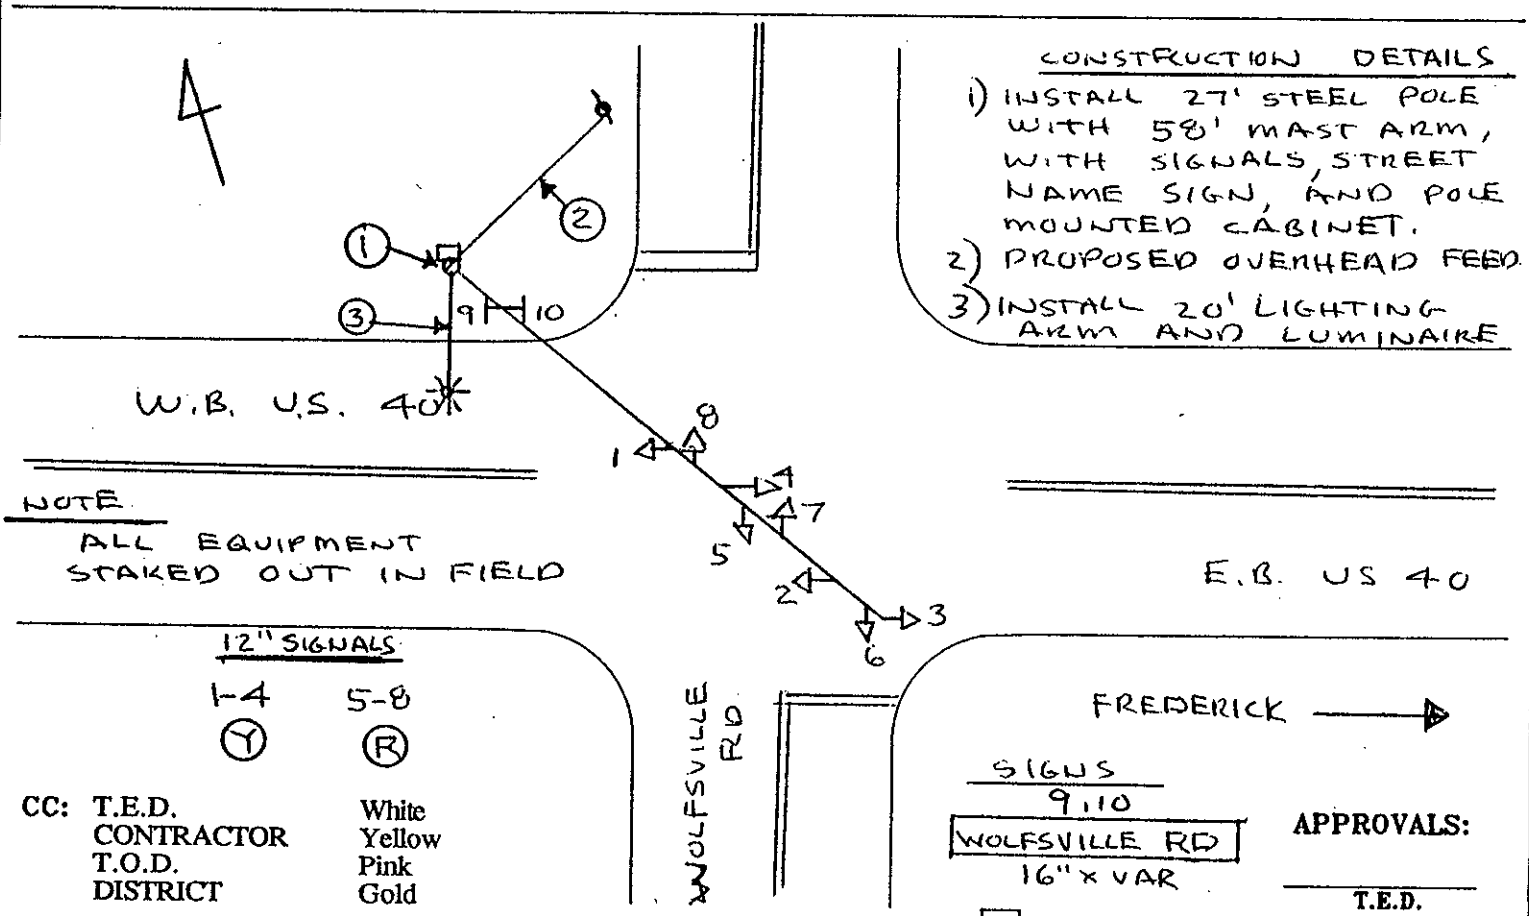

CONSTRUCTION DETAILS

1) INSTALL 27' STEEL POLE WITH 58' MAST ARM, WITH SIGNALS, STREET NAME SIGN, AND POLE MOUNTED CABINET.
2) PROPOSED OVERHEAD FEED
3) INSTALL 20' LIGHTING ARM AND LUMINAIRE

NOTE

ALL EQUIPMENT STAKED OUT IN FIELD

12" SIGNALS

1-4 (Y) 5-8 (R)

CC: T.E.D. White
CONTRACTOR Yellow
T.O.D. Pink
DISTRICT Gold

APPROVALS:

T.E.D.

T.O.D.

FOR ADDITIONAL REMARKS SEE ATTS. ☐