F.H.W.A. REGION NO.	STATE	FED. AID PROJ. NO.	SHEET NO.	TOTAL SHEETS
3	MD.	F-228-1(1) TCD-228-1(1)	3	16

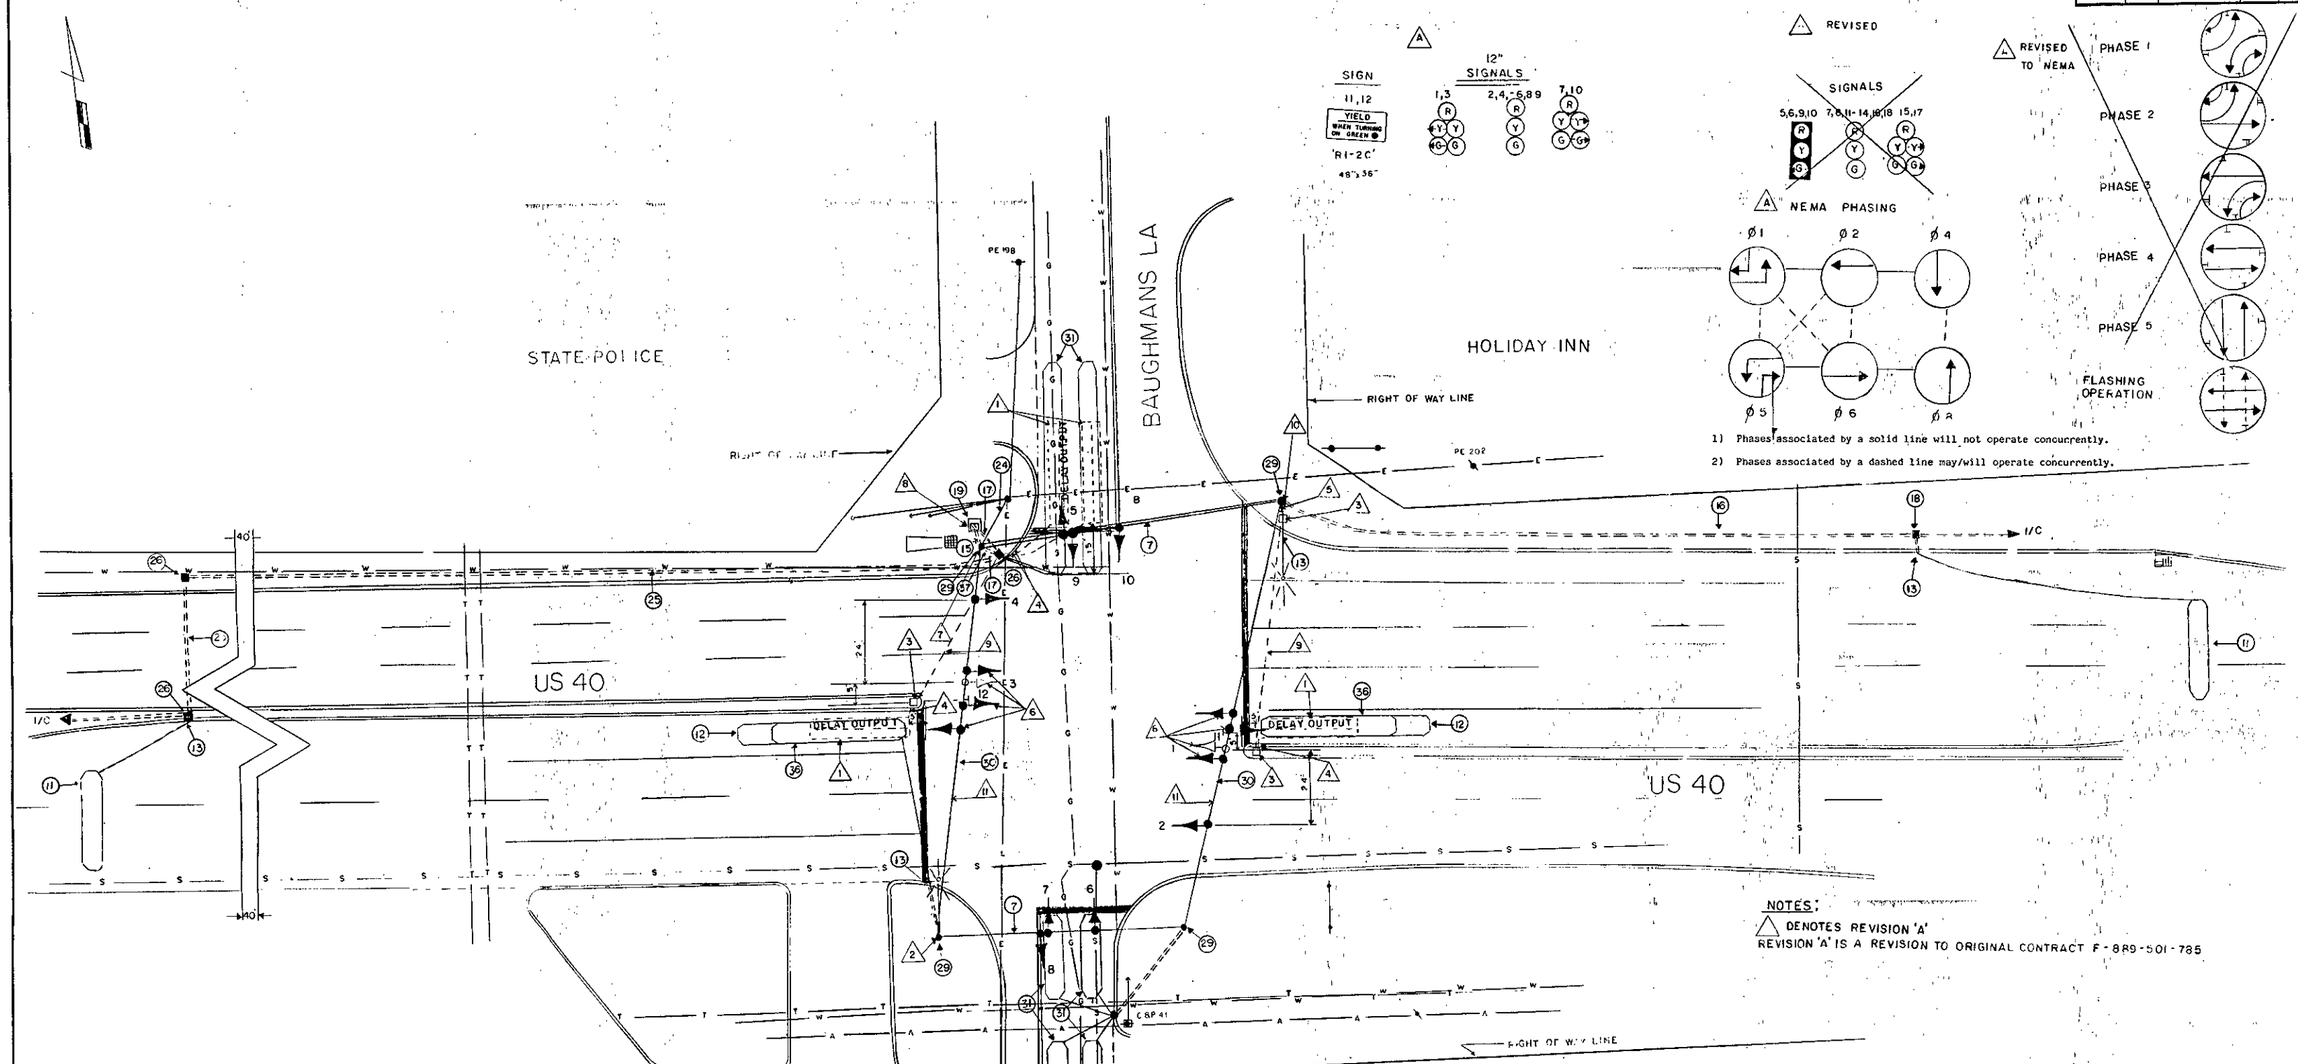

NOTES:

△ DENOTES REVISION 'A'

REVISION 'A' IS A REVISION TO ORIGINAL CONTRACT F-889-501-785

APPROVAL CHIEF SIGNAL DESIGN SECTION	
APPROVAL DISTRICT TRAFFIC ENGINEER	
APPROVAL CHIEF BUREAU OF TRAFFIC ENGINEERING	
APPROVAL DEPUTY CHIEF ENGINEER OFFICE OF TRAFFIC	
ORIGINAL ON FILE	

REVISIONS

△ REDRAWN & REVISED 4-85 LY FROM EXCLUSIVE TC F/P ON US 40, INSTALL STREET LIGHTING SHA NO. 855-21002

STATE OF MARYLAND
DEPARTMENT OF TRANSPORTATION
STATE HIGHWAY ADMINISTRATION
BUREAU OF TRAFFIC ENGINEERING
OFFICE OF TRAFFIC

US 40 & BAUGHMANS LA.

SCALE 1"=20' DATE 3/77 CONTRACT NO. ORIG. F-889-501-785

DRAWN BY: J GORDON COUNTY: FREDERICK

DESIGNED BY: SIGNAL NO.: 10014

CHECKED BY:

DRAWING NO: TS-725A

1000 4013.01