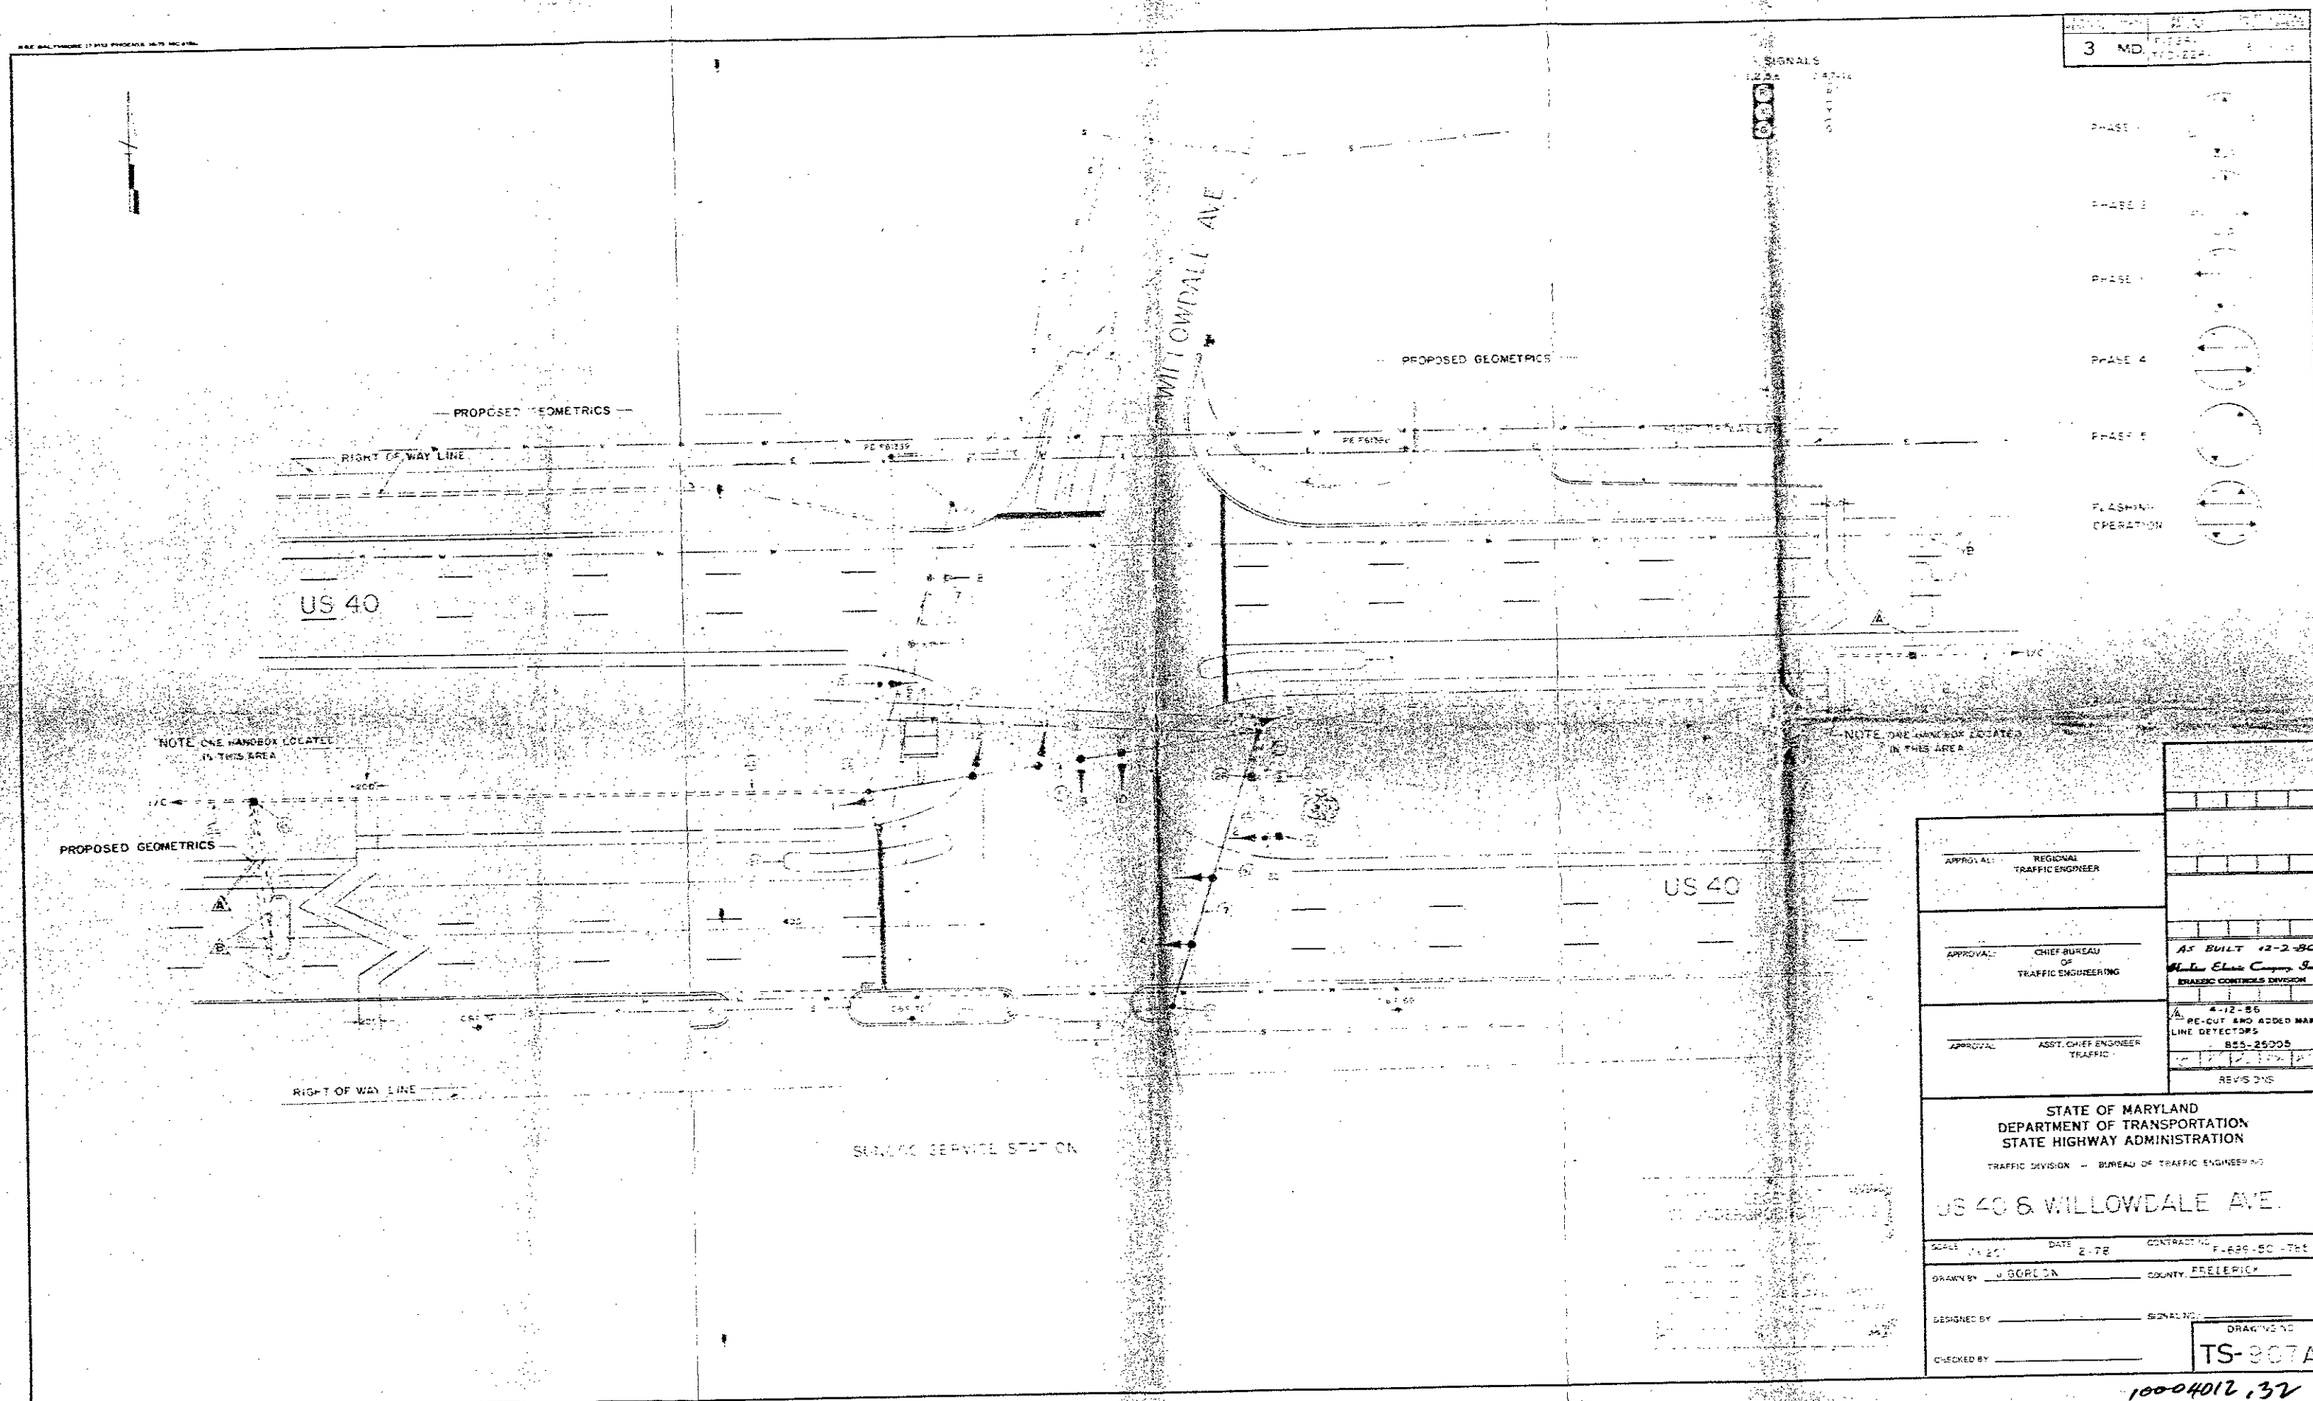

3 MD.
SIGNALS
PHASE 1
PHASE 2
PHASE 3
PHASE 4
PHASE 5
FLASHING OPERATION
WILLOWDALE AVE
PROPOSED GEOMETRICS
RIGHT OF WAY LINE
US 40
NOTE ONE HANDBOX LOCATED IN THIS AREA
PROPOSED GEOMETRICS
RIGHT OF WAY LINE
SUNOCO SERVICE STATION
US 40
NOTE ONE HANDBOX LOCATED IN THIS AREA
APPROVAL: REGIONAL TRAFFIC ENGINEER
APPROVAL: CHIEF BUREAU OF TRAFFIC ENGINEERING
APPROVAL: ASST. CHIEF ENGINEER TRAFFIC
AS BUILT 12-2-86
Hunter Electric Company, Inc.
TRAFFIC CONTROLS DIVISION
4-12-86
RE-CUT AND ADDED MAIN-LINE DETECTORS
855-25005
REVISIONS
STATE OF MARYLAND
DEPARTMENT OF TRANSPORTATION
STATE HIGHWAY ADMINISTRATION
TRAFFIC DIVISION — BUREAU OF TRAFFIC ENGINEERING
US 40 & WILLOWDALE AVE.
SCALE
DATE 2-78
CONTRACT NO. F-689-50-785
DRAWN BY J. GORDON
COUNTY FREDERICK
DESIGNED BY
SIGNAL NO.
CHECKED BY
DRAWING NO.
TS-907A

10004012.32