PROJECT DESCRIPTION

THIS PROJECT INVOLVES THE RECONSTRUCTION OF THE FULL-COLOR TRAFFIC SIGNAL AT THE INTERSECTION OF US 40 (W. PATRICK ST) AT MCCAIN DRIVE. THE INSTALLATION INCLUDES LED TRAFFIC SIGNAL HEADS, LED COUNTDOWN PEDESTRIAN SIGNAL HEADS, IP-BASED VIDEO DETECTION EQUIPMENT, AND APS PUSHBUTTONS AND SIGNS.
US 40 IS ASSUMED TO RUN IN AN EAST-WEST DIRECTION.

INTERSECTION OPERATION

THE INTERSECTION WILL CONTINUE TO OPERATE IN A NEMA SIX-PHASE FULL-TRAFFIC-ACTUATED MODE WITH AN ALTERNATE PEDESTRIAN PHASE FOR THE WEST LEG AND CONCURRENT PEDESTRIAN PHASES FOR THE NORTH AND SOUTH LEGS OF THE INTERSECTION. THE US 40 EASTBOUND AND WESTBOUND LEFT TURNS OPERATE IN EXCLUSIVE PHASING. THE MCCAIN DRIVE APPROACHES OPERATE IN SPLIT PHASING.

CONTROLLER REQUIREMENTS

THE EXISTING BASE MOUNTED CABINET SHALL BE REMOVED. THE EXISTING CONTROLLER SHALL BE RETURNED TO SHA. A NEW BASE MOUNTED CABINET AND CONTROLLER WITH UPS BATTERY BACKUP SHALL BE FURNISHED BY SHA AND INSTALLED BY THE CONTRACTOR. A 2-WIRE APS CENTRAL CONTROL UNIT SHALL BE FURNISHED BY THE CONTRACTOR AND INSTALL BY SHA. IP-BASED VIDEO DETECTION INTERFACE EQUIPMENT SHALL BE FURNISHED AND INSTALLED BY SHA.

SPECIAL NOTES

APS WILL FUNCTION AS FOLLOWS:

TO CROSS US 40 (W. PATRICK STREET):

A. WHEN PEDESTRIAN LOCATES AND PRESSES PUSHBUTTON FOR AN EXTENDED TIME, THE PUSHBUTTON UNIT MESSAGE WILL BE "WAIT TO CROSS WEST PATRICK AT MCCAIN. WAIT."

B. WHEN WALK PHASE BEGINS, THE MESSAGE WILL BE A RAPID TICK WHICH WILL LAST FOR THE DURATION OF THE WALK PHASE.

TO CROSS MCCAIN DRIVE:

A. WHEN PEDESTRIAN LOCATES AND PRESSES PUSHBUTTON FOR AN EXTENDED TIME, THE PUSHBUTTON UNIT MESSAGE WILL BE "WAIT TO CROSS MCCAIN AT WEST PATRICK. WAIT."

B. WHEN WALK PHASE BEGINS, THE MESSAGE WILL BE A RAPID TICK WHICH WILL LAST FOR THE DURATION OF THE WALK PHASE.

GENERAL NOTES

1. THE CONTRACTOR SHALL VERIFY ALL PROPOSED POLE LOCATIONS PRIOR TO INSTALLATION.
2. THE CONTRACTOR SHALL BE RESPONSIBLE FOR TERMINATING ALL SIGNAL CABLE TO THE APPROPRIATE TERMINALS AND PROPERLY LABELING EACH CABLE.
3. ALL UNUSED CABLE SHALL BE REMOVED AND DISPOSED OF BY THE CONTRACTOR.
4. ALL TRAFFIC SIGNAL FOUNDATIONS SHALL BE INSTALLED AT THE FINAL SIDEWALK OR CURB GRADE FOR CLOSED SECTIONS. HIGHEST ROADWAY PROFILE GRADE FOR OPEN SECTIONS. TO MEET CLEARANCES AS SPECIFIED IN MD 816.03, MD 818.01, MD 818.02 AND MD 818.04. THE CONTRACTOR SHALL VERIFY ULTIMATE GRADES PRIOR TO THE INSTALLATION OF ALL SIGNAL EQUIPMENT.
5. UNDERGROUND UTILITIES SHOWN ON THESE PLANS ARE SCHEMATIC ONLY AND MAY NOT BE COMPLETE. THE CONTRACTOR SHALL BE RESPONSIBLE FOR NOTIFYING "MISS UTILITY" PRIOR TO CONSTRUCTION SO THAT ALL UTILITIES MAY BE LOCATED IN THE FIELD. IF THE CONTRACTOR PERCEIVES THAT A CONFLICT BETWEEN THE UTILITIES AND THE TRAFFIC SIGNAL WILL OCCUR, THE CONTRACTOR SHALL NOTIFY THE PROJECT ENGINEER IMMEDIATELY SO THAT THE CONFLICT MAY BE RESOLVED.
6. ALL PEDESTAL FOUNDATION TOPS SHALL BE INSTALLED FLUSH WITH SIDEWALK GRADE.
7. LOCATION OF ACCESSIBLE PEDESTRIAN SIGNAL PUSHBUTTONS MUST MEET LOCATION REQUIREMENTS OF MDMUTCD CHAPTER 4E "PEDESTRIAN CONTROL FEATURES" AND FIGURES 4E-3 AND 4E-4 AND THE LATEST NCHRP PUBLICATION, "ACCESSIBLE PEDESTRIAN SIGNALS GUIDE TO BEST PRACTICE." IF NOT MET, THE CONTRACTOR IS TO STOP WORK ON PUSHBUTTON LOCATIONS UNTIL A DESIGN WAIVER IS OBTAINED, APPROVED BY THE DIRECTOR, OFFICE OF TRAFFIC AND SAFETY.
8. PUSHBUTTONS ARE TO BE LOCATED SO THAT THEY CAN BE ACTIVATED BY A PERSON IN A WHEELCHAIR REACHING LESS THAN 18" FROM A 60" X 60" LEVEL LANDING AREA WITH A CROSS SLOPE OF LESS THAN OR EQUAL TO 2%.
9. THE 10' SEPARATION BETWEEN PUSHBUTTONS IS TO BE MEASURED FROM FACE OF PUSHBUTTON TO FACE OF PUSHBUTTON. NOT CENTER OF POLE TO CENTER OF POLE.
10. PUSHBUTTON ARROWS AND SIGNS ARE TO BE ORIENTED PARALLEL TO THE CROSSING FOR WHICH THEY ARE INTENDED.
11. PROPOSED LUMINAIRES SHALL BE SUPPLIED WITH A PHOTOCELL.
12. VIDEO DETECTION CAMERA ALIGNMENT SHALL BE COORDINATED WITH THE ENGINEER.
13. DURING CONSTRUCTION, PROPOSED SIGNAL EQUIPMENT SHALL NOT BLOCK EXISTING SIGNAL EQUIPMENT.
14. THE CONTRACTOR SHALL CAP AND ABANDON CONDUITS FEEDING EXISTING SIGNAL EQUIPMENT THAT IS REMOVED.
15. 10 FEET OF SLACK SHALL BE PROVIDED IN EACH HANDHOLE FOR INTERCONNECT CABLE.
16. THE CONTRACTOR SHALL CONTACT ED RODENHIZER AT THE SIGNAL SHOP (410-787-7652) TO DELIVER APS EQUIPMENT FOR TESTING.
17. PEDESTRIAN ACCESS SHALL BE MAINTAINED DURING CONSTRUCTION. IF PEDESTRIAN ACCESS CANNOT BE MAINTAIN, A PEDESTRIAN DETOUR SHALL BE PROVIDED BASED ON DISTRICT TRAFFIC APPROVAL.

EQUIPMENT LIST "A & C"

A. EQUIPMENT TO BE SUPPLIED BY SHA.

ITEM NO.	DESCRIPTION	UNIT	QUANTITY
9016	4 CHANNEL DETECTOR AMPLIFIER	EA	2
9104	CONTROLLER CABINET, SIZE "S" W/CTRL, VIDEO INT. 1-8 CAM	EA	1
9110	UPS EQUIPMENT FOR "S" CABINET	EA	1
9570	SHEET ALUMINUM GROUND MOUNTED SIGN 2 ~~1~~ - R4-7 24"X30" 2 ~~1~~ - OM1-3 FY 18"X18"	SF	16 ~~8~~
9571	SHEET ALUMINUM MAST ARM / POLE MOUNTED SIGN 4 - D-3(1) 60"X16" 4 - M1-5(4) 78"X36" 1 - R3-5L 30"X36" 1 - R3-5R 30"X36" [1] 7 ~~6~~ - R10-3(1) 9"X15" 1 - R3-6(1) 30"X30" 1 - R3-5(2) MOD 60"X36" ~~1 - R4-7 24"X30"~~	SF	148 ~~153~~ [1]

C. THE EXISTING CABINET AND CONTROLLER SHALL BE RETURNED TO SHA. ALL OTHER MATERIALS TO BE REMOVED BY THE CONTRACTOR SHALL BECOME THE PROPERTY OF THE CONTRACTOR.

EQUIPMENT LIST "B"

B. EQUIPMENT TO BE FURNISHED AND/OR INSTALLED BY THE CONTRACTOR.

ITEM NO.	DESCRIPTION	UNIT	QUANTITY
1001	MAINTENANCE OF TRAFFIC	EA	3
2001	CLASS 2 EXCAVATION	CY	5.5
2002	TEST PIT EXCAVATION	CY	5
5001	REMOVAL OF EXISTING PERMANENT PAVEMENT MARKINGS SYMBOLS OR LEGENDS	EA	3
5002	5" HEAT APPLIED WHITE OR YELLOW PERMANENT PAVEMENT MARKINGS	LF	85
5003	REMOVAL OF EXISTING PERMANENT PAVEMENT LINE MARKINGS	LF	1110
5004	12 INCH WHITE PREFORMED THERMOPLASTIC PAVEMENT MARKING LINES	LF	560
5005	24 INCH WHITE PREFORMED THERMOPLASTIC PAVEMENT MARKING LINES	LF	120
5006	WHITE PREFORMED THERMOPLASTIC PAVEMENT MARKING LEGENDS AND SYMBOLS	SF	155
6001	STANDARD TYPE A COMBINATION CURB AND GUTTER 12 INCH GUTTER PAN 8 INCH DEPTH	LF	349 ~~333~~
6002	5 INCH CONCRETE SIDEWALK	SF	1627 ~~1625~~
6003	DETECTABLE WARNING SURFACE FOR CURB RAMPS	SF	103 ~~75~~
8001	12 INCH LED SIGNAL HEAD SECTION	EA	41
8002	2-WIRE CENTRAL CONTROL UNIT	EA	1
8007	ANY SIZE LIGHTING ARM ON SIGNAL POLE WITH 250 WATT HPS LAMP AND LUMINAIRE	EA	2
8008	AUDIBLE/TACTILE PEDESTRIAN PUSHBUTTON STATION AND SIGNS	EA	7 ~~6~~
8009	BREAKAWAY PEDESTAL POLE (ANY SIZE)	EA	7 ~~4~~
8012	EMBEDDED METERED SERVICE PEDESTAL	EA	1
8015	LED 16 INCH COUNTDOWN PEDESTRIAN SIGNAL HEAD	EA	6
8022	NONINVASIVE DETECTOR (ANY LENGTH) LEAD IN CABLE UP TO 1000'	EA	6
8023	REMOVE & DISPOSE OF EQUIPMENT (PER ASSIGNMENT)	EA	1
8026	TWIN MAST ARM POLE & 50'/70' MAST ARMS ANY 'T' DIMENSION	EA	[1] 2
8028	VIDEO DETECTION CAMERA AND CABLE ANY LENGTH	EA	4
8033	DISCONNECT, PULL-BACK & REROUTE CABLES	LF	320
8034	ELECTRICAL CABLE - 2 CONDUCTOR (NO. 12 AWG) TYPE T/C	LF	540
8036	UP TO 4 INCH SCHEDULE 80 RIGID PVC CONDUIT-BORED	LF	595
8038	UP TO 4 INCH SCHEDULE 80 RIGID PVC CONDUIT-TRENCHED	LF	1040 ~~1015~~
8039	WOOD SIGN SUPPORTS UP TO 4' X 6'	LF	52 ~~26~~
8040	INSTALL OVERHEAD OR GROUND MOUNTED SIGN (INCLUDING ALL HARDWARE)	SF	164 ~~161~~
8042	NO. 6 AWG STRANDED BARE COPPER GROUND WIRE	LF	835 ~~800~~
8045	ELECTRICAL CABLE 1-CONDUCTOR NO. 8 AWG-THHN/THWN	LF	100
8046	FURNISH AND INSTALL ELECTRICAL HANDHOLE	EA	14
8053	ELECTRICAL CABLE - 2 CONDUCTOR (NO. 14 AWG)	LF	1270 ~~1140~~
8055	ELECTRICAL CABLE - 5 CONDUCTOR (NO. 14 AWG)	LF	1290
8056	ELECTRICAL CABLE - 7 CONDUCTOR (NO. 14 AWG)	LF	2200
8062	INSTALL CONTROLLER AND CABINET - BASE MOUNT (ANY SIZE)	EA	1
8069-A	F & I LED LUMINAIRE AND LAMPS	EA	2
[1] 8051	CUT, CLEAN, GALVANIZE AND CAP TRAFFIC SIGNAL STRUCTURE	EA	1

CONTACT PERSONS FOR DISTRICT #7 ARE AS FOLLOWS:

MR. JOHN CONCANNON
ASST. DISTRICT ENGINEER-TRAFFIC
PHONE: 301-624-8140

MR. JOHN HUCHROWSKI
ASST. DISTRICT ENGINEER-CONSTRUCTION
301-624-8200

MS. SUE PALMER
ASST. DISTRICT ENGINEER-MAINTENANCE
301-624-8105

CONTACT PERSONS FOR OOTS ARE AS FOLLOWS:

~~MR. AVIJIT MAJI~~ MS. CORREN JOHNSON
DIVISION CHIEF,
TRAFFIC OPERATIONS
PHONE: 410-787-7630 [1]

~~MR. ROBERT SNYDER~~
~~ASSISTANT DIVISION CHIEF~~
~~TRAFFIC OPERATIONS~~
~~410-787-7631~~

MR. ED RODENHIZER
CHIEF, SIGNAL OPERATIONS
410-787-7650

MR. EUGENE BAILEY
CHIEF, SIGN OPERATIONS
410-787-7676

PHASING CHART

	1	2	3	4	5	6	7	8	9	10	11	12	13	14	15	16	17	18	19
PHASE 1 AND 5	G	G	R	R	G	G	G	R	R	R	R	R	R	DW	DW	DW	DW	DW	DW
1 AND 5 CHANGE TO 1 AND 6, 2 AND 5, OR 2 AND 6																			
PHASE 1 AND 6	G	G	G	G	R	R	R	R	R	R	R	R	R	DW	DW	DW	DW	DW	DW
1 AND 6 CHANGE	Y	Y	G	G	R	R	R	R	R	R	R	R	R	DW	DW	DW	DW	DW	DW
PHASE 2 AND 5	R	R	R	R	G	G	G	G	G	R	R	R	R	DW	DW	DW	DW	DW	DW
2 AND 5 CHANGE	R	R	R	R	Y	Y	Y	G	G	R	R	R	R	DW	DW	DW	DW	DW	DW
PHASE 2 AND 6	R	R	G	G	R	R	R	G	G	R	R	R	R	WK	WK	DW	DW	WK	WK
PED CLEARANCE	R	R	G	G	R	R	R	G	G	R	R	R	R	FL/DW	FL/DW	DW	DW	FL/DW	FL/DW
2 AND 6 CHANGE	R	R	Y	Y	R	R	R	Y	Y	R	R	R	R	DW	DW	DW	DW	DW	DW
PHASE 3	R	R	R	R	R	R	R	R	R	G G	G	R	R	DW	DW	DW	DW	DW	DW
3 CHANGE	R	R	R	R	R	R	R	R	R	Y	Y	R	R	DW	DW	DW	DW	DW	DW
PHASE 4	R	R	R	R	R	R	R	R	R	R	R	G G	G	DW	DW	DW	DW	DW	DW
4 CHANGE	R	R	R	R	R	R	R	R	R	R	R	Y	Y	DW	DW	DW	DW	DW	DW
PHASE 4 ALT	R	R	R	R	R	R	R	R	R	R	R	G G	G	DW	DW	WK	WK	DW	DW
PED CLEARANCE	R	R	R	R	R	R	R	R	R	R	R	G G	G	DW	DW	FL/DW	FL/DW	DW	DW
4 ALT CHANGE	R	R	R	R	R	R	R	R	R	R	R	Y	Y	DW	DW	DW	DW	DW	DW
FLASHING OPERATION	FL/R	FL/R	FL/Y	FL/Y	FL/R	FL/R	FL/R	FL/Y	FL/Y	FL/R	FL/R	FL/R	FL/R	DARK	DARK	DARK	DARK	DARK	DARK

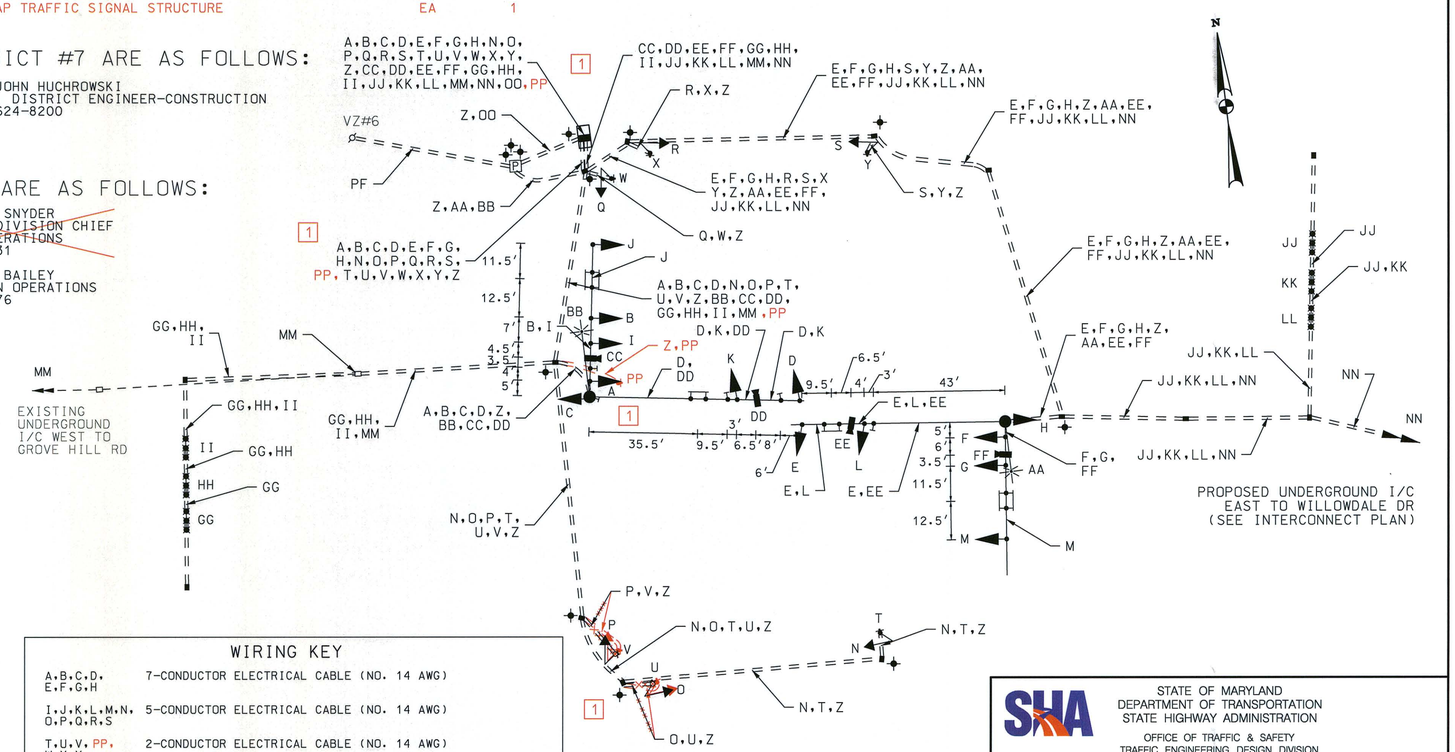

WIRING KEY

A,B,C,D, E,F,G,H	7-CONDUCTOR ELECTRICAL CABLE (NO. 14 AWG)
I,J,K,L,M,N, O,P,Q,R,S	5-CONDUCTOR ELECTRICAL CABLE (NO. 14 AWG)
T,U,V, PP, W,X,Y	2-CONDUCTOR ELECTRICAL CABLE (NO. 14 AWG)
[1] Z	STRANDED BARE COPPER GROUND WIRE (NO. 6 AWG)
AA,BB	2-CONDUCTOR ELECTRICAL CABLE, TYPE T/C (NO. 12 AWG)
CC,DD,EE,FF	IP-BASED VIDEO DETECTION CAMERA CABLE
GG,HH,II	NON-INVASIVE MICROPROBE SET WITH 500 FT. LEAD-IN CABLE
JJ,KK,LL	NON-INVASIVE MICROPROBE SET WITH 1000 FT. LEAD-IN CABLE
MM	DISCONNECT, PULLBACK AND REROUTE EXISTING INTERCONNECT COMMUNICATION CABLE
NN	12-PAIR INTERCONNECT COMMUNICATION CABLE, JELLY-FILLED (SEE INTERCONNECT PLAN)
OO	1-CONDUCTOR ELECTRICAL CABLE, TYPE THHW/THWN (NO. 8 AWG), 3 RUNS

PF	PROPOSED POWER FEED
	EXISTING GROUND ROD
	PROPOSED GROUND ROD

[1] REDLINE NO. 1
JULY 2013
MODIFY QUANTITIES

RK&K
Rummel, Klepper & Kahl, LLP
81 MOSHER STREET | BALTIMORE, MD 21217
Ph: (410) 728-2900 FAX: (410) 728-3160
Engineers Construction Managers Planners Scientists
www.rkk.com

STATE OF MARYLAND
DEPARTMENT OF TRANSPORTATION
STATE HIGHWAY ADMINISTRATION
OFFICE OF TRAFFIC & SAFETY
TRAFFIC ENGINEERING DESIGN DIVISION

US 40 (W. PATRICK STREET)
AT MCCAIN DRIVE
FREDERICK, MARYLAND

GENERAL INFORMATION SHEET

SCALE NONE DATE FEBRUARY 2013 CONTRACT NO. XX6505185

DESIGNED BY WFW COUNTY FREDERICK
DRAWN BY WFW LOGMILE 10004012.15
CHECKED BY BJG TIMS NO. L536
FAP NO. TOD NO.

TS NO. 1347B-GI DRAWING SP-2 OF 2 SHEET NO. 2 OF 5

PLOTTED: Monday, July 15, 2013 AT 03:28 PM
FILE: \\balsrv03\v2008\2008\08148_toddes\Task 118_US 40 Signals\CADD\L536 (MCCAIN)\pSG-0002_US40@McCain-GI_R1.dgn

BY: WFW