F.H.W.A. REGION NO.	STATE	FED. AID PROJ. NO.	SHEET NO.	TOTAL SHEETS
3	MD.			

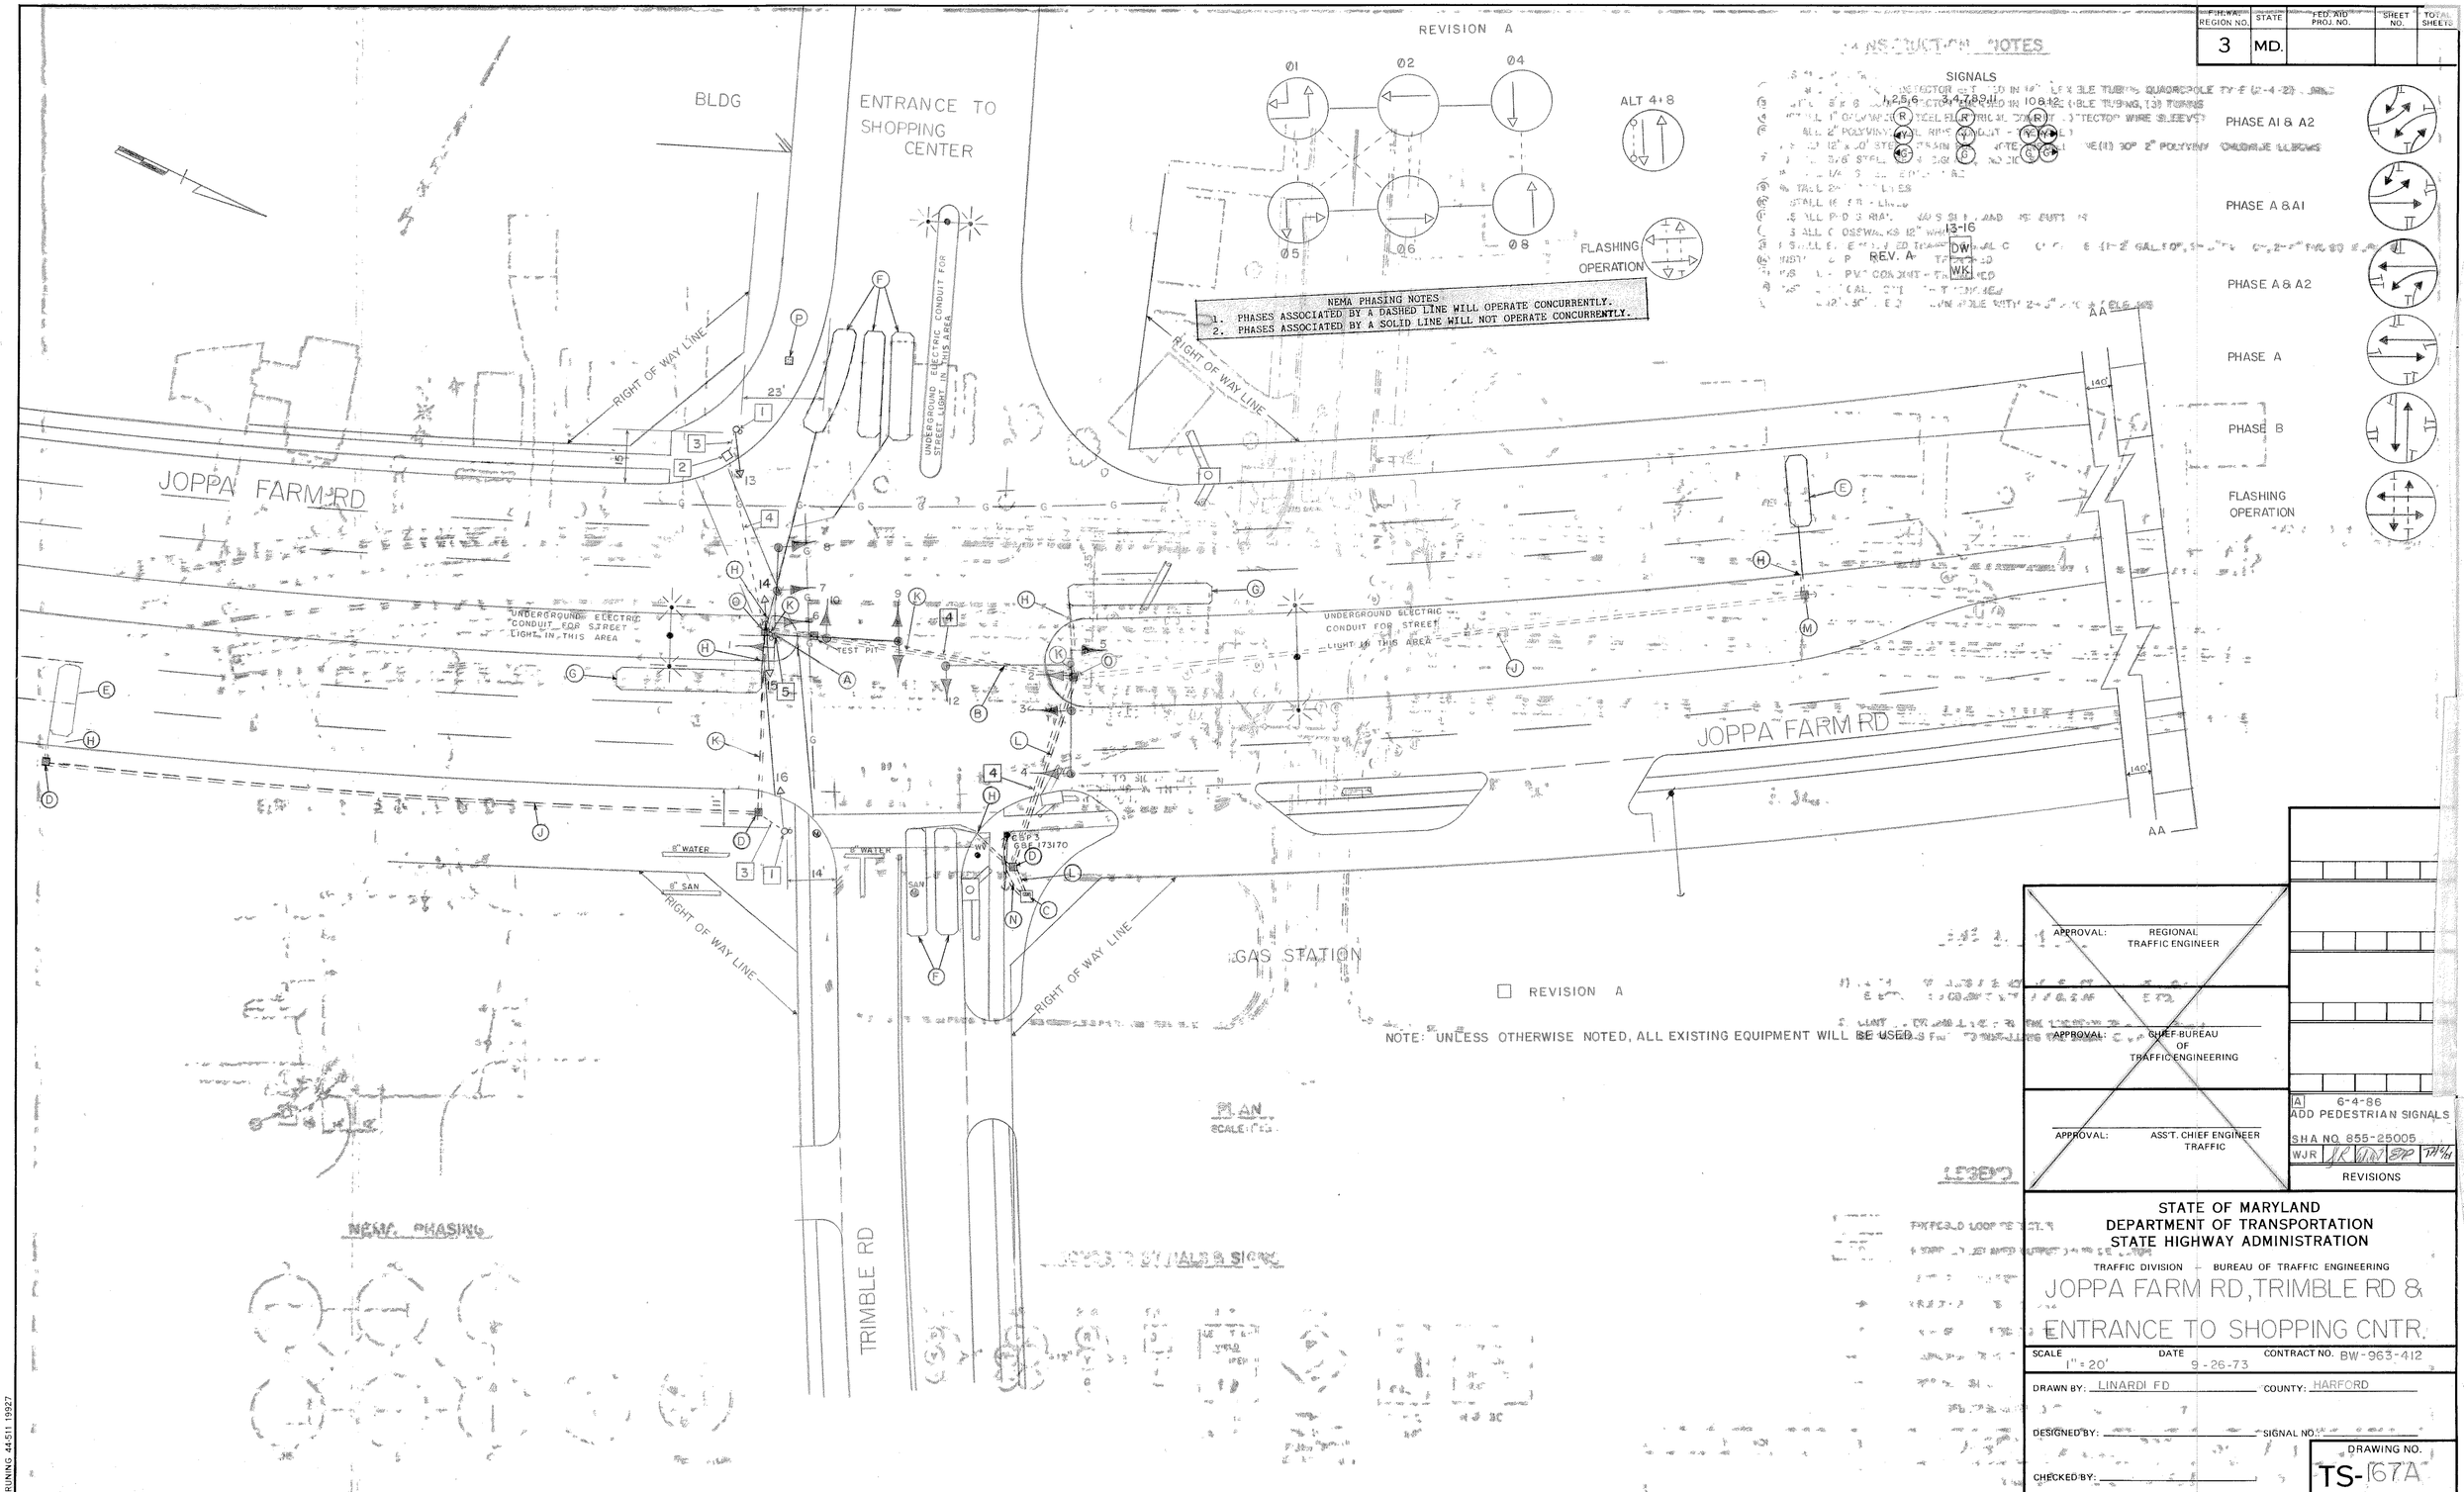

APPROVAL: REGIONAL TRAFFIC ENGINEER

APPROVAL: CHIEF BUREAU OF TRAFFIC ENGINEERING

APPROVAL: ASS'T. CHIEF ENGINEER TRAFFIC

A 6-4-86 ADD PEDESTRIAN SIGNALS

SHA NO. 855-25005

WJR

REVISIONS

STATE OF MARYLAND
DEPARTMENT OF TRANSPORTATION
STATE HIGHWAY ADMINISTRATION

TRAFFIC DIVISION — BUREAU OF TRAFFIC ENGINEERING

JOPPA FARM RD, TRIMBLE RD & ENTRANCE TO SHOPPING CNTR.

SCALE 1" = 20' DATE 9-26-73 CONTRACT NO. BW-963-412

DRAWN BY: LINARDI FD COUNTY: HARFORD

DESIGNED BY: SIGNAL NO.

CHECKED BY:

DRAWING NO. TS-167A

BRUNING 44-511 19927