F.H.W.A. REGION NO.	STATE	FED. AID PROJ. NO.	SHEET NO.	TOTAL SHEETS
3	MD.		5	6

SIGN (AA)

ONLY

R3-5
30"X36"

SIGNALS
31-38
(R)
(Y)
(G)

PHASE 1

PHASE 2

FLASHING OPERATION

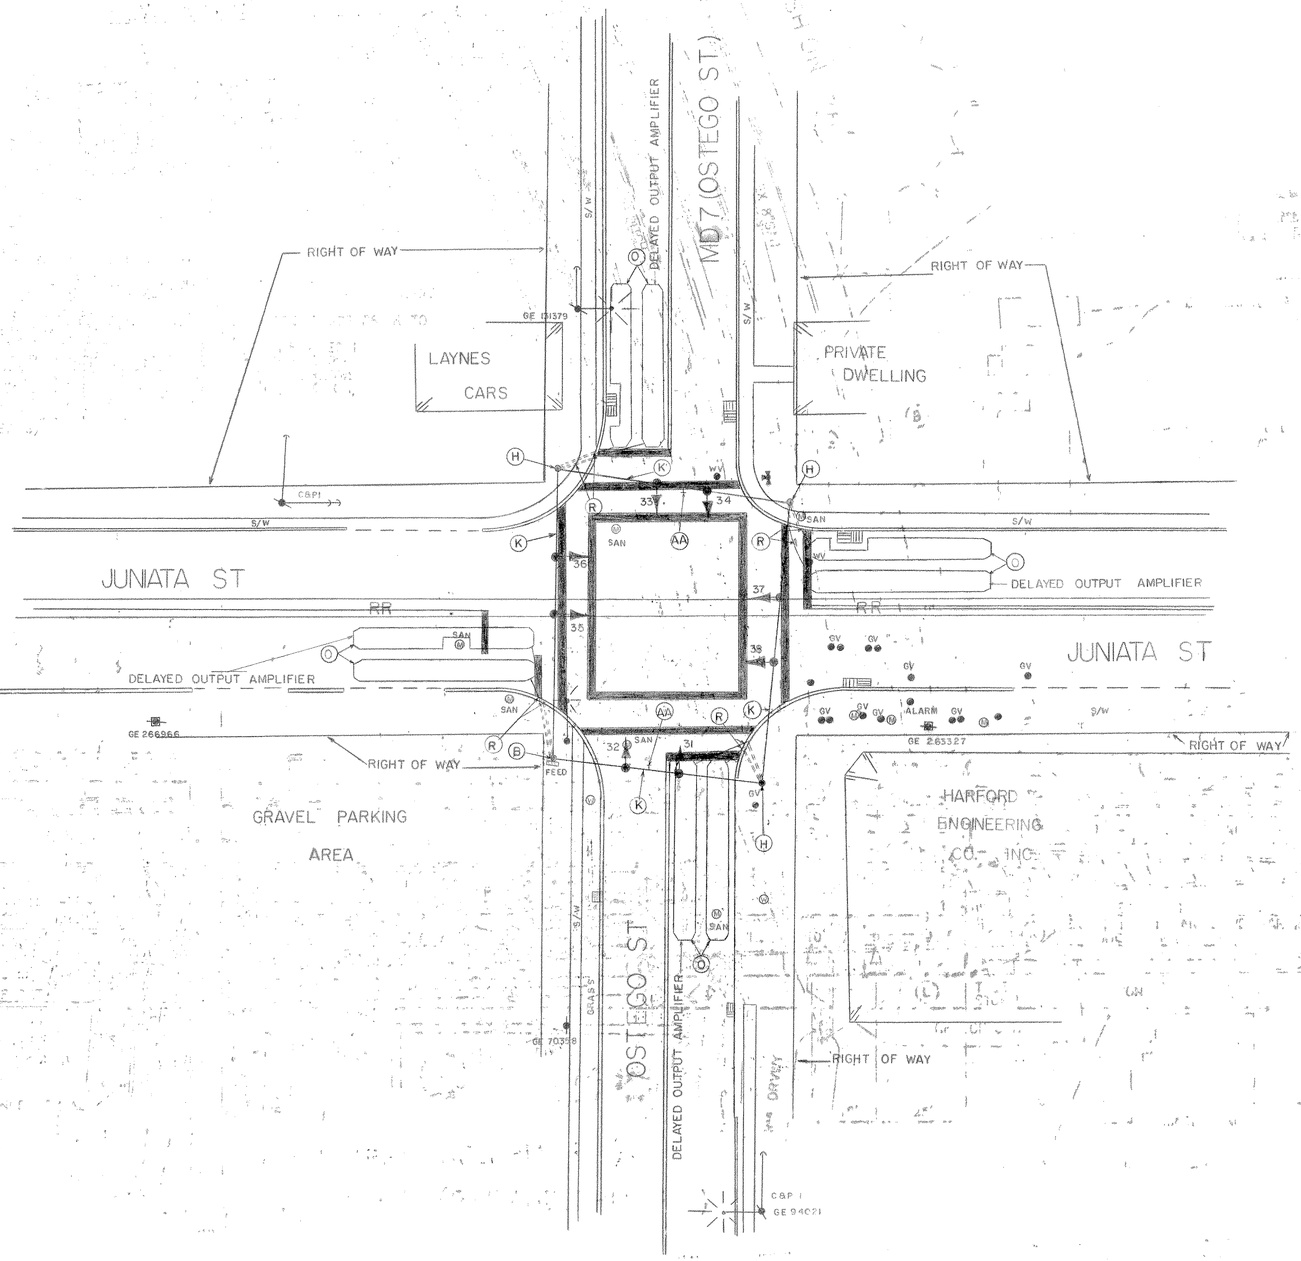

APPROVAL: REGIONAL TRAFFIC ENGINEER 5/12/76

APPROVAL: CHIEF BUREAU OF TRAFFIC ENGINEERING 5/14/76

APPROVAL: ASS'T. CHIEF ENGINEER TRAFFIC 5/14/76

A. ASBUILT 7-13-81

H-710X-000-485

G.T. B.J. 10/13/77

REVISIONS

STATE OF MARYLAND
DEPARTMENT OF TRANSPORTATION
STATE HIGHWAY ADMINISTRATION

TRAFFIC DIVISION – BUREAU OF TRAFFIC ENGINEERING

MD 7 (OSTEGO ST) & JUNIATA ST

SCALE 1" = 20' DATE 8/12/75 CONTRACT NO.

DRAWN BY: B. THOMPSON COUNTY: HARFORD

DESIGNED BY: Bruce Thompson SIGNAL NO.: 12016

CHECKED BY:

DRAWING NO. TS-1084X1A

BRUNING 44511 19927