F.H.W.A. REGION NO.	STATE	FED. AID PROJ. NO.	SHEET NO.	TOTAL SHEETS
3	MD.		3	6

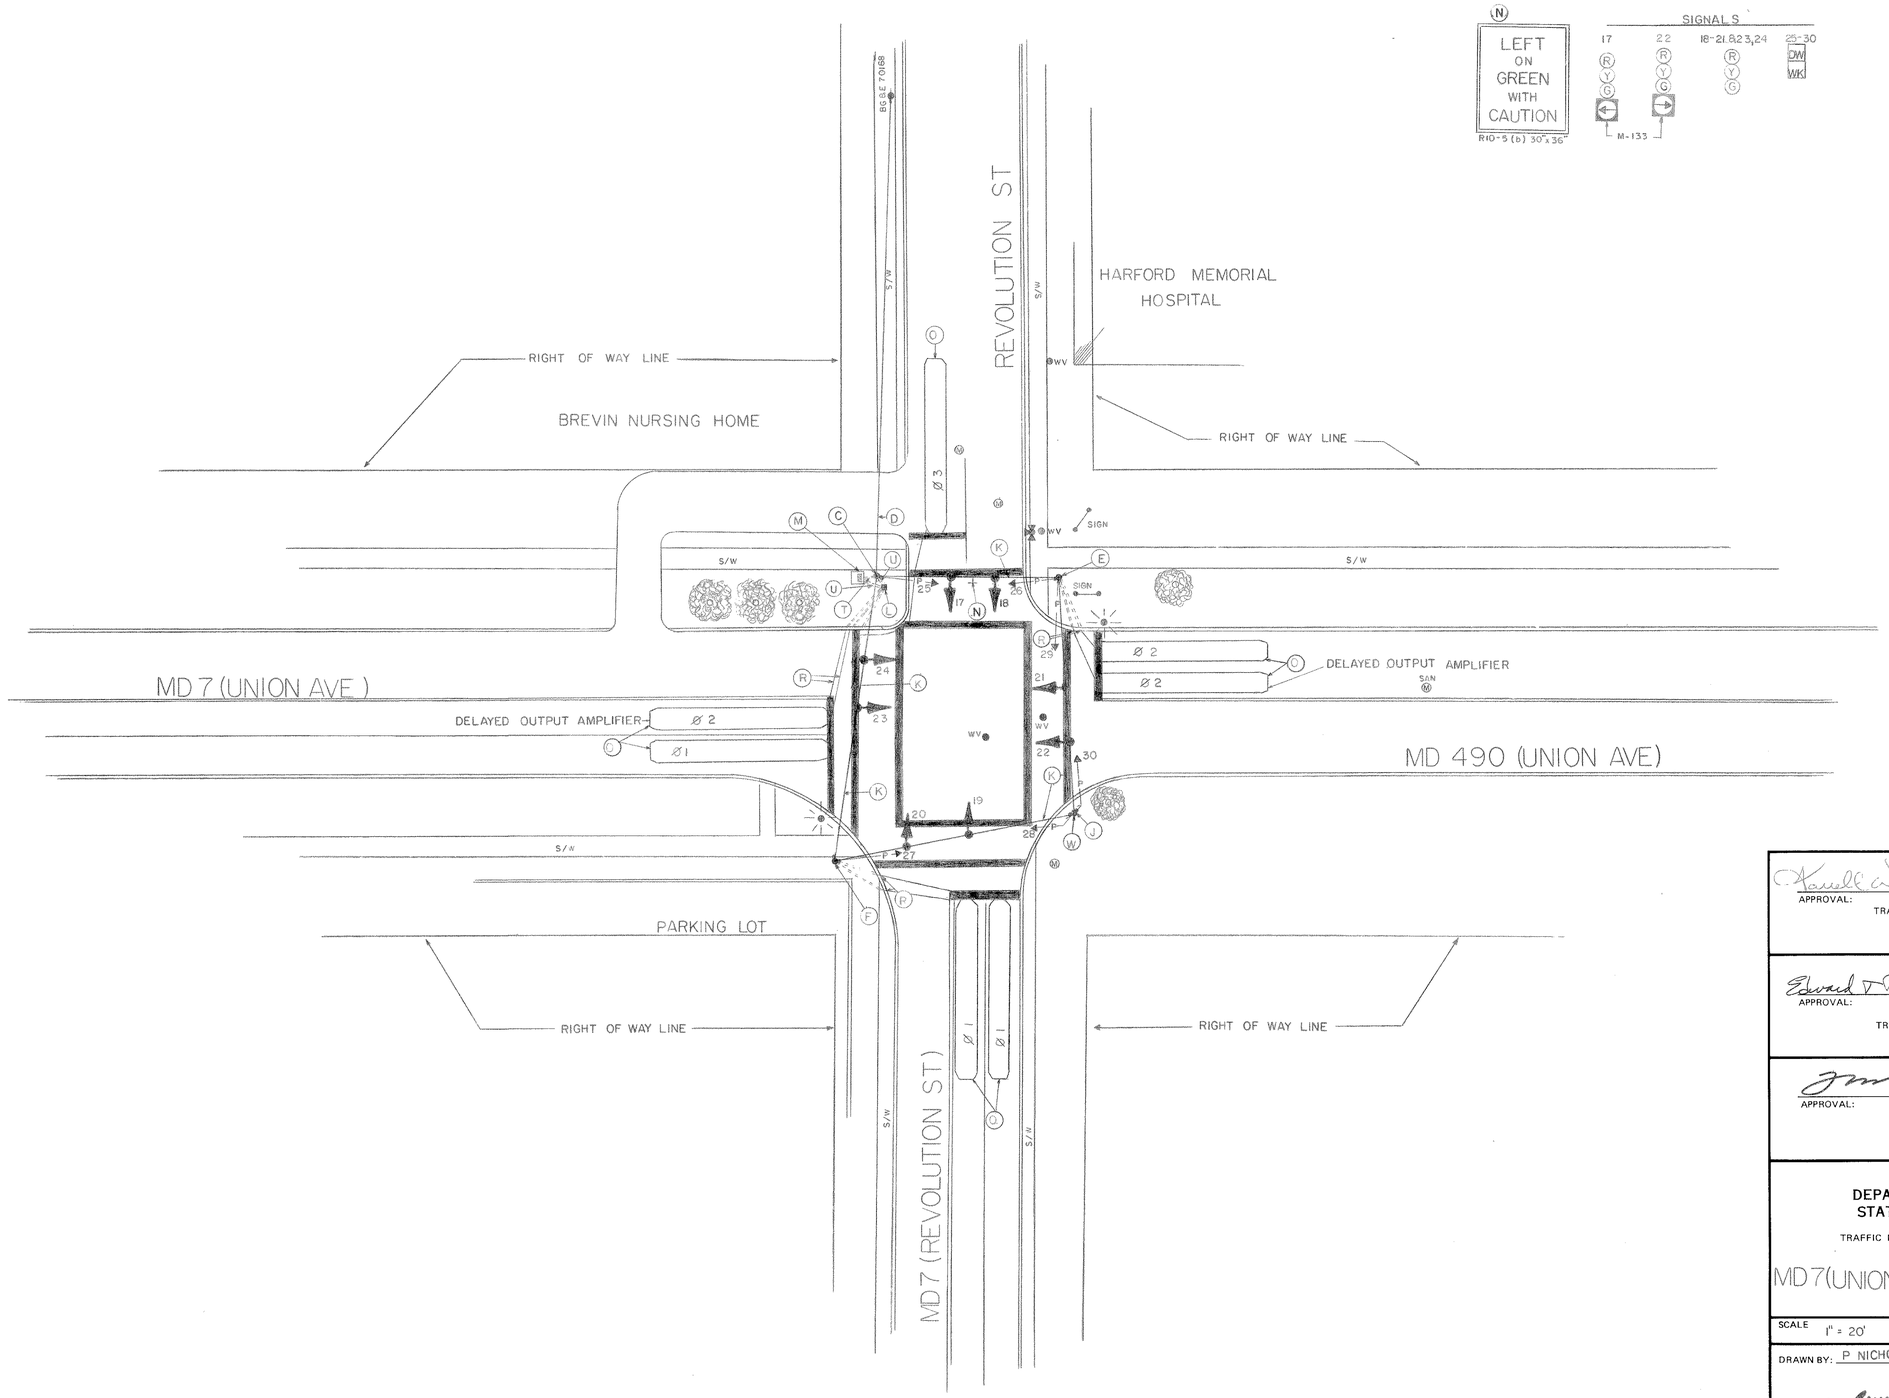

APPROVAL: REGIONAL TRAFFIC ENGINEER — 5/21/76

APPROVAL: CHIEF-BUREAU OF TRAFFIC ENGINEERING — 5/21/76

APPROVAL: ASS'T. CHIEF ENGINEER TRAFFIC — 5/21/76

A. 7-13-81 ASBUILT

H-710X-000-485

G.T.

REVISIONS

STATE OF MARYLAND
DEPARTMENT OF TRANSPORTATION
STATE HIGHWAY ADMINISTRATION

TRAFFIC DIVISION – BUREAU OF TRAFFIC ENGINEERING

MD 7 (UNION AVE) & MD 7 (REVOLUTION STREET)

SCALE 1" = 20' DATE 8-12-75 CONTRACT NO.

DRAWN BY: P NICHOLAS COUNTY: HARFORD

DESIGNED BY: Bruce Thompson SIGNAL NO.: J2017

CHECKED BY: A. Budnichuk

DRAWING NO. TS-1081XIA

BRUNING 44511 19927