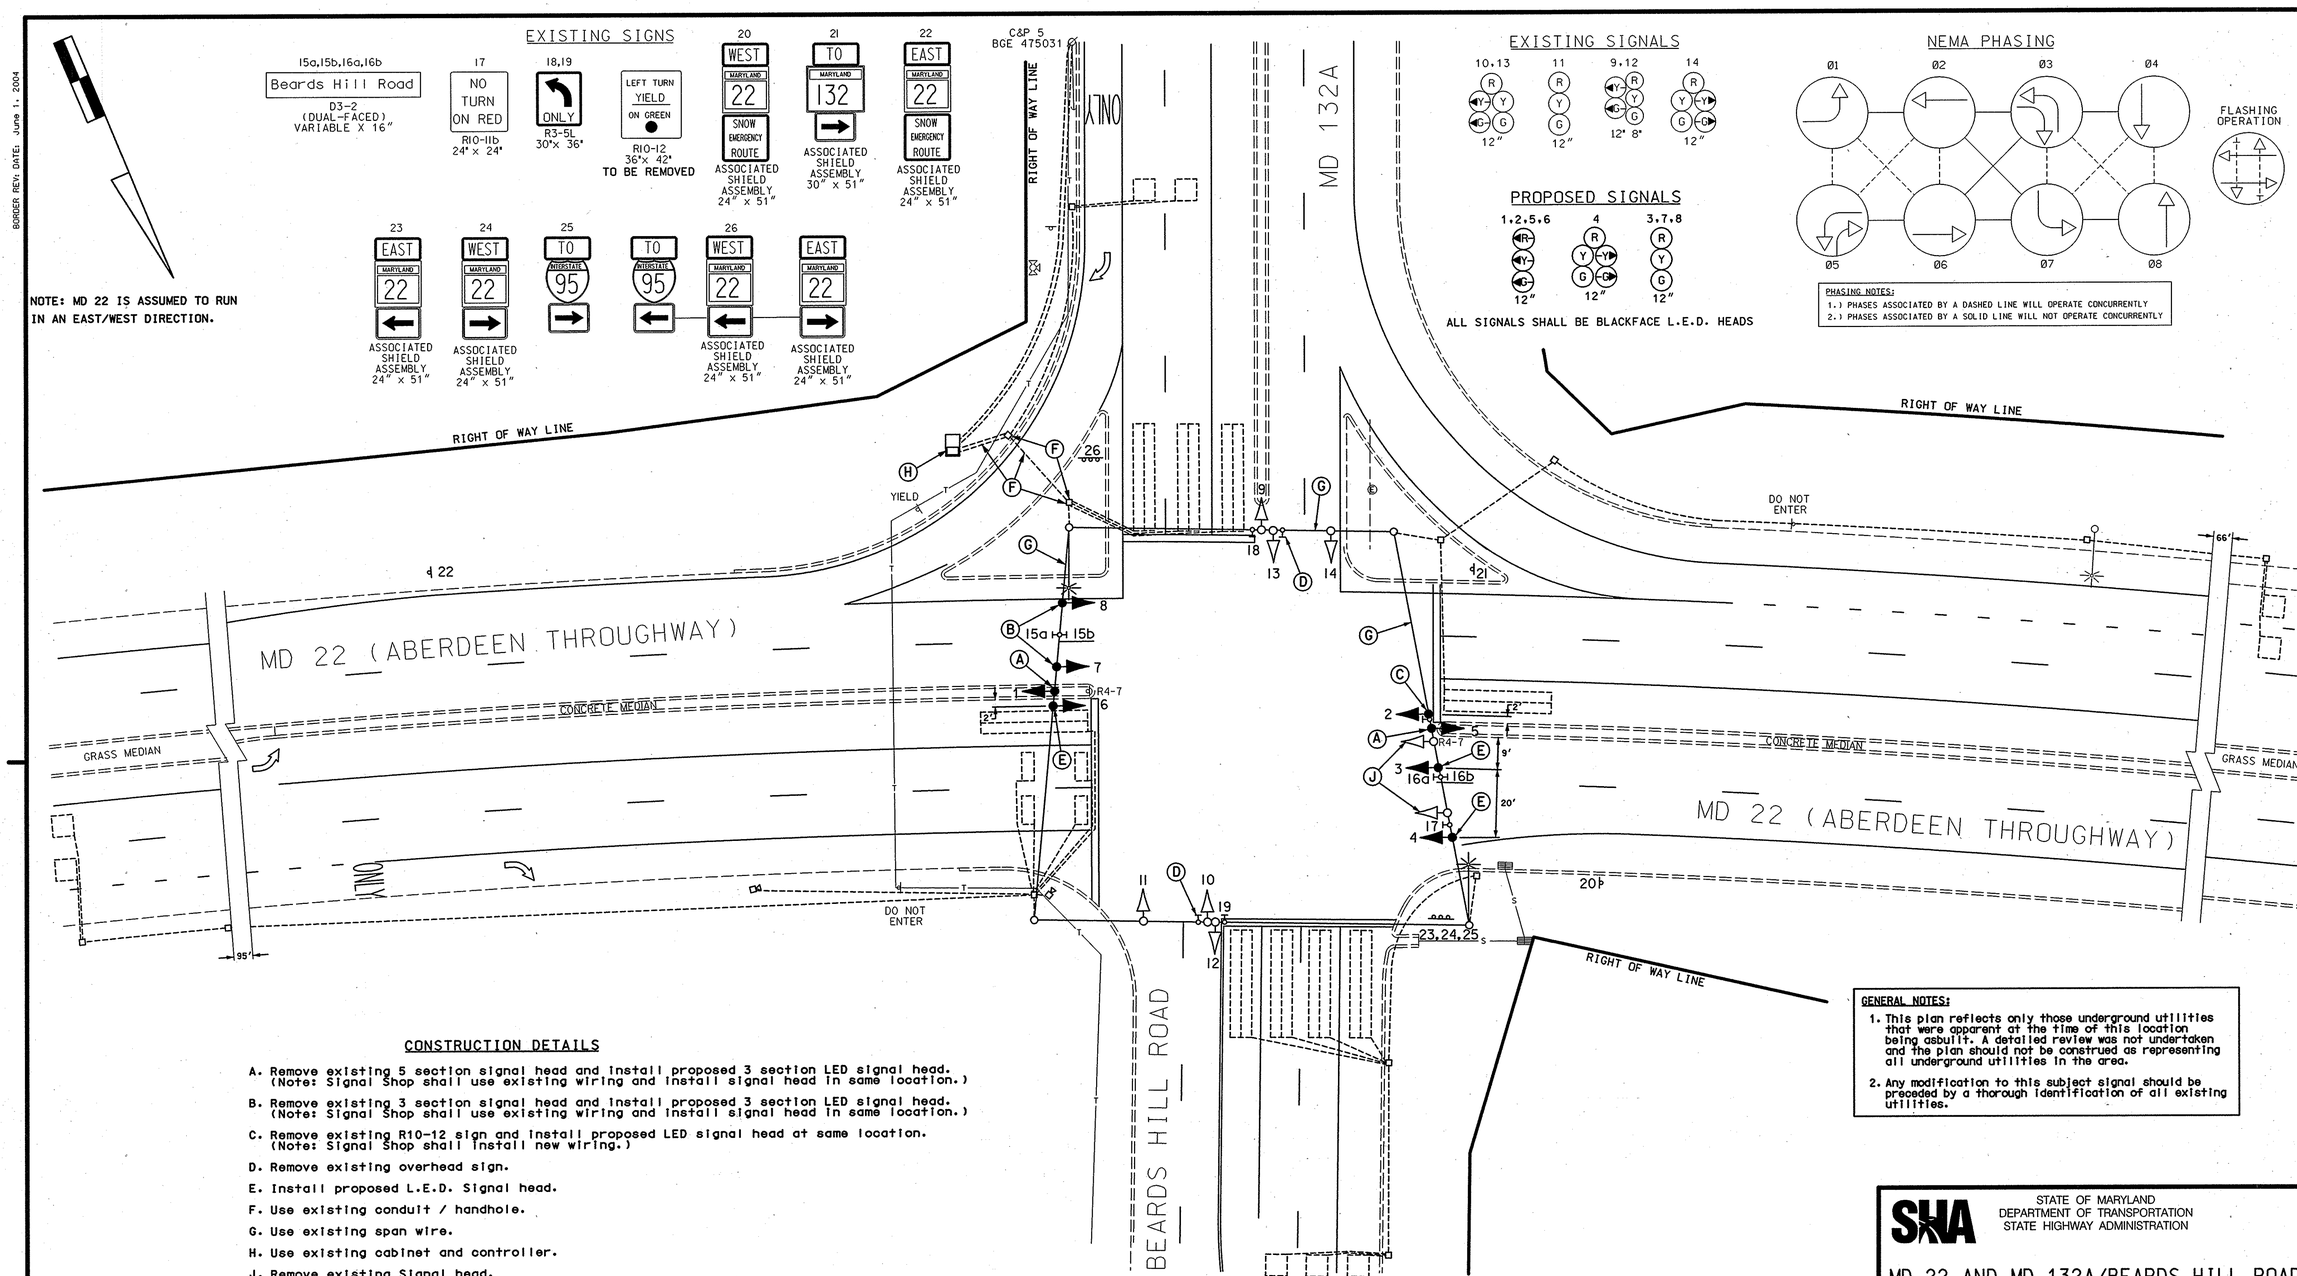

CONSTRUCTION DETAILS

A. Remove existing 5 section signal head and install proposed 3 section LED signal head. (Note: Signal Shop shall use existing wiring and install signal head in same location.)

B. Remove existing 3 section signal head and install proposed 3 section LED signal head. (Note: Signal Shop shall use existing wiring and install signal head in same location.)

C. Remove existing R10-12 sign and install proposed LED signal head at same location. (Note: Signal Shop shall install new wiring.)

D. Remove existing overhead sign.

E. Install proposed L.E.D. Signal head.

F. Use existing conduit / handhole.

G. Use existing span wire.

H. Use existing cabinet and controller.

J. Remove existing Signal head.

GENERAL NOTES:

1. This plan reflects only those underground utilities that were apparent at the time of this location being asbuilt. A detailed review was not undertaken and the plan should not be construed as representing all underground utilities in the area.
2. Any modification to this subject signal should be preceded by a thorough identification of all existing utilities.

GEOMETRIC LEGEND

PROPOSED
EXISTING

LEGEND OF UNDERGROUND AND OVERHEAD UTILITIES

AERIAL CABLE	A	A
ELECTRIC	E	E
TELEPHONE	T	T
GAS	G	G
SEWER	S	S
WATER	W	W
CABLE TV	TV	TV

REVISION "G"

STREET TRAFFIC STUDIES, LTD.
400 Crain Hwy.NW.
Glen Burnie,MD 21061
Ph (410) 590-5500
Fax (410) 590-6637

5330.dgn T-100

APPROVALS	
TEAM LEADER	ORIGINAL ON FILE
ASST. DIV. CHIEF	
DIVISION CHIEF	
OFFICE DIRECTOR	

REVISIONS

G 2-28-07	CHANGE E/P TO EXCLUSIVE LEFT TURN ON MD 22 APPROACHES SIGNAL SHOP FORCES
JWA	
F 2-12-02	ASBUILT FOR RED LIGHT CAMERA INSTALLATION
RRZ	
E	RED LIGHT CAMERA WB MD 22

PLOTTED: $DATETIME$
FILE: $FILE$

SHA
STATE OF MARYLAND
DEPARTMENT OF TRANSPORTATION
STATE HIGHWAY ADMINISTRATION

MD 22 AND MD 132A/BEARDS HILL ROAD

TRAFFIC SIGNAL PLAN

SCALE 1"= 20' DATE _____ CONTRACT NO. BW313M83

DESIGNED BY _____ COUNTY HARFORD
DRAWN BY ALAN HOFFMAN ASH LOGMILE 12002210.30
CHECKED BY E.M.M. TIMS NO. I233
F.A.P. NO. _____ TOD NO. _____

TS NO. 110F | DRAWING NO. 1 OF | SHEET NO. OF

DRILL HOLES
DRILL HOLES
DRILL HOLES

BORDER REV: DATE: June 1, 2004

\5000's\5330\5330.dgn Feb. 27, 2007 16:19:41