F.H.W.A. REGION NO.	STATE	FED. AID PROJ. NO.	SHEET NO.	TOTAL SHEETS
3	MD.			

NORMAL OPERATION	OUT	OUT
ACTUATED OPERATION	FL/Y	FL/Y

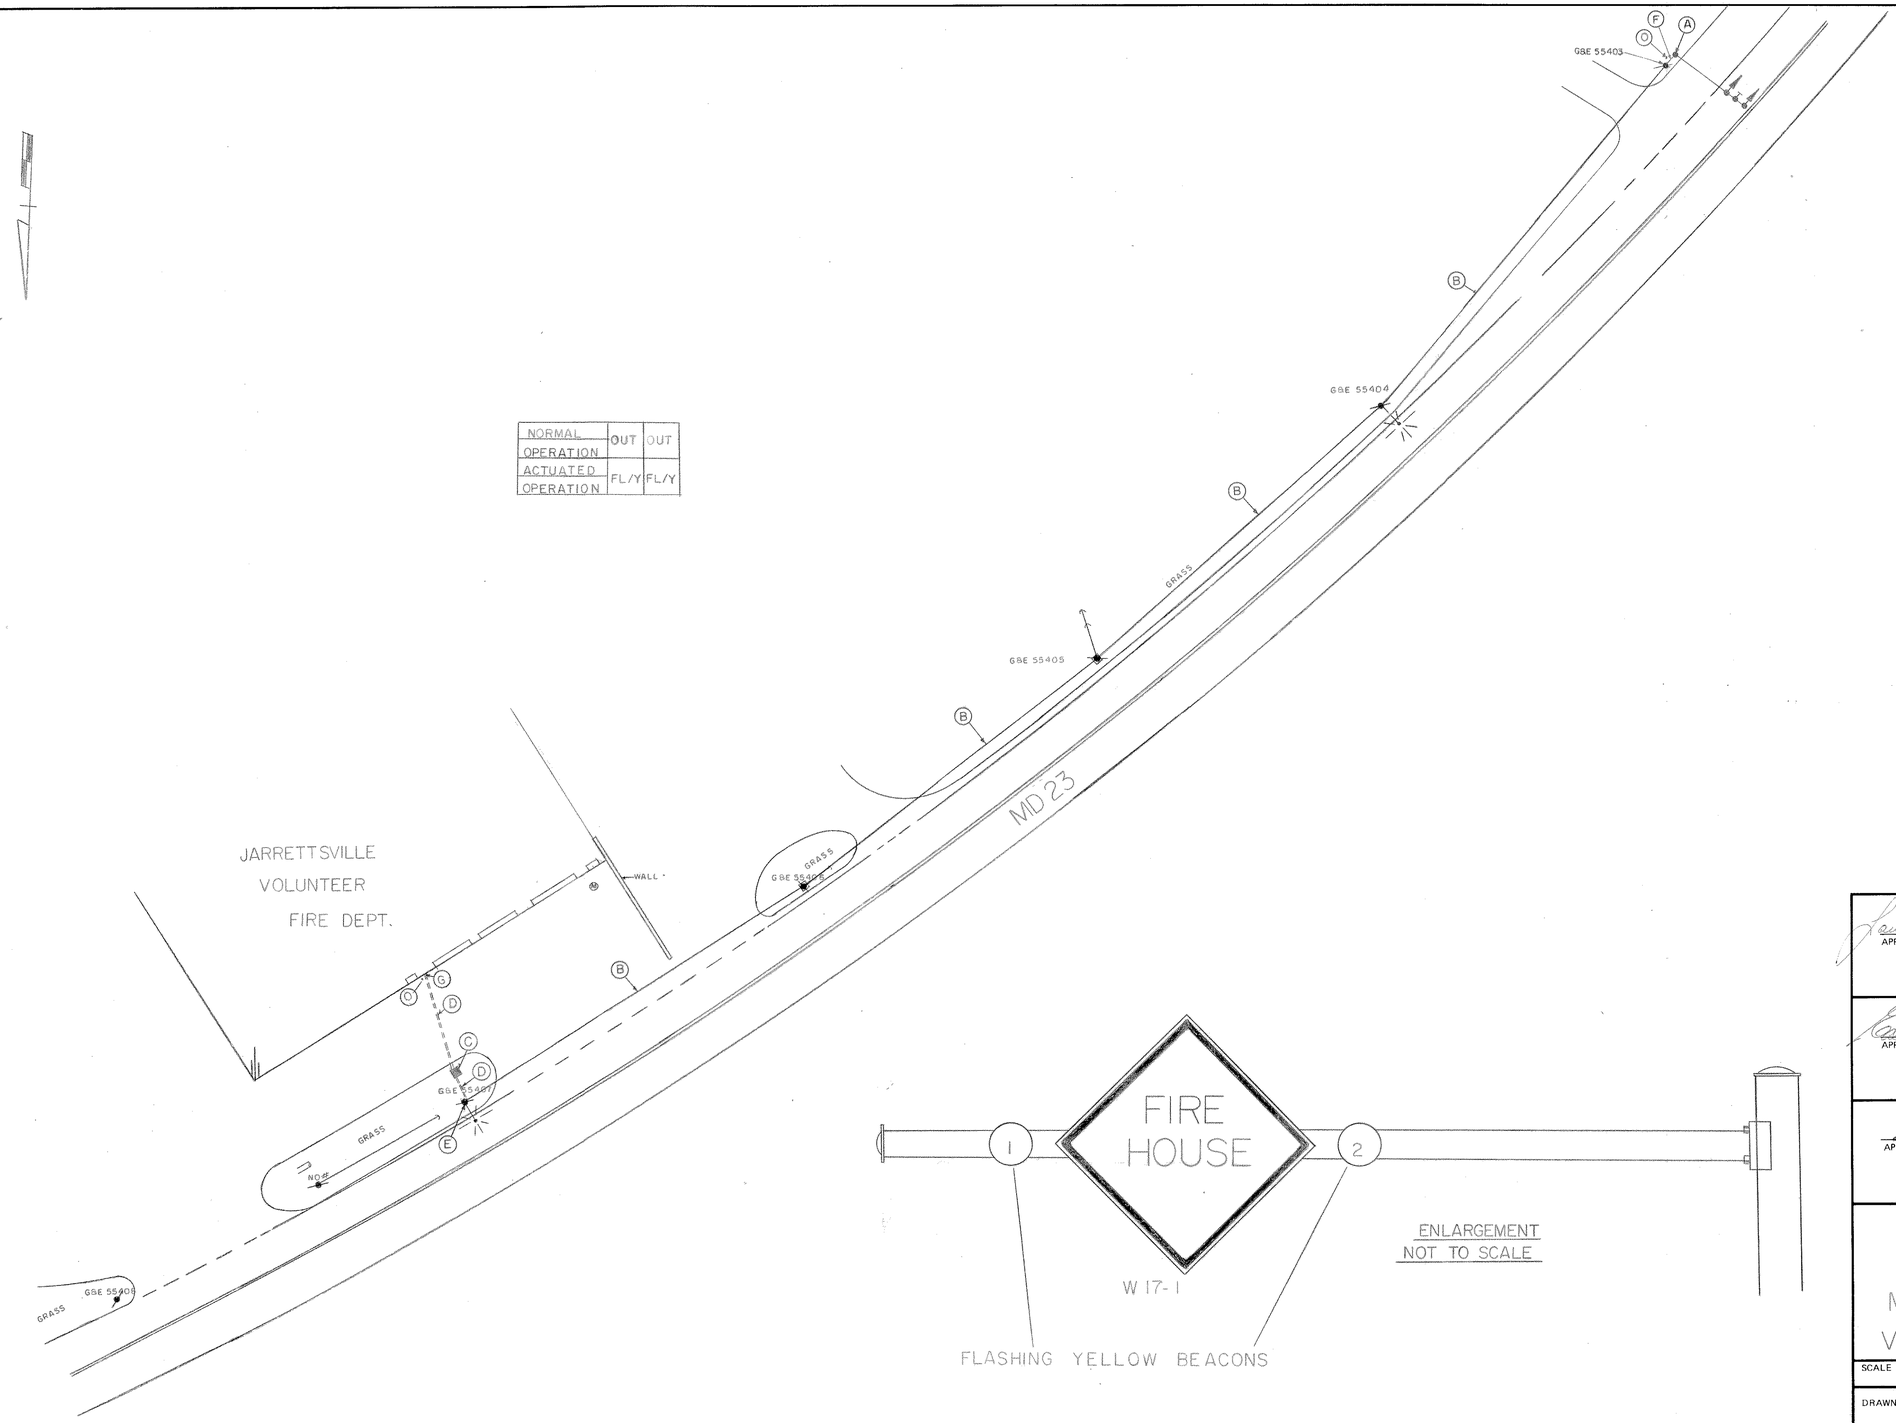

APPROVAL: REGIONAL TRAFFIC ENGINEER — 12/3/73

APPROVAL: CHIEF BUREAU OF TRAFFIC ENGINEERING — 12/11/73

APPROVAL: ASS'T. CHIEF ENGINEER TRAFFIC — 12/5/73

1-21-81 ASBUILT

CONTRACT NO H663X 465

TMZ

REVISIONS

STATE OF MARYLAND
DEPARTMENT OF TRANSPORTATION
STATE HIGHWAY ADMINISTRATION

TRAFFIC DIVISION — BUREAU OF TRAFFIC ENGINEERING

MD 23 AT JARRETTSVILLE VOLUNTEER FIRE DEPT

SCALE 1" = 20' DATE 9-20-73 CONTRACT NO. H 663X-485

DRAWN BY: DEBELIUS COUNTY: HARFORD

DESIGNED BY: Cedric F. Bradley SIGNAL NO.:

CHECKED BY: A Budnichuk

DRAWING NO. TS-987A

BRUNING 44-511 19927