F H WA REGION NO	STATE	FED. AID PROJ. NO	SHEET NO.	TOTAL SHEETS
3	MD.		1	1

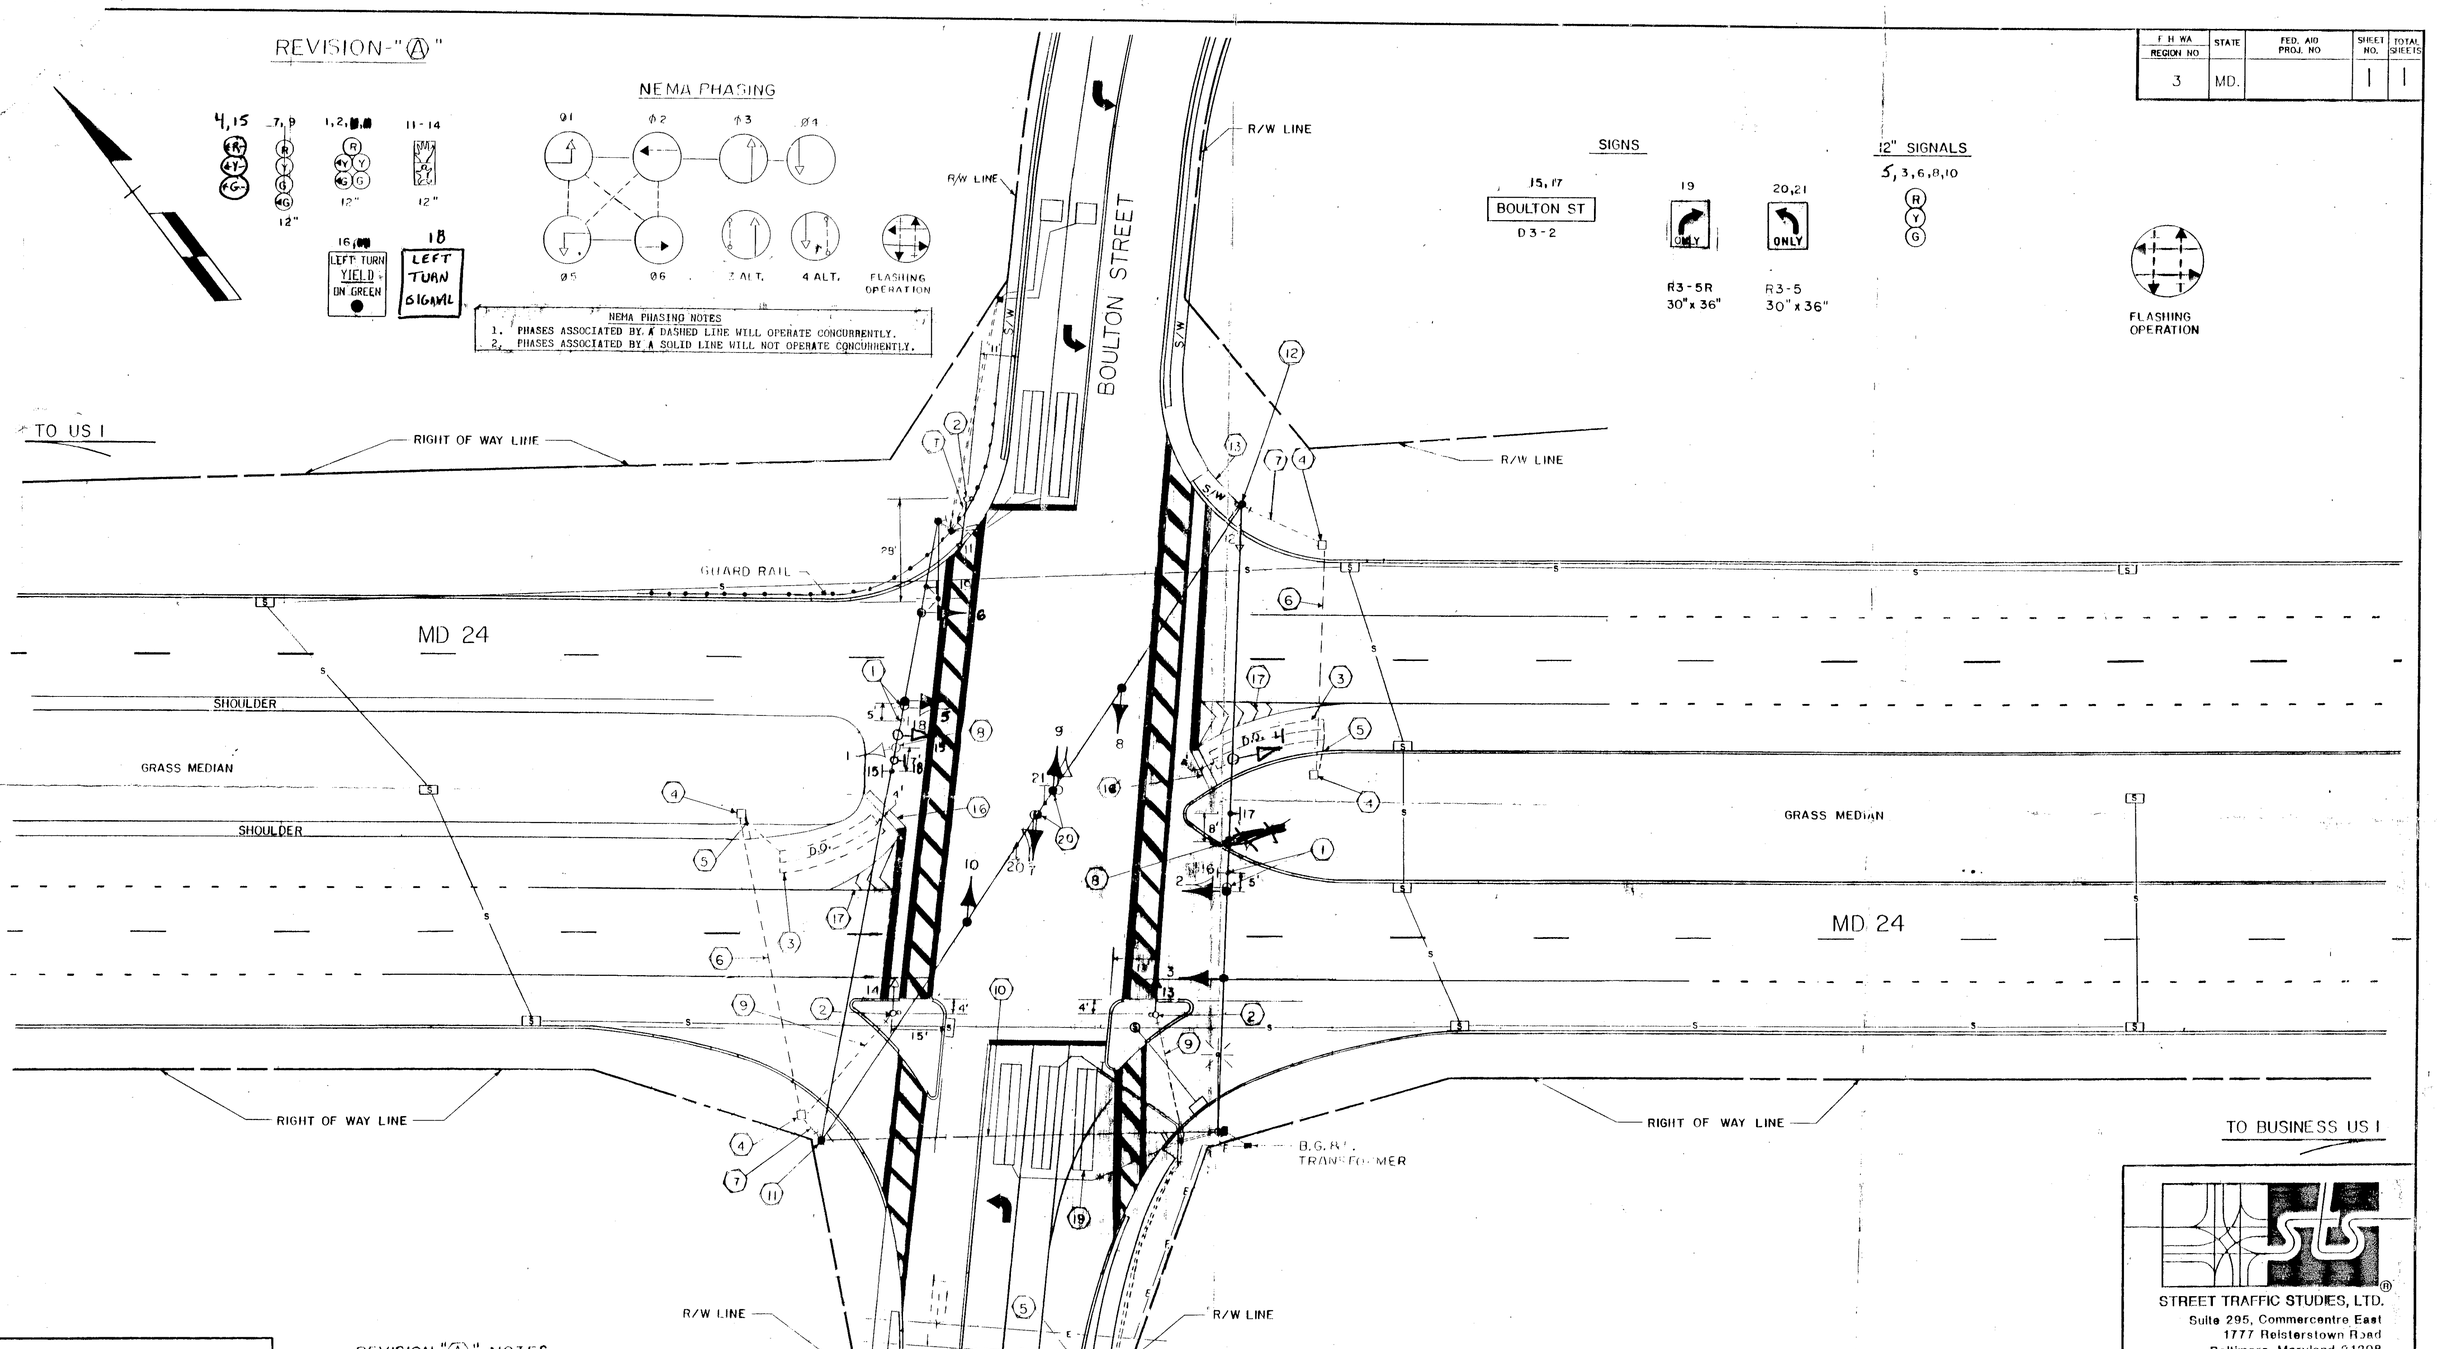

STREET TRAFFIC STUDIES, LTD.
Suite 295, Commercentre East
1777 Reisterstown Road
Baltimore, Maryland 21208

LEGEND OF UNDERGROUND AND OVERHEAD UTILITIES

AERIAL CABLE	A — A — A — A
ELECTRIC	E — E — E — E
TELEPHONE	T — T — T — T
GAS	G — G — G — G
SEWER	S — S — S — S
WATER	W — W — W — W
CABLE TV	TV — TV — TV — TV

REVISION "Ⓐ" NOTES:

1). REVISION "A" IS A MODIFICATION TO THE ORIGINAL CONTRACT S.H.A. #H-520-501-470 DATED 10/87
2). MYLAR COPY OF THE ORIGINAL IS ON FILE

REVISIONS	APPROVALS
	CHIEF, SIGNAL DESIGN SECTION 10/30/87
	ASST. DISTRICT ENGINEER, TRAFFIC 10/30/87
	CHIEF, BUREAU OF TRAFFIC ENGINEERING 11-2-87
Ⓐ 6/88-E/P LT. & ALT. PEDS. S.H.A. #07-1-88	DEPUTY CHIEF ENGINEER, OFFICE OF TRAFFIC 11/2/87

MARYLAND DEPARTMENT OF TRANSPORTATION
STATE HIGHWAY ADMINISTRATION – OFFICE OF TRAFFIC
BUREAU OF TRAFFIC ENGINEERING

DRAWN BY S. THACKER (FOR STS)
DES. BY: R. ZACHERL (FOR STS)
CHK. BY: Emm 10-30-87

RELOCATED MD 24 AND RELOCATED BOULTON STREET

COUNTY: HARFORD

DATE: 10-28-87 F.A.P. NO.
SCALE: 1" = 20' S.H.A. NO.

TS/FILE NO. 2386A SHEET NO. 1

120024 09.28

F#27