K&E BALTIMORE 17 0153 PHOENIX 10-75 MC 4156+

REGION NO.	STATE	PROJ. NO.	NO.	SHEETS
3	MD.	M-000S(17)	12	19

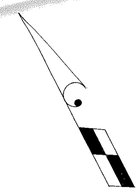

SIGNS

8" SIGNALS

9" SIGNALS

PHASING

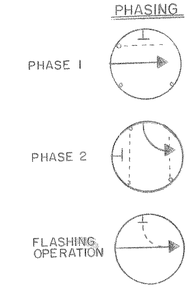

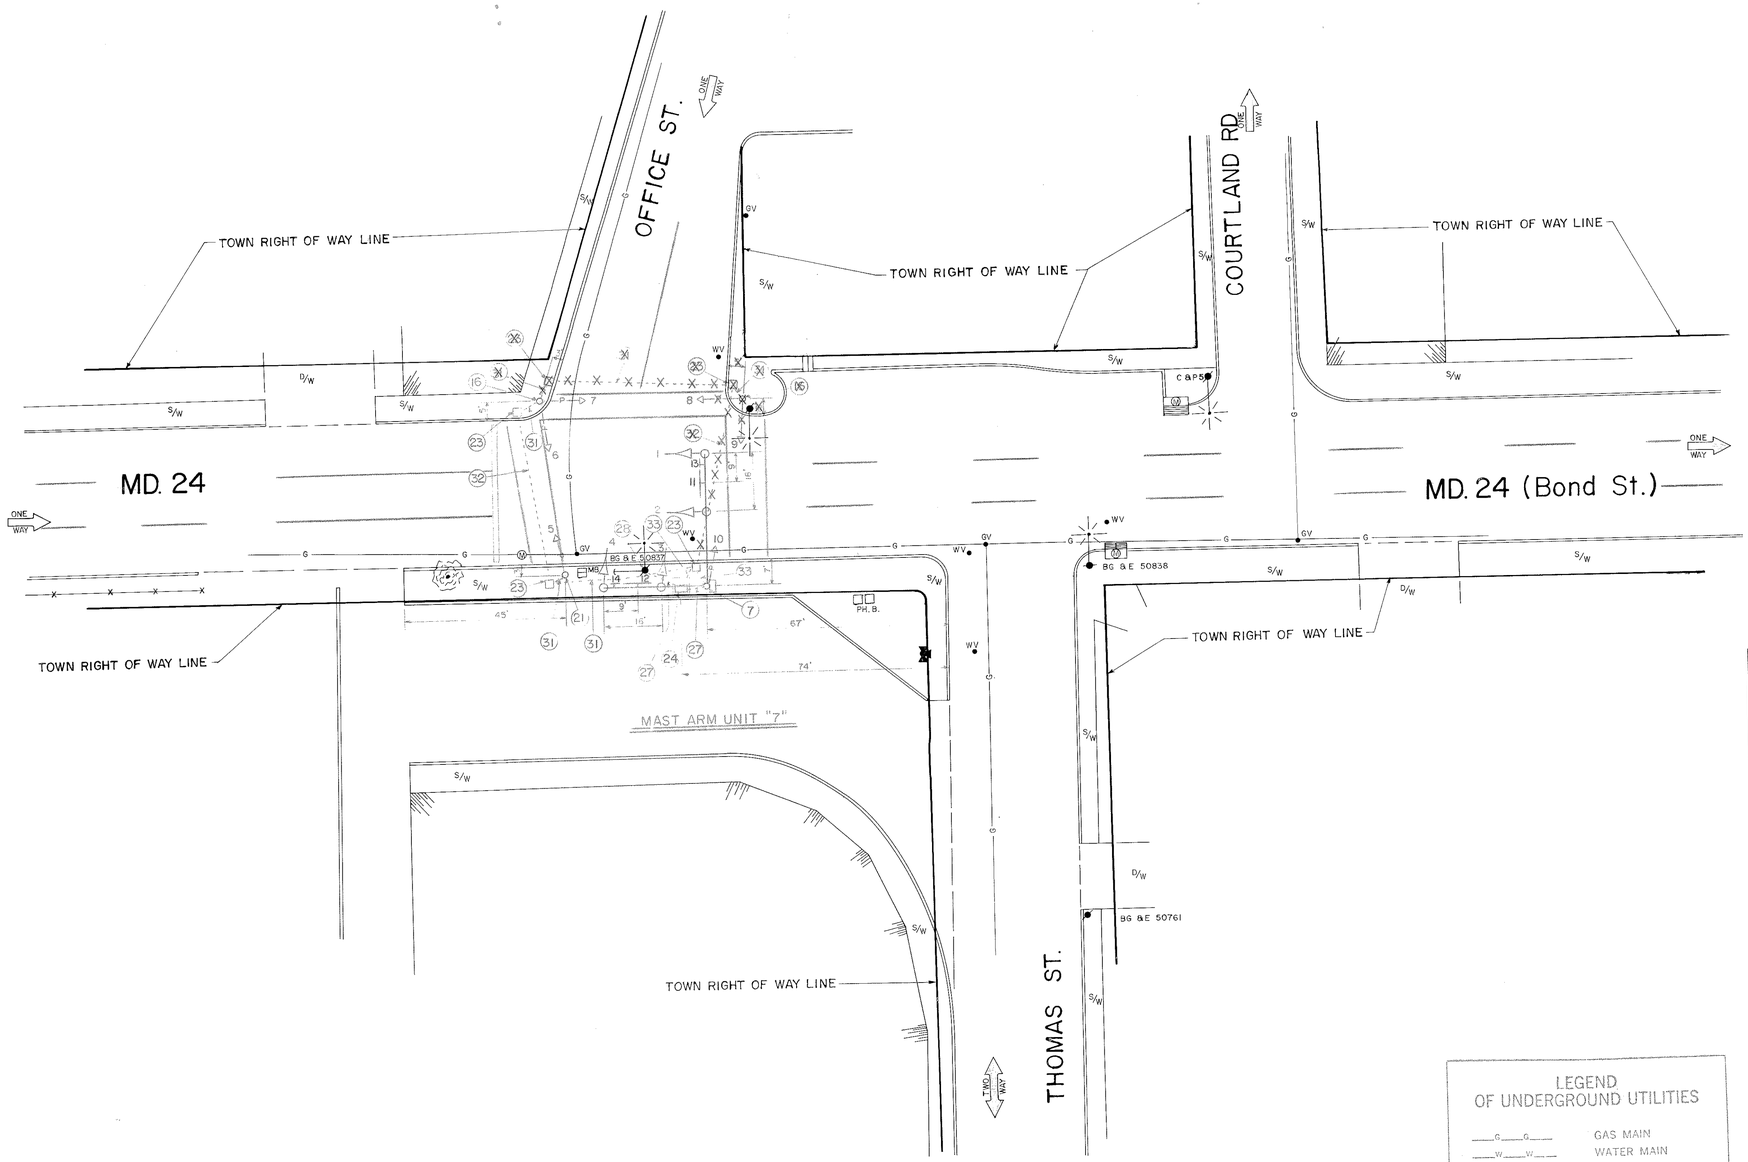

LEGEND
OF UNDERGROUND UTILITIES

G G	GAS MAIN
W W	WATER MAIN
S S	SEWER MAIN
E E	ELECTRIC CABLES
T T	TELEPHONE CABLES
A A	AERIAL CABLES

APPROVAL: REGIONAL TRAFFIC ENGINEER

APPROVAL: CHIEF-BUREAU OF TRAFFIC ENGINEERING

APPROVAL: ASS'T. CHIEF ENGINEER TRAFFIC

K	JAN 29 1982	ADD SIGNS NO 13 & 14
B	JAN. 8, 1981	DELETE PEDESTAL POLE & SIGNAL DUE TO CONSTRUCTION

REVISIONS

STATE OF MARYLAND
DEPARTMENT OF TRANSPORTATION
STATE HIGHWAY ADMINISTRATION

TRAFFIC DIVISION – BUREAU OF TRAFFIC ENGINEERING

MD. 24 (Bond St.) & OFFICE ST.

SCALE 1"=20' DATE 8-17-74 CONTRACT NO. H-757-501-485 F.A.P. NO. M-000S(17)

DRAWN BY: H KILIAN COUNTY: HARFORD

DESIGNED BY: Howard J. Kilian Jr. SIGNAL NO.:

CHECKED BY:

DRAWING NO. TS-1478K

1209240516 2