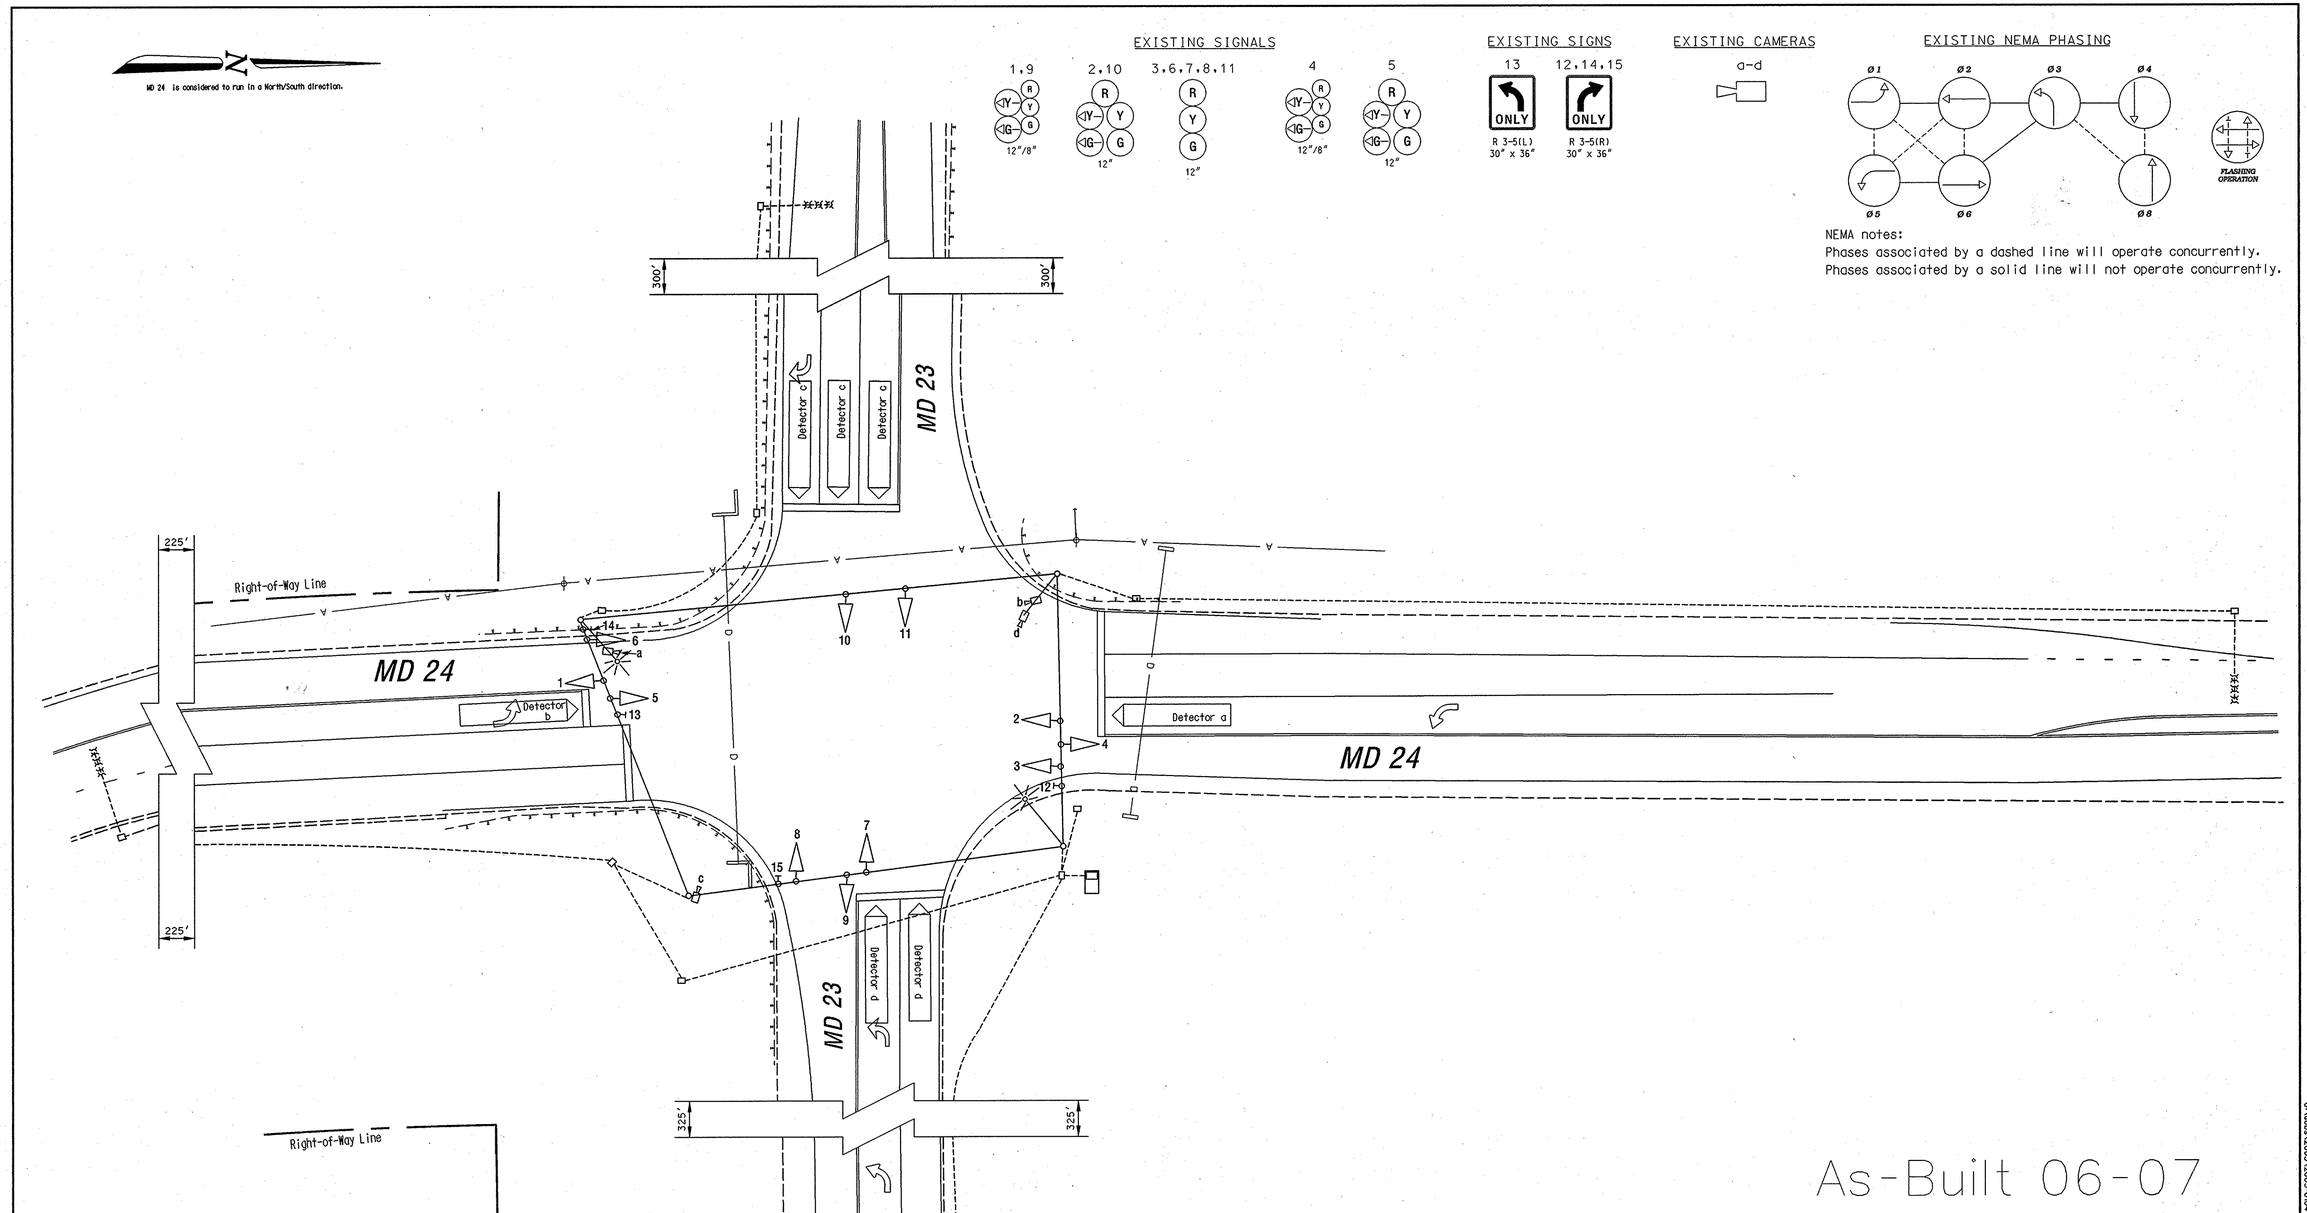

As-Built 06-07

GEOMETRIC LEGEND

EXISTING GEOMETRICS

PROPOSED GEOMETRICS

UTILITY LEGEND

G	GAS MAIN
W	WATER MAIN
S	SEWER MAIN
E	ELECTRIC CABLES
D	STORM DRAIN
A	AERIAL CABLES
T	TELEPHONE CABLES

The Traffic Group

The Traffic Group, Inc.
410-931-6600
Fax 410-931-6601

REVISIONS

As-Built	June 27, 2007
SED	
© Add left turn lane to Eastbound MD 23 S.H.A. No.:BW996M82	Sept. 8, 2006
FJH	
B Modifications due to geometric changes	June , 2003
EJH	
A Modifications... S.H.A. No.:H853-501-467	July 18, 1985
SAR / WJR	

APPROVALS

ORIGINAL ON FILE

TEAM LEADER, TRAFFIC ENGINEERING DESIGN DIVISION

ASST. CHIEF TRAFFIC ENGINEERING DESIGN DIVISION

CHIEF, TRAFFIC ENGINEERING DESIGN DIVISION

DIRECTOR, TRAFFIC & SAFETY

MARYLAND DOT - STATE HIGHWAY ADMINISTRATION

Office of Traffic & Safety

TRAFFIC ENGINEERING DESIGN DIVISION

(Traffic Signal Plan)

MD 24 (Rock Spring Road) at MD 23 (East-West Highway)

DRAWN BY:	WJR	F.A.P. NO.	N/A	TS NO. 109-C	SHEET NO.
CHECKED BY:	SAR	S.H.A. NO.			
SCALE:	1" = 20'	COUNTY:	Harford	T.I.M.S. NO. H-942	1 OF 1
DATE:	July 18, 1975	LOG MILE:	12002301.88		

o:\Jobs\2005\2005-0104\Bel-Air North Village\As-built-2.dgn 7/19/2007