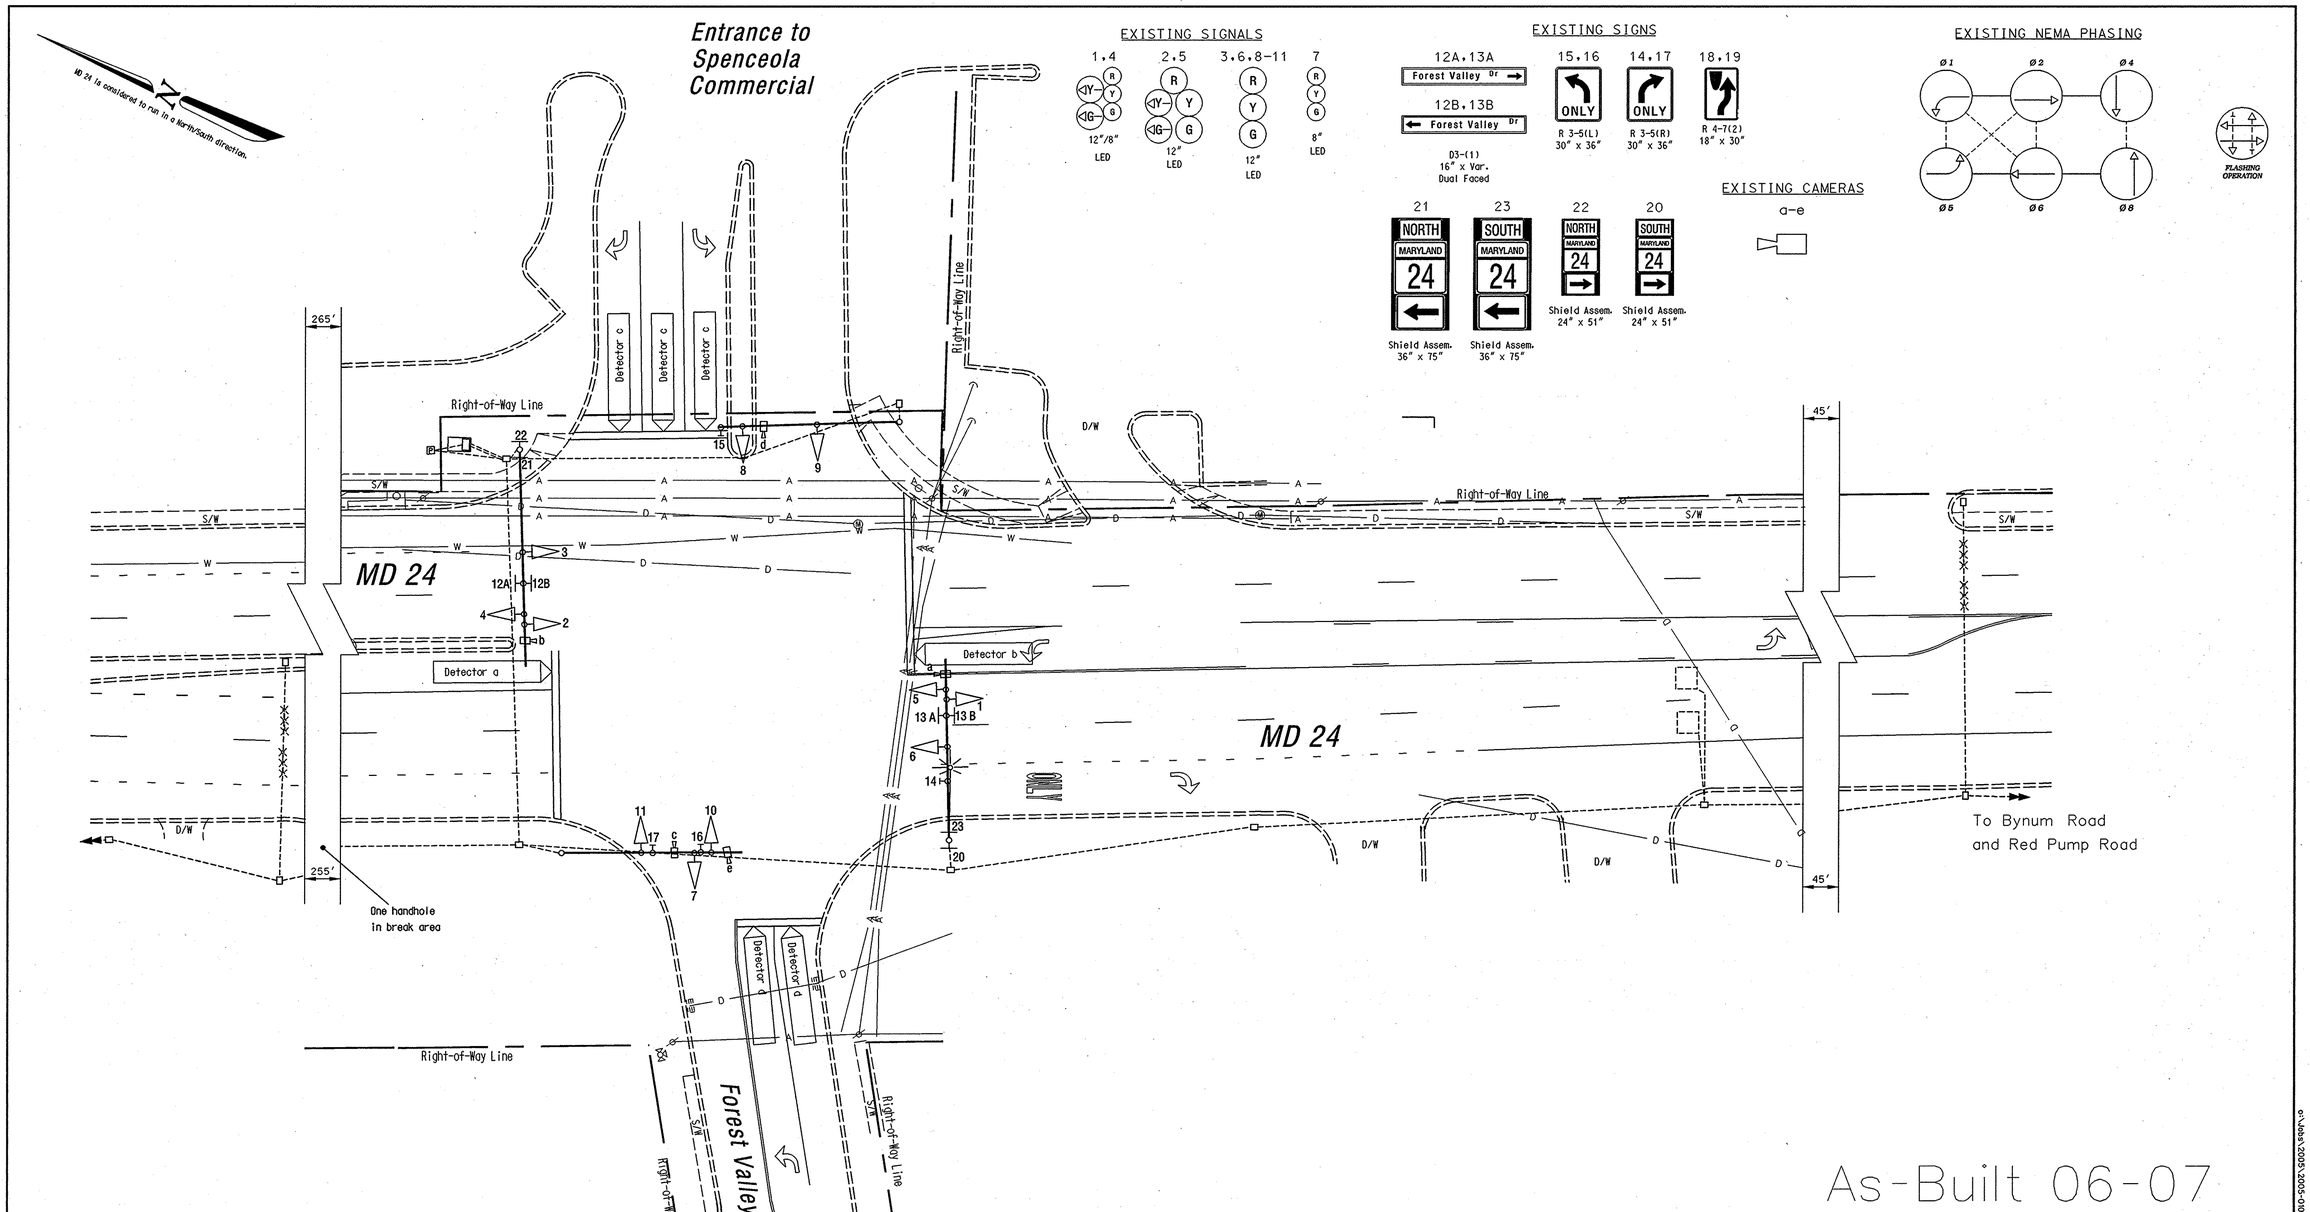

As-Built 06-07

GEOMETRIC LEGEND

EXISTING GEOMETRICS

PROPOSED GEOMETRICS

UTILITY LEGEND

G	GAS MAIN
W	WATER MAIN
S	SEWER MAIN
E	ELECTRIC CABLES
D	STORM DRAIN
A	AERIAL CABLES
T	TELEPHONE CABLES

The Traffic Group

The Traffic Group, Inc.
410-931-6600
Fax: 410-931-6601

REVISIONS

As-Built June 27, 2007

SED

APPROVALS

TEAM LEADER, TRAFFIC ENGINEERING DESIGN DIVISION

ASST. CHIEF TRAFFIC ENGINEERING DESIGN DIVISION

CHIEF, TRAFFIC ENGINEERING DESIGN DIVISION

DIRECTOR, TRAFFIC & SAFETY

Original on File

MARYLAND DOT - STATE HIGHWAY ADMINISTRATION

Office of Traffic & Safety

TRAFFIC ENGINEERING DESIGN DIVISION

(Traffic Signal Plan)

MD 24 at Forest Valley Dr./ Entr. Spenceola Commercial

DRAWN BY:	Frank Hoeckel	F.A.P. NO.	N/A	TS NO. 4513	SHEET NO.
CHECKED BY:		S.H.A. NO.	BW996M82		
SCALE:	1" = 20'	COUNTY:	Harford	T.I.M.S. NO. 1031	1 OF 1
DATE:	Sept. 11, 2006	LOG MILE:	12024011.87		

e:\Jobs\2005\2005-004\Bel-Air North Village\As-built-1.dgn 7/18/2007