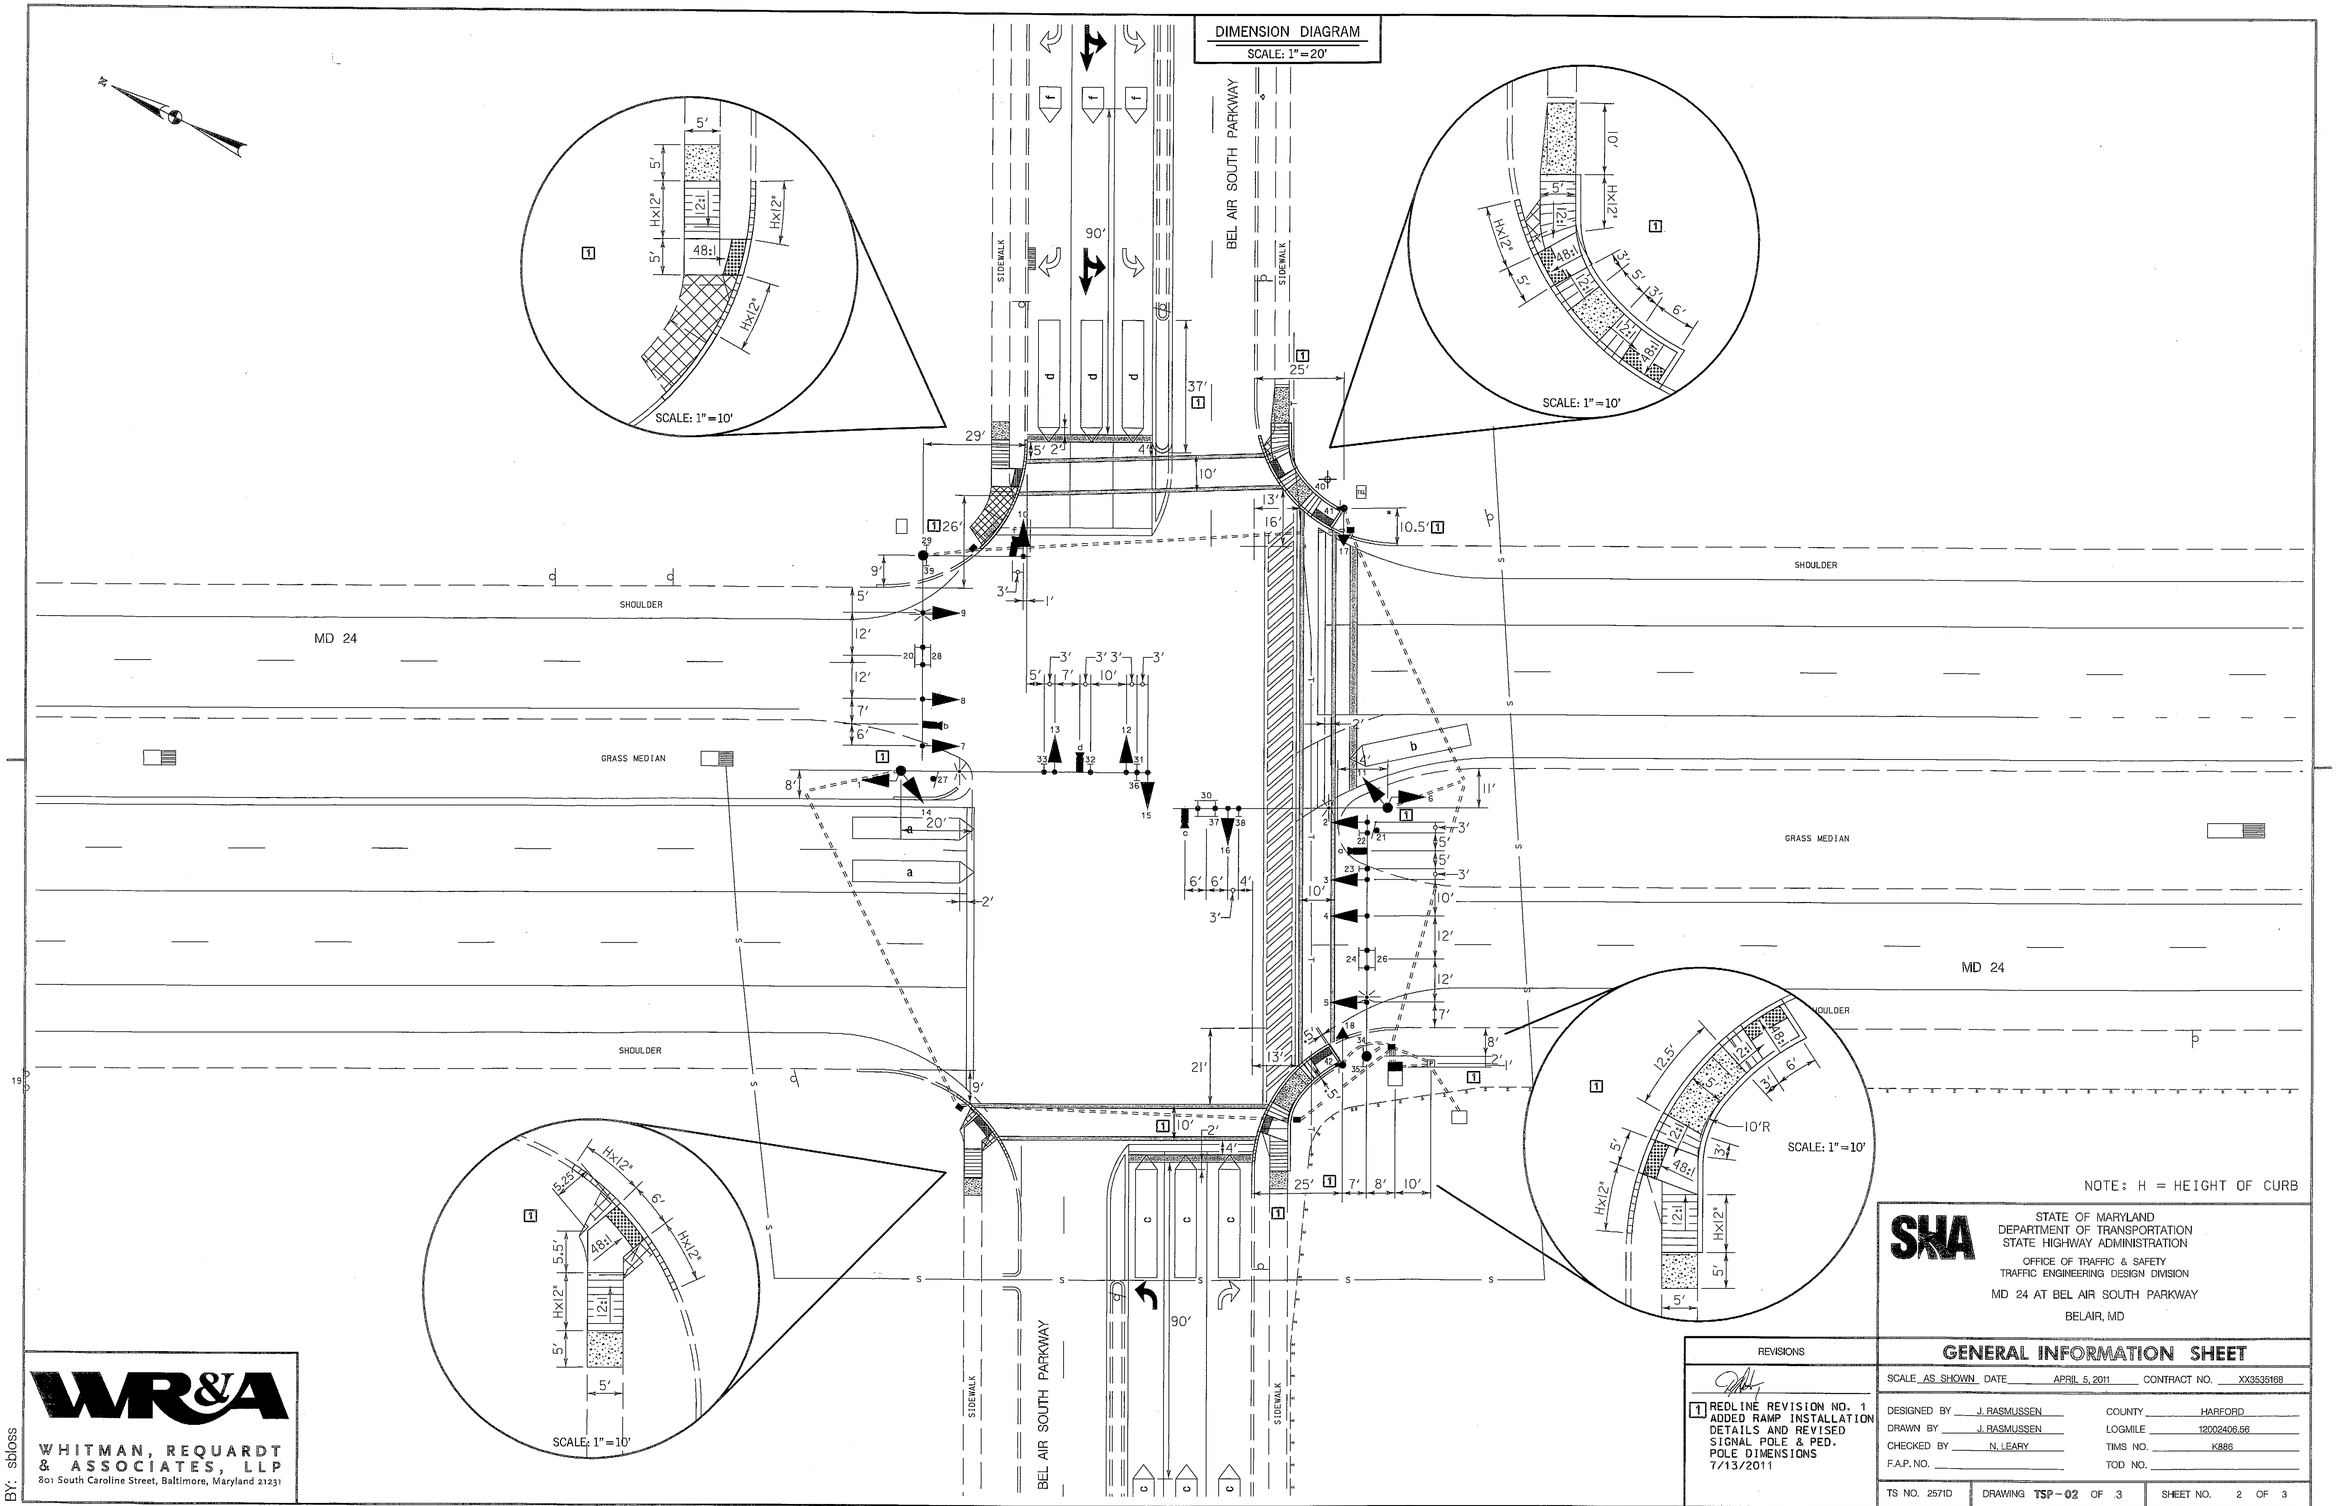

WR&A
WHITMAN, REQUARDT & ASSOCIATES, LLP
801 South Caroline Street, Baltimore, Maryland 21231

BY: sbloss

SHA
STATE OF MARYLAND
DEPARTMENT OF TRANSPORTATION
STATE HIGHWAY ADMINISTRATION
OFFICE OF TRAFFIC & SAFETY
TRAFFIC ENGINEERING DESIGN DIVISION

MD 24 AT BEL AIR SOUTH PARKWAY
BELAIR, MD

REVISIONS

1 REDLINE REVISION NO. 1
ADDED RAMP INSTALLATION DETAILS AND REVISED SIGNAL POLE & PED. POLE DIMENSIONS
7/13/2011

GENERAL INFORMATION SHEET

SCALE AS SHOWN DATE APRIL 5, 2011 CONTRACT NO. XX3535168

DESIGNED BY J. RASMUSSEN
DRAWN BY J. RASMUSSEN
CHECKED BY N. LEARY
F.A.P. NO.

COUNTY HARFORD
LOGMILE 12002406.56
TIMS NO. K886
TOD NO.

TS NO. 2571D | DRAWING TSP-02 OF 3 | SHEET NO. 2 OF 3

PLOTTED: Wednesday, July 13, 2011 AT 03:28 PM
FILE: N:\31669-130\CADD\Redline1\pSG-N002_MD24_RL1.dgn