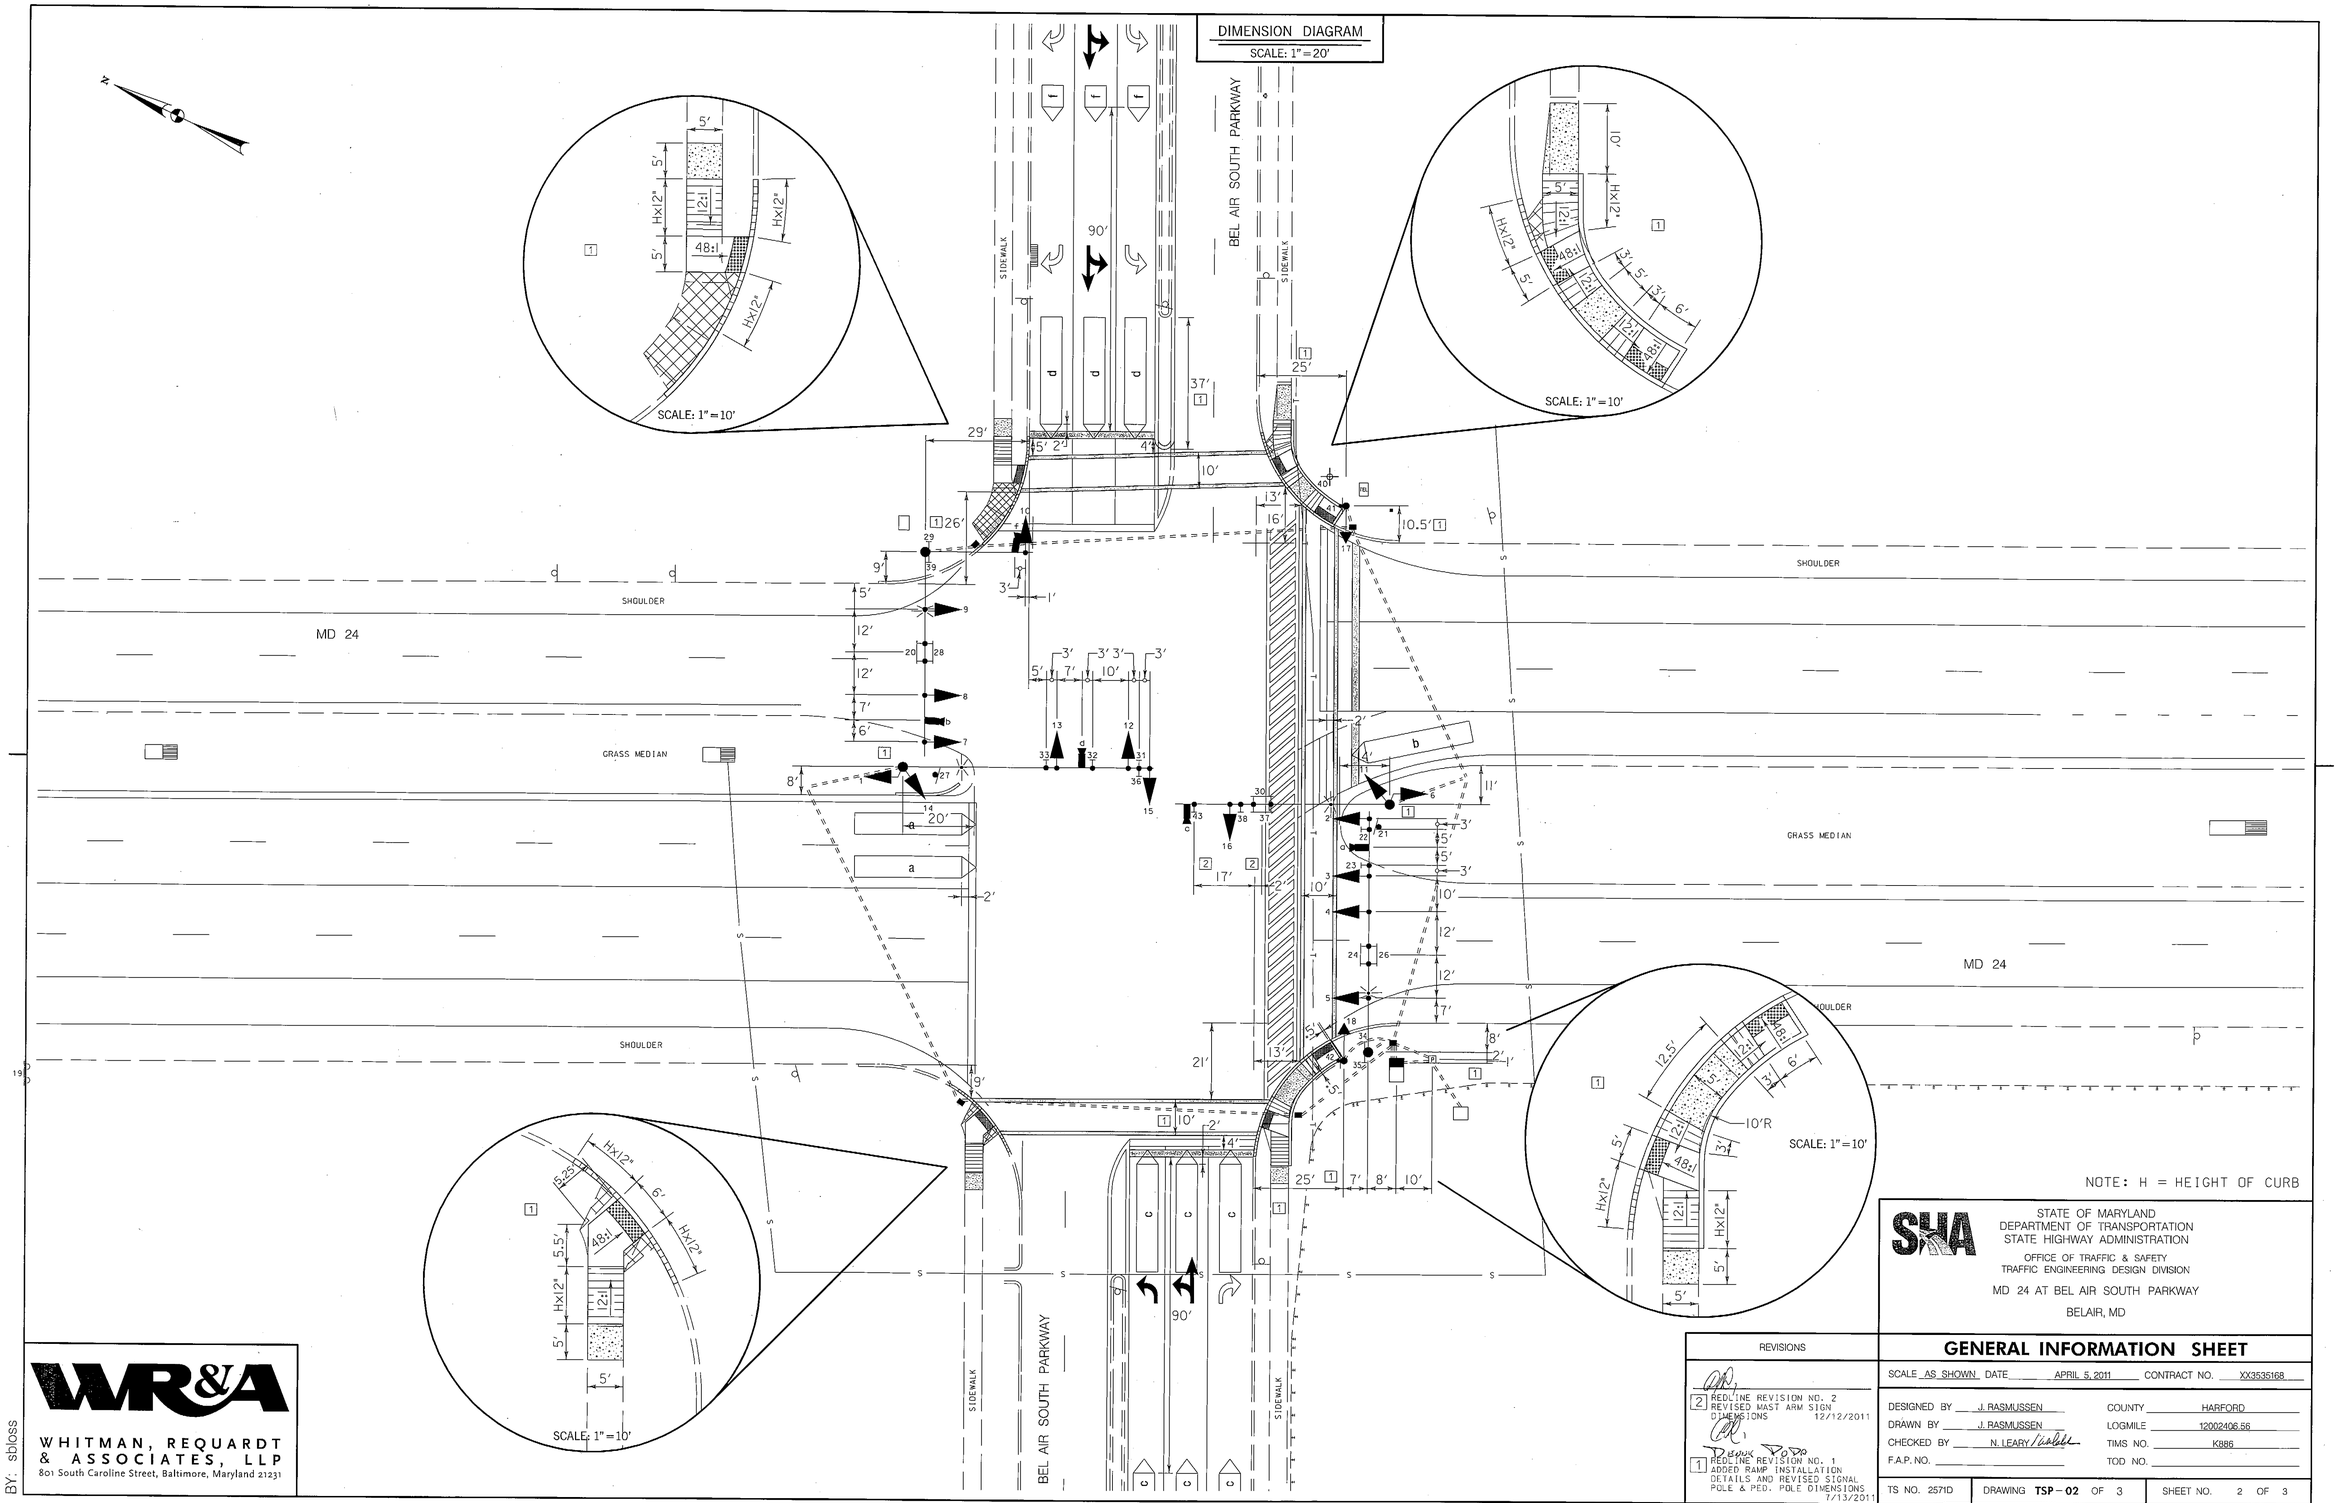

WR&A
WHITMAN, REQUARDT & ASSOCIATES, LLP
801 South Caroline Street, Baltimore, Maryland 21231

BY: sbloss

STATE OF MARYLAND
DEPARTMENT OF TRANSPORTATION
STATE HIGHWAY ADMINISTRATION
OFFICE OF TRAFFIC & SAFETY
TRAFFIC ENGINEERING DESIGN DIVISION

MD 24 AT BEL AIR SOUTH PARKWAY
BELAIR, MD

REVISIONS

2 REDLINE REVISION NO. 2
REVISED MAST ARM SIGN DIMENSIONS 12/12/2011

1 REDLINE REVISION NO. 1
ADDED RAMP INSTALLATION DETAILS AND REVISED SIGNAL POLE & PED. POLE DIMENSIONS 7/13/2011

PLOTTED: December 13, 2011
FILE: N:\31669-130\CADD\Redline2\pSG-N002_MD24_RL1.sign

GENERAL INFORMATION SHEET

SCALE AS SHOWN DATE APRIL 5, 2011 CONTRACT NO. XX3535168

DESIGNED BY J. RASMUSSEN COUNTY HARFORD
DRAWN BY J. RASMUSSEN LOGMILE 12002406.56
CHECKED BY N. LEARY TIMS NO. K886
F.A.P. NO. TOD NO.

TS NO. 2571D | DRAWING TSP-02 OF 3 | SHEET NO. 2 OF 3