F H WA REGION NO	STATE	FED. AID PROJ. NO	SHEET NO.	TOTAL SHEETS
3	MD.	CMG-125-1 (15)	8	12

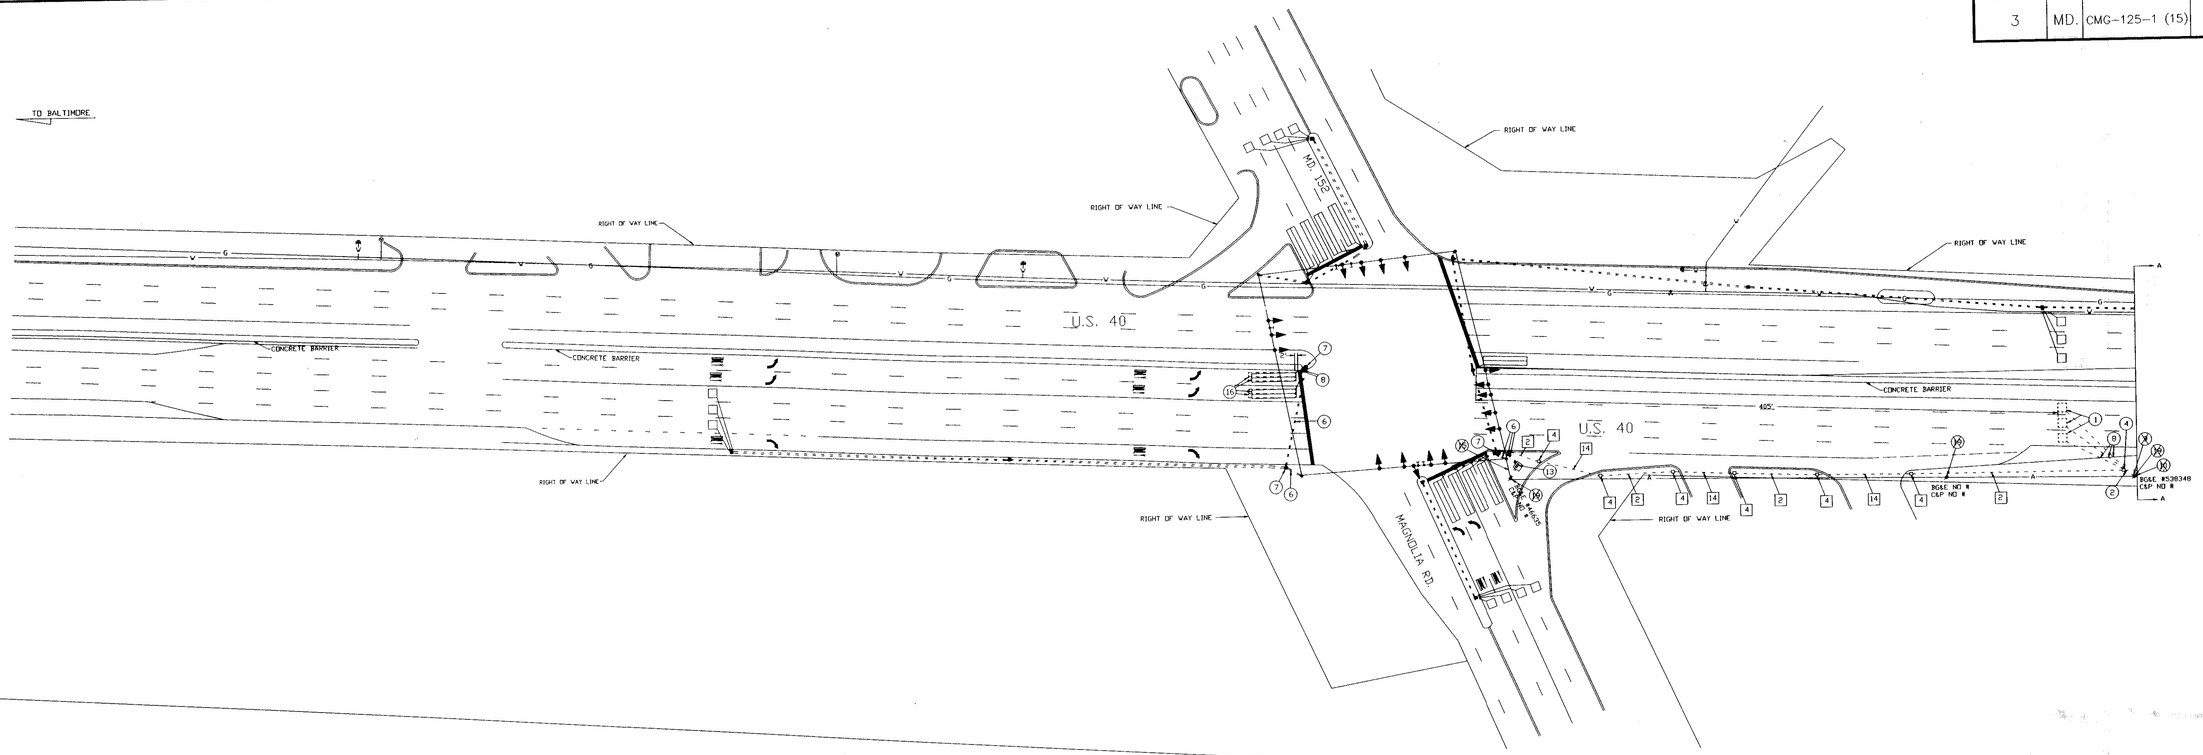

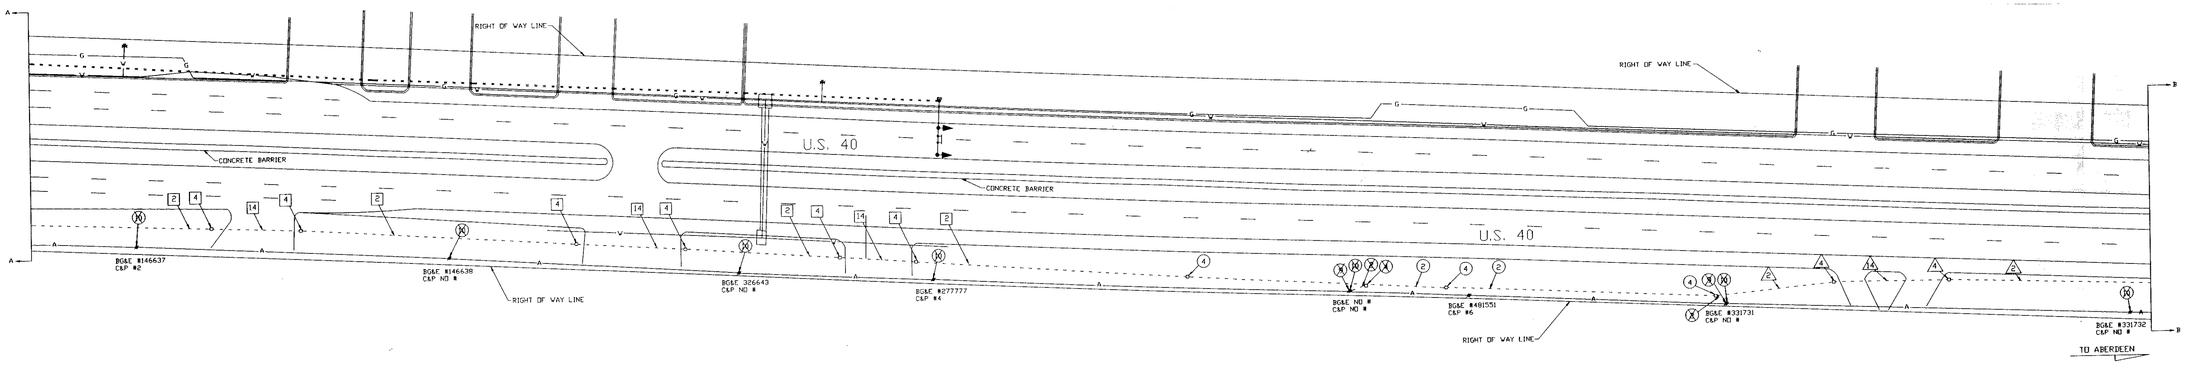

UTILITY LEGEND	
G — G	GAS MAIN
V — V	WATER MAIN
S — S	SEWER MAIN
E — E	ELECTRIC CABLES
A — A	AERIAL CABLES
T — T	TELEPHONE CABLES

REVISIONS

A. 03/93 - RELOCATED SOME O/H TELEMETRY CABLE TO UNDERGROUND SHA # H 933-501-485

W.M.	E.J.S.	DJD	DAZ	ETP	TH

B. 05/93 - RELOCATED SOME O/H TELEMETRY CABLE TO UNDERGROUND SHA # H 933-501-485

W.M. ETP

APPROVALS

CHIEF, SIGNAL DESIGN SECTION

ASST. DISTRICT ENGINEER, TRAFFIC

CHIEF, TRAFFIC ENGINEERING DESIGN DIVISION

DIRECTOR, OFFICE OF TRAFFIC & SAFETY

MDOT – STATE HIGHWAY ADMINISTRATION

Office of Traffic & Safety

TRAFFIC ENGINEERING DESIGN DIVISION

SIGNAL # 12004002.12

DRAWN BY: *W. Malcolm*

DES. BY: *W. Malcolm*

CHK. BY:

U.S. 40 (PULASKI HIGHWAY) FROM MD. 152 TO MD. 755

COUNTY: HARFORD

DATE: 08/92

SCALE: 1' = 50'

F.A.P. NO. CMG-125-1 (15)

S.H.A. NO. H-933-501-485

TS/STD. NO. TS-3252 B

SHEET NO. 8 OF 12

12004002.12