F.H.W.A. REGION NO.	STATE	FED. AID PROJ. NO.	SHEET NO.	TOTAL SHEETS
3	MD.	M-7104-(1)	4	16

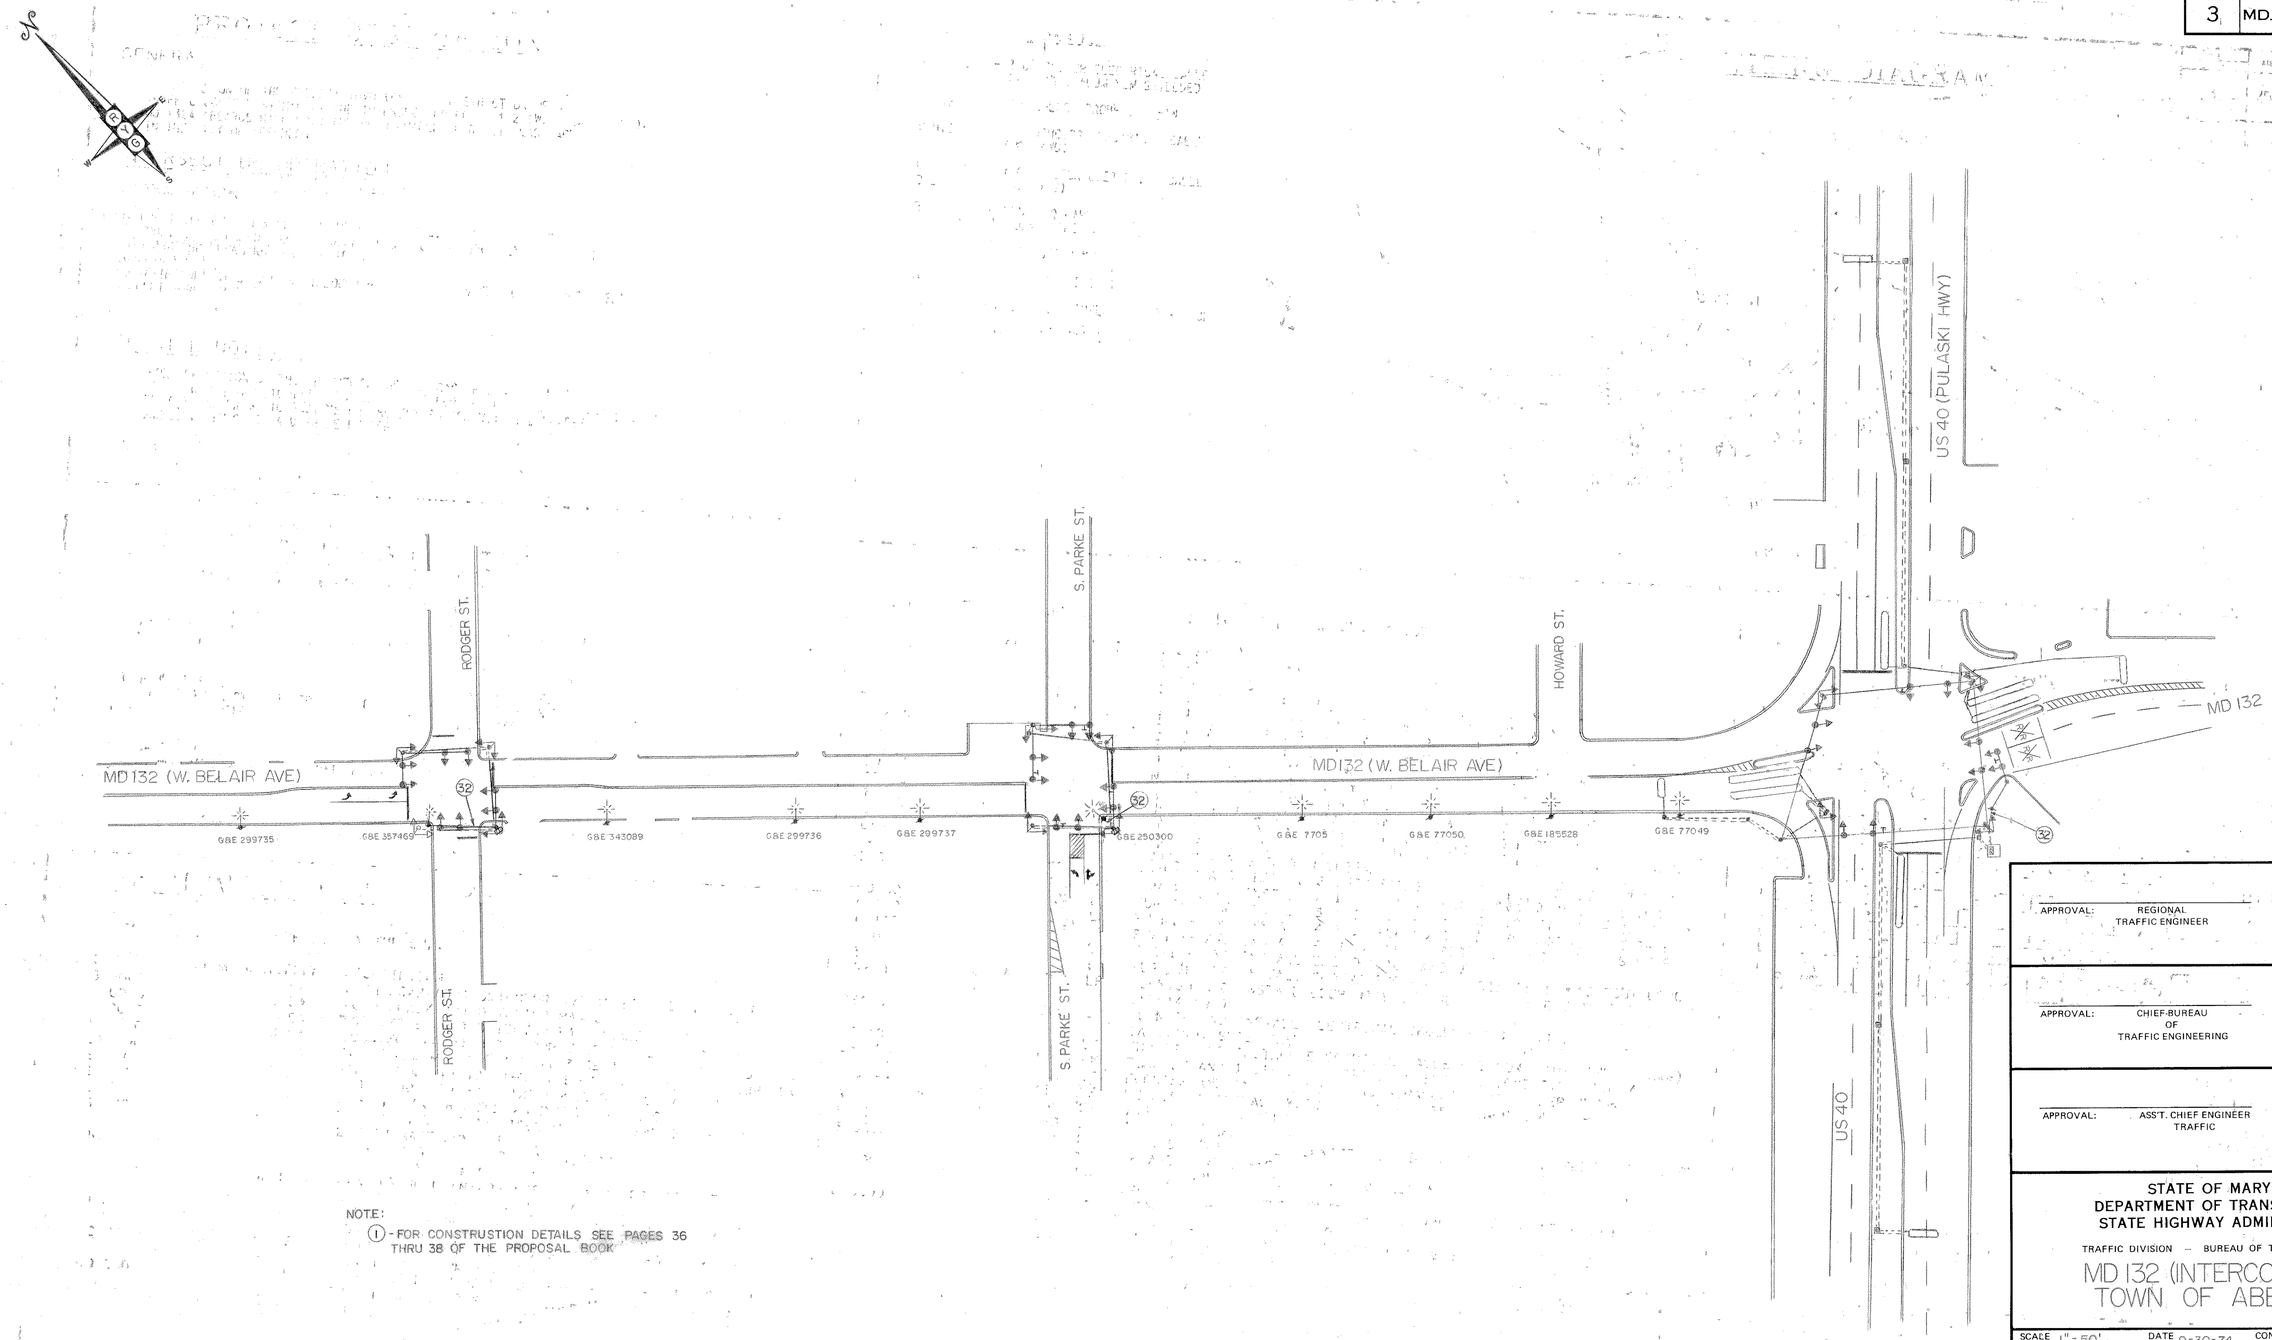

NOTE:

(1) - FOR CONSTRUSTION DETAILS SEE PAGES 36 THRU 38 OF THE PROPOSAL BOOK

APPROVAL: REGIONAL TRAFFIC ENGINEER

APPROVAL: CHIEF-BUREAU OF TRAFFIC ENGINEERING

APPROVAL: ASS'T. CHIEF ENGINEER TRAFFIC

(A) ASBUILT 7-21-82
H 700-001-485
M-7104-(1) F.A.P. NO.

REVISIONS

STATE OF MARYLAND
DEPARTMENT OF TRANSPORTATION
STATE HIGHWAY ADMINISTRATION

TRAFFIC DIVISION — BUREAU OF TRAFFIC ENGINEERING

MD 132 (INTERCONNECT) TOWN OF ABERDEEN

SHEET 4 OF 16

SCALE 1" = 50' DATE 9-30-74 CONTRACT NO.

DRAWN BY: H KILIAN COUNTY: HARFORD

DESIGNED BY: Howard J. Kilian Jr. SIGNAL NO.:

CHECKED BY:

DRAWING NO. TS-1223 A

BRUNING 44-511 19927