PLAN SHEET

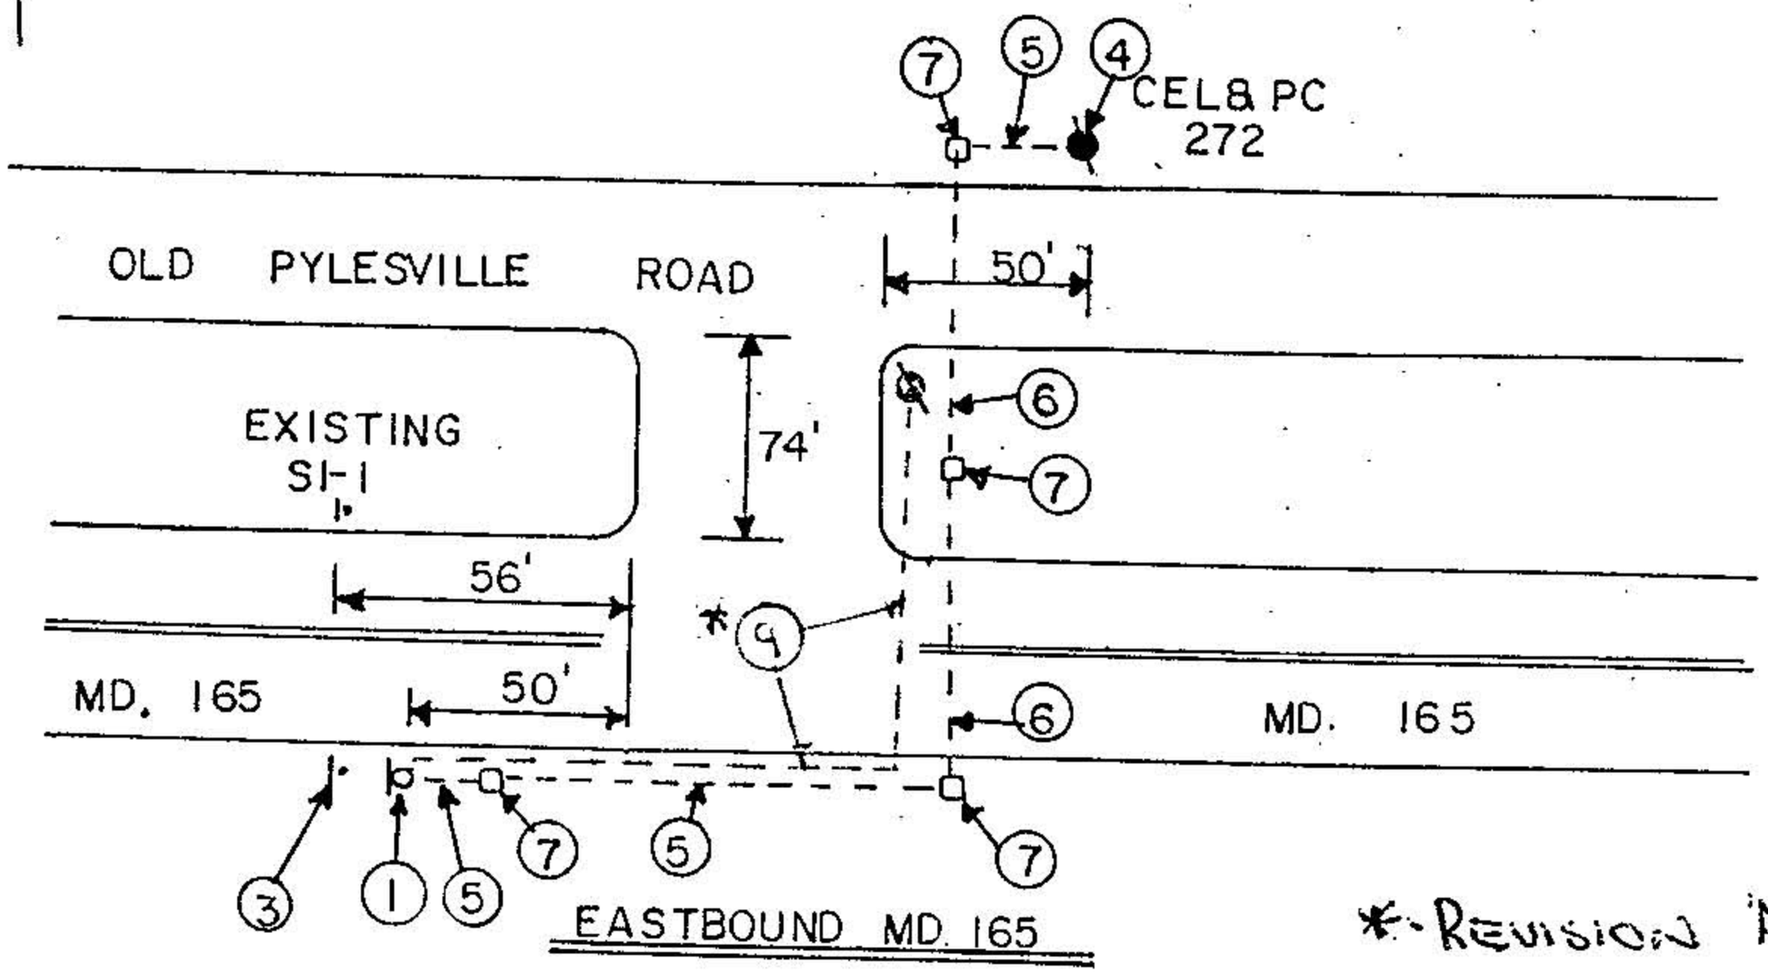

*- REVISION 'A'

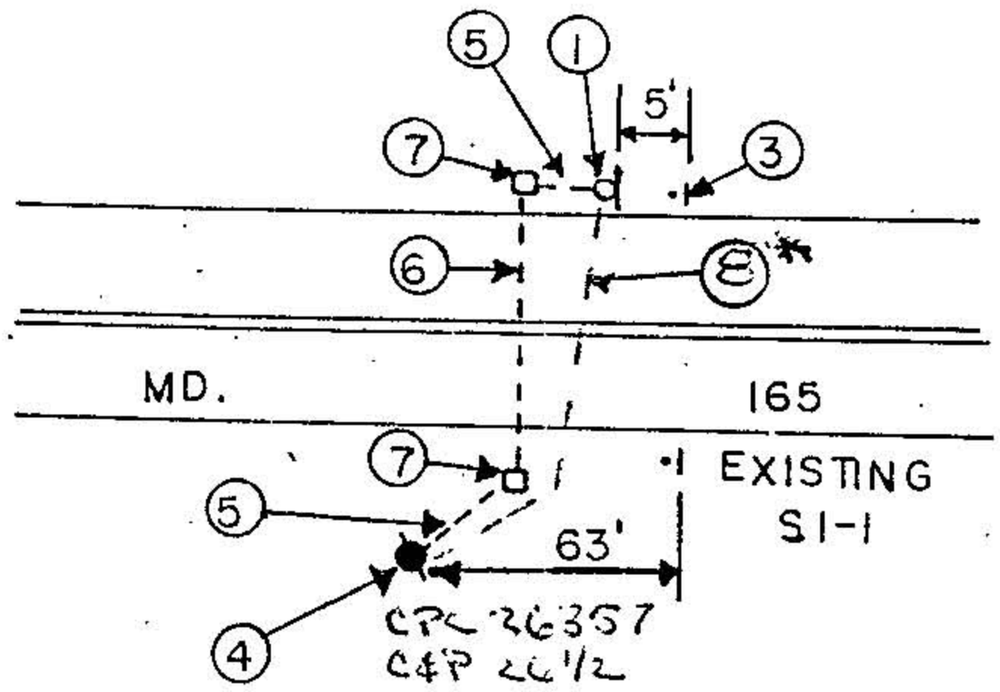

*- REVISION 'A'

WESTBOUND MD. 165

NOTE

A). NEW PEDESTAL POLES TO BE LOCATED SIX (6) FEET OFF ROADWAY.

B). ALL PROPOSED EQUIPMENT ON S.H.A. RIGHT OF WAY.

Maryland Department of Transportation
Office of Traffic & Safety
Traffic Engineering Design Division

PLAN SHEET — TS: 3454
MD. 165 at North Harford School Complex
Harford County
NOT TO SCALE

DATE	DRAWN BY	CONTRACT NO.
07/31/1994	G. SIMMERS	AW453-461-385 (N)