	1	2	3	4	5	6	7	8
	Y	Y	Y	Y	R	R	R	R
FLASHING OPERATION	FL/Y	FL/Y	FL/Y	FL/Y	FL/R	FL/R	FL/R	FL/R

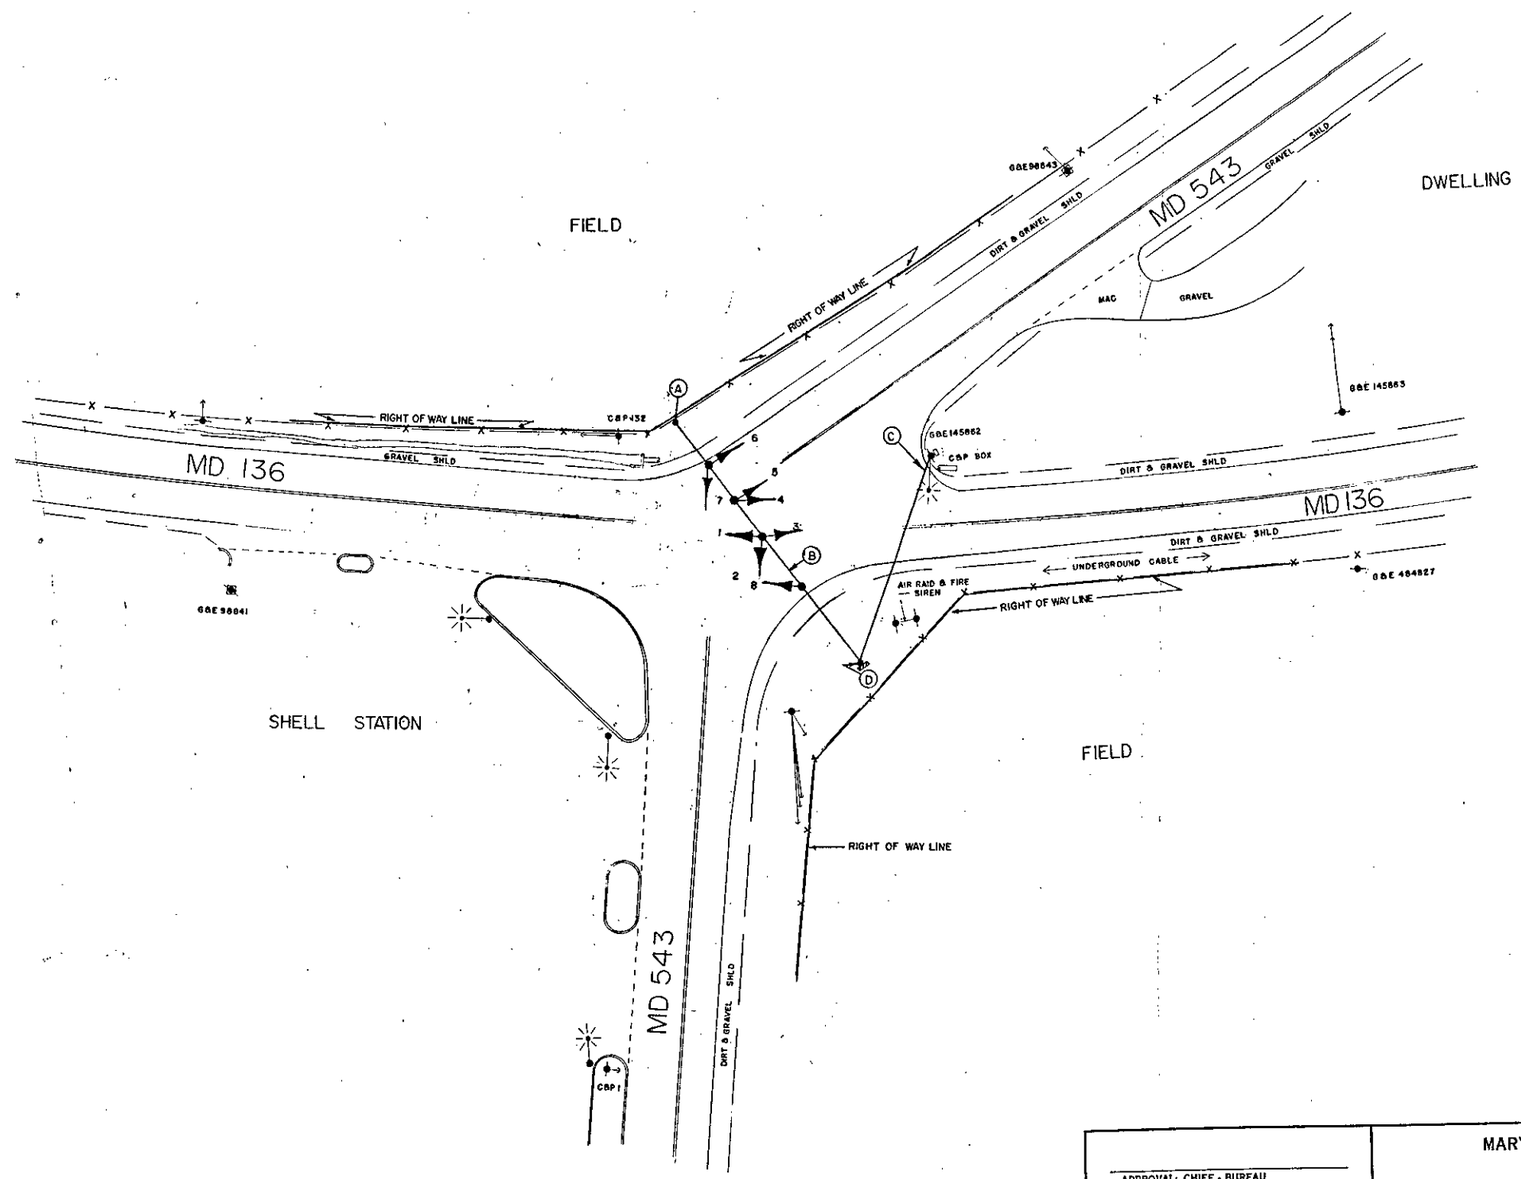

A	7/21/73
	AS BUILT
DD	FD
REVISIONS	

APPROVAL: CHIEF - BUREAU OF TRAFFIC ENGINEERING

APPROVAL: ASS'T CHIEF ENGINEER TRAFFIC SAFETY 10-25-72

MARYLAND STATE ROADS COMMISSION
DIVISION OF TRAFFIC SAFETY
BUREAU OF TRAFFIC ENGINEERING

MD 136 & MD 543

SIGNAL NO. 12118

DATE JULY 13,1972 CONTRACT NO H 622X-475
SCALE 1"=20' COUNTY HARFORD
DRAWN BY: LES TOWNSEND CHECKED BY:

DRAWING NO. TS 618 A

12013602.41