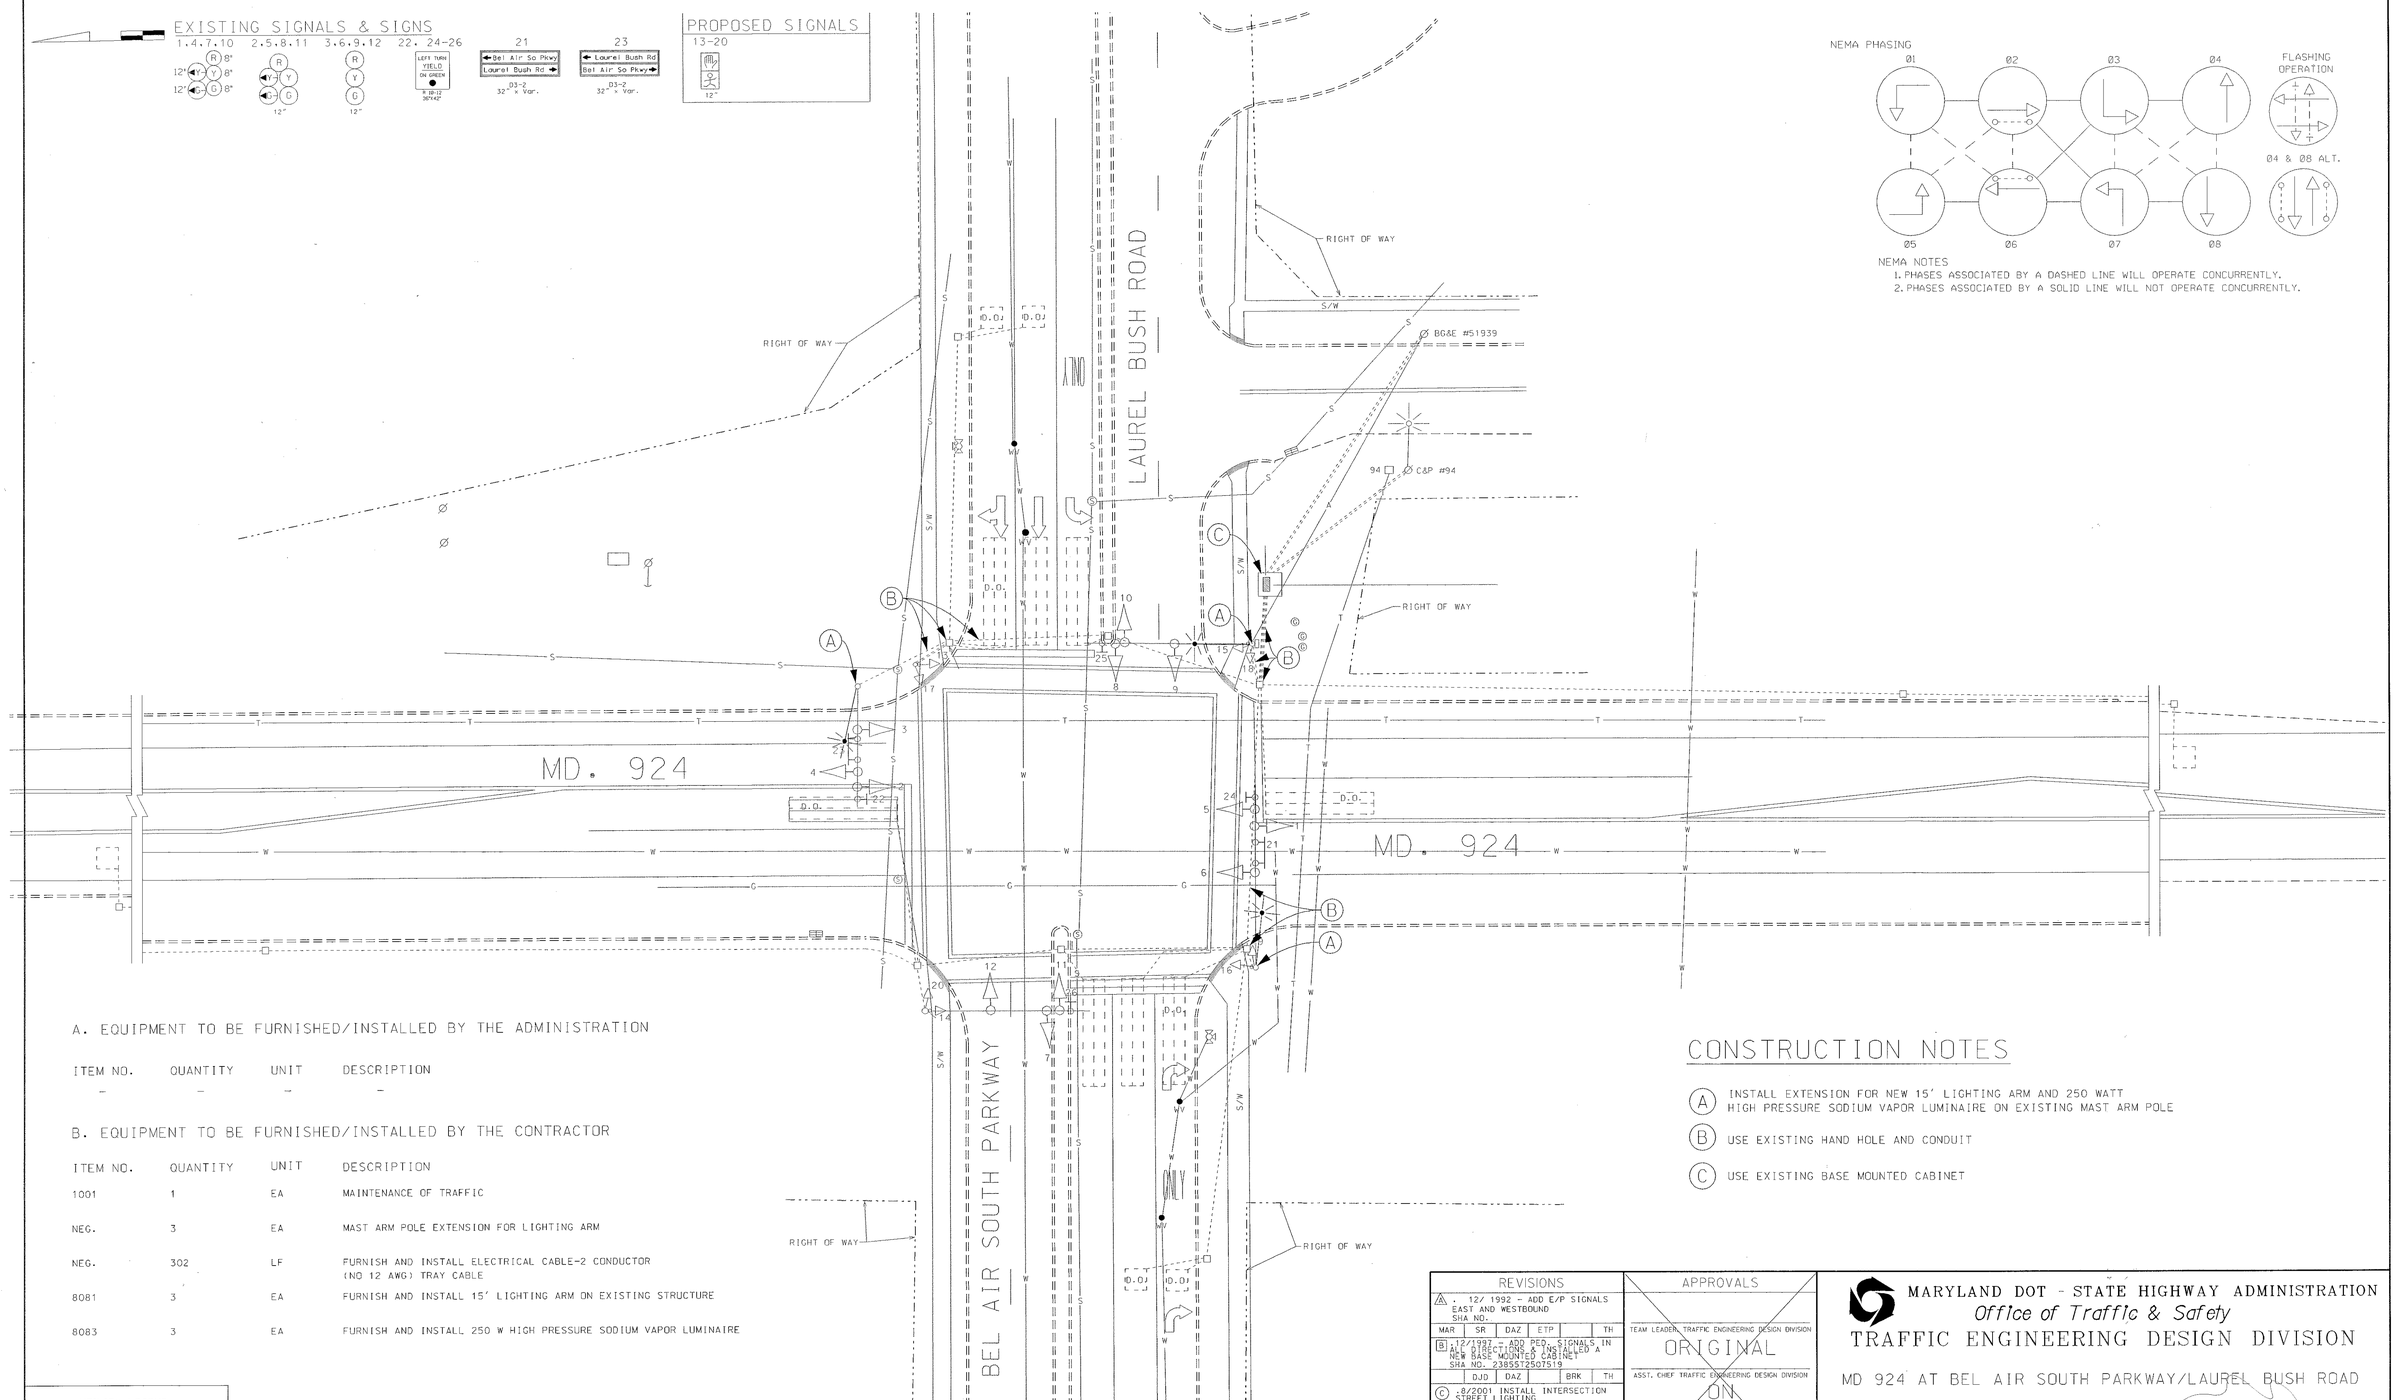

NEMA NOTES
1. PHASES ASSOCIATED BY A DASHED LINE WILL OPERATE CONCURRENTLY.
2. PHASES ASSOCIATED BY A SOLID LINE WILL NOT OPERATE CONCURRENTLY.

A. EQUIPMENT TO BE FURNISHED/INSTALLED BY THE ADMINISTRATION

ITEM NO.	QUANTITY	UNIT	DESCRIPTION
–	–	–	–

B. EQUIPMENT TO BE FURNISHED/INSTALLED BY THE CONTRACTOR

ITEM NO.	QUANTITY	UNIT	DESCRIPTION
1001	1	EA	MAINTENANCE OF TRAFFIC
NEG.	3	EA	MAST ARM POLE EXTENSION FOR LIGHTING ARM
NEG.	302	LF	FURNISH AND INSTALL ELECTRICAL CABLE-2 CONDUCTOR (NO 12 AWG) TRAY CABLE
8081	3	EA	FURNISH AND INSTALL 15' LIGHTING ARM ON EXISTING STRUCTURE
8083	3	EA	FURNISH AND INSTALL 250 W HIGH PRESSURE SODIUM VAPOR LUMINAIRE

CONSTRUCTION NOTES

(A) INSTALL EXTENSION FOR NEW 15' LIGHTING ARM AND 250 WATT HIGH PRESSURE SODIUM VAPOR LUMINAIRE ON EXISTING MAST ARM POLE

(B) USE EXISTING HAND HOLE AND CONDUIT

(C) USE EXISTING BASE MOUNTED CABINET

UTILITY LEGEND

—G—G—	GAS MAIN
—W—W—	WATER MAIN
—S—S—	SEWER MAIN
—E—E—	ELECTRIC CABLES
—A—A—	AERIAL CABLES
—T—T—	TELEPHONE CABLES

REVISIONS

A. 12/ 1992 - ADD E/P SIGNALS EAST AND WESTBOUND SHA NO.

MAR	SR	DAZ	ETP		TH

B. 12/1997 - ADD PED. SIGNALS IN ALL DIRECTIONS & INSTALLED A NEW BASE MOUNTED CABINET SHA NO. 23855T2507519

	DJD	DAZ		BRK	TH

C. 8/2001 INSTALL INTERSECTION STREET LIGHTING SHA NO. OT 2009

GCP

APPROVALS

TEAM LEADER, TRAFFIC ENGINEERING DESIGN DIVISION

ORIGINAL

ASST. CHIEF TRAFFIC ENGINEERING DESIGN DIVISION

ON

CHIEF, TRAFFIC ENGINEERING DESIGN DIVISION

FILE

DIRECTOR, TRAFFIC & SAFETY

MARYLAND DOT - STATE HIGHWAY ADMINISTRATION
Office of Traffic & Safety
TRAFFIC ENGINEERING DESIGN DIVISION

MD 924 AT BEL AIR SOUTH PARKWAY/LAUREL BUSH ROAD

DRAWN BY:	M.A.M. FOR THE TRAFFIC GROUP	F.A.P. NO.	23854T2502888
CHECKED BY:	D. L. ANDREWS/ D. J. DODA	S.H.A. NO.	
SCALE:	1" = 20'	COUNTY:	HARFORD
DATE:	5-10-1989	LOG MILE:	SIGNAL NO. 12092402.62

TS NO. TS-2520 C

T.I.M.S. NO. E829

SHEET NO. 1 OF 1