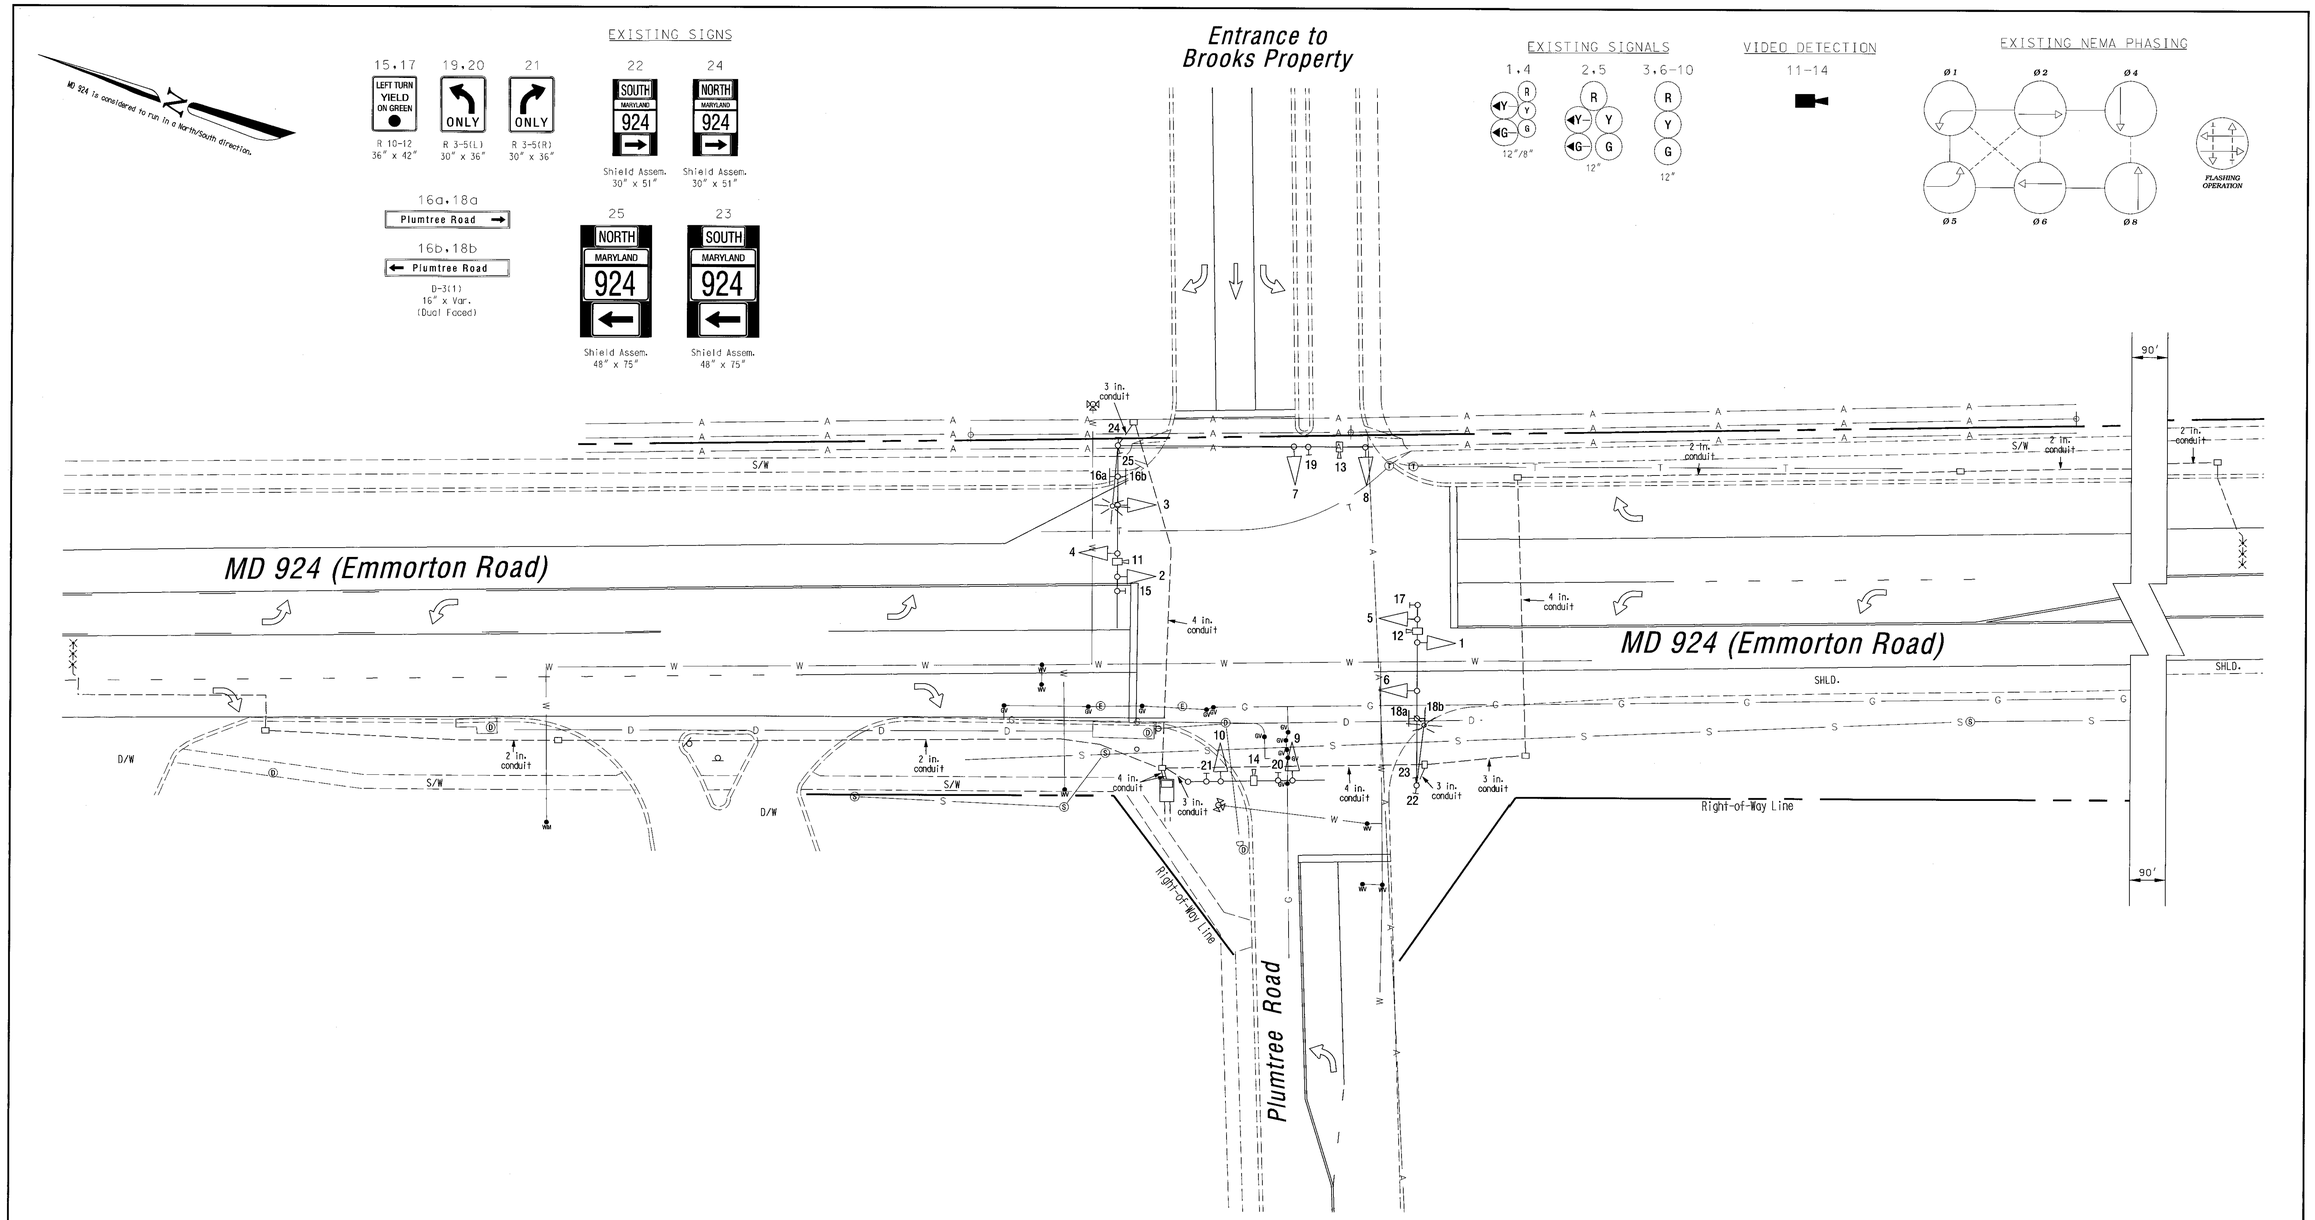

GEOMETRIC LEGEND

EXISTING GEOMETRICS

PROPOSED GEOMETRICS

UTILITY LEGEND

G	GAS MAIN
W	WATER MAIN
S	SEWER MAIN
E	ELECTRIC CABLES
D	STORM DRAIN
A	AERIAL CABLES
T	TELEPHONE CABLES

"As Built"

The Traffic Group

The Traffic Group, Inc.
410-931-6600
Fax 410-931-6601

REVISIONS

April 30, 2003
"As Built"
S.H.A. No.:BW996M82
md

APPROVALS

ORIGINAL ON FILE

TEAM LEADER, TRAFFIC ENGINEERING DESIGN DIVISION

ASST. CHIEF TRAFFIC ENGINEERING DESIGN DIVISION

CHIEF, TRAFFIC ENGINEERING DESIGN DIVISION

DIRECTOR, TRAFFIC & SAFETY

MARYLAND DOT - STATE HIGHWAY ADMINISTRATION
Office of Traffic & Safety
TRAFFIC ENGINEERING DESIGN DIVISION
(Traffic Signal Plan)

MD 924 (Emmorton Road) at Plumtree Road

DRAWN BY:	Frank Hoeckel	F.A.P. NO.	N/A	TS NO. 4063	SHEET NO.
CHECKED BY:		S.H.A. NO.	BW996M82		
SCALE:	1" = 20'	COUNTY:	Harford County	T.I.M.S. NO. E-355	1 OF 1
DATE:	January 7, 2002	LOG MILE:	12092402.95		

F:\2002\0000-0099\ATS\ATS-sheet.dgn 5/8/2003