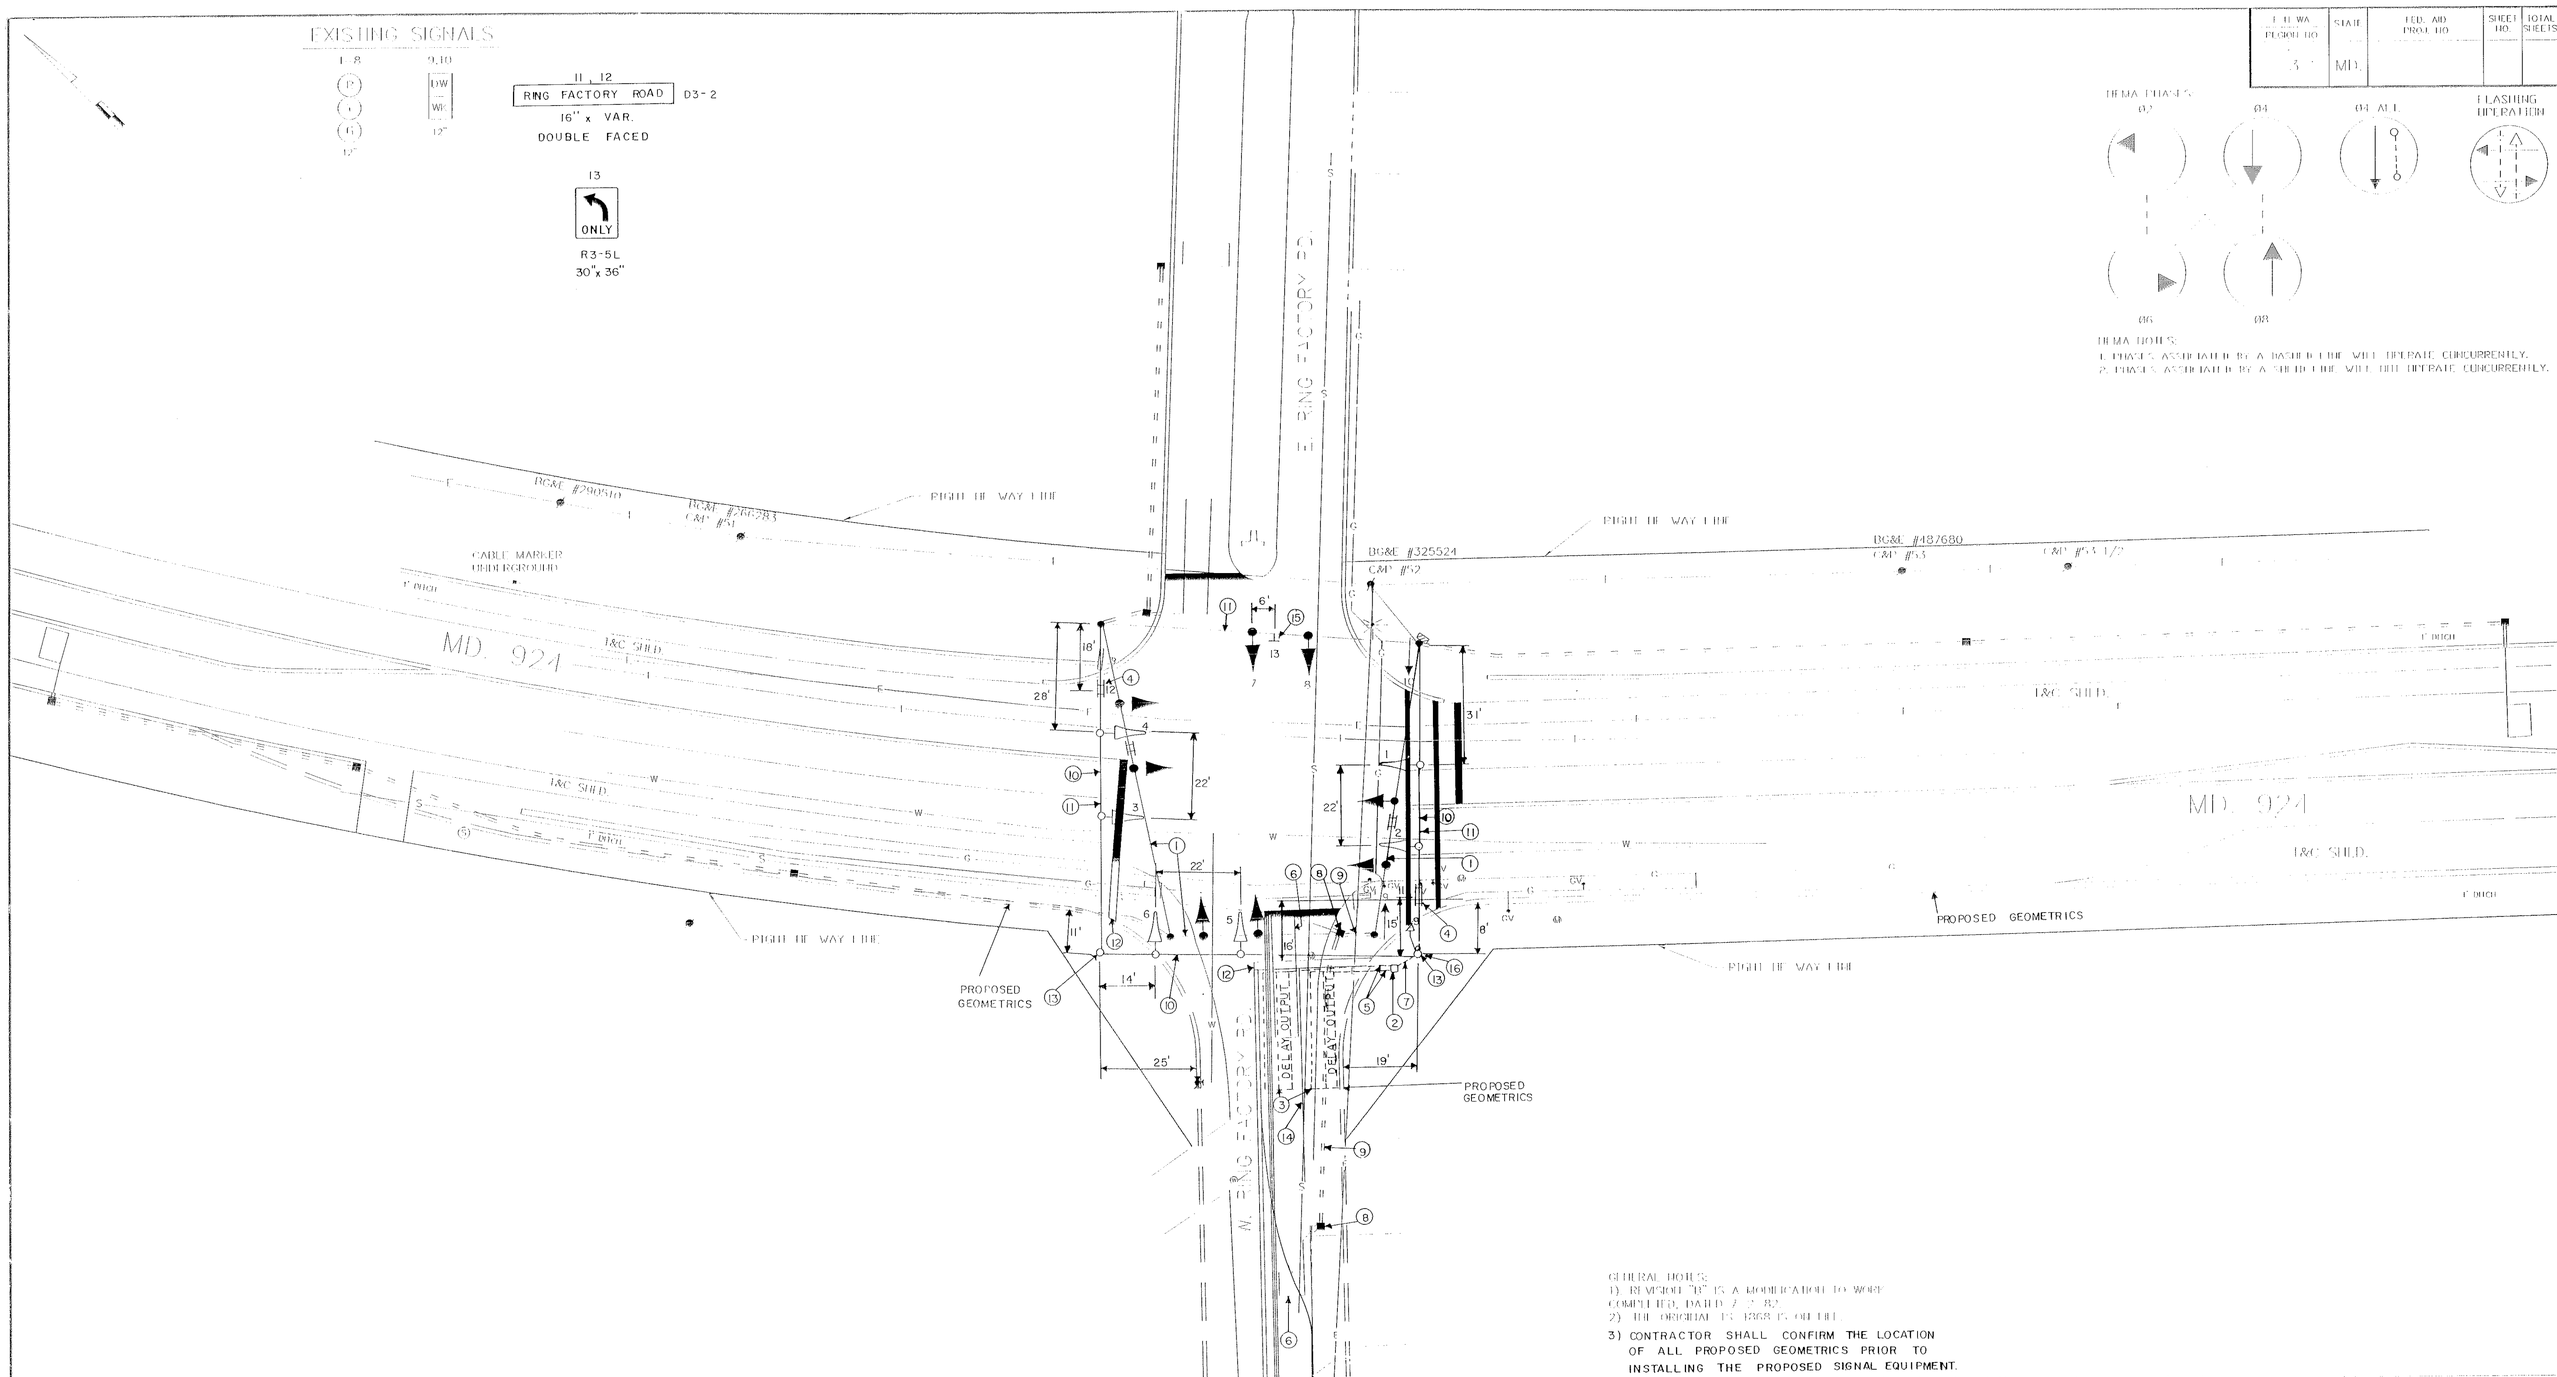

GENERAL NOTES:
1) REVISION "B" IS A MODIFICATION TO WORK COMPLETED, DATED 7-2-82.
2) THE ORIGINAL IS 1868 IS ON FILE.
3) CONTRACTOR SHALL CONFIRM THE LOCATION OF ALL PROPOSED GEOMETRICS PRIOR TO INSTALLING THE PROPOSED SIGNAL EQUIPMENT.

F.H.WA. REGION NO.	STATE	FED. AID PROJ. NO.	SHEET NO.	TOTAL SHEETS
3	MD.			

REVISIONS

A. 02/92
AS BUILT

B HARFORD CO. CONT. 92144
5-10-92 - RELOCATE SIGNAL EQUIPMENT AS PER REV. GEOMETRIC

APPROVALS

CHIEF, SIGNAL DESIGN SECTION

ASST. DISTRICT ENGINEER, TRAFFIC

CHIEF, TRAFFIC ENGINEERING DIVISION

DEPUTY CHIEF ENGINEER, OFFICE OF TRAFFIC

NOTE: THIS IS A REVISION TO CONTRACT, DATED 7-2-82 ORIGINAL PLAN ON FILE

MDOT - STATE HIGHWAY ADMINISTRATION
Office of Traffic & Safety
TRAFFIC ENGINEERING DESIGN DIVISION

SIGNAL # 1209240

DRAWN BY: J.GORDAN
DES. BY: J.GORDAN
CHK. BY:

MD. 924 & RING FACTORY RD.

COUNTY: HARFORD

DATE: 07-02-82
SCALE: 1" = 20'
F.A.P. NO.
S.H.A. NO.

IS/STD. NO. IS 1868 (B)

SHEET NO. 1 OF 1

UTILITY LEGEND

G	GAS MAIN
W	WATER MAIN
S	SEWER MAIN
E	ELECTRIC CABLES
A	AERIAL CABLES
T	TELEPHONE CABLES