DIMENSION DIAGRAM

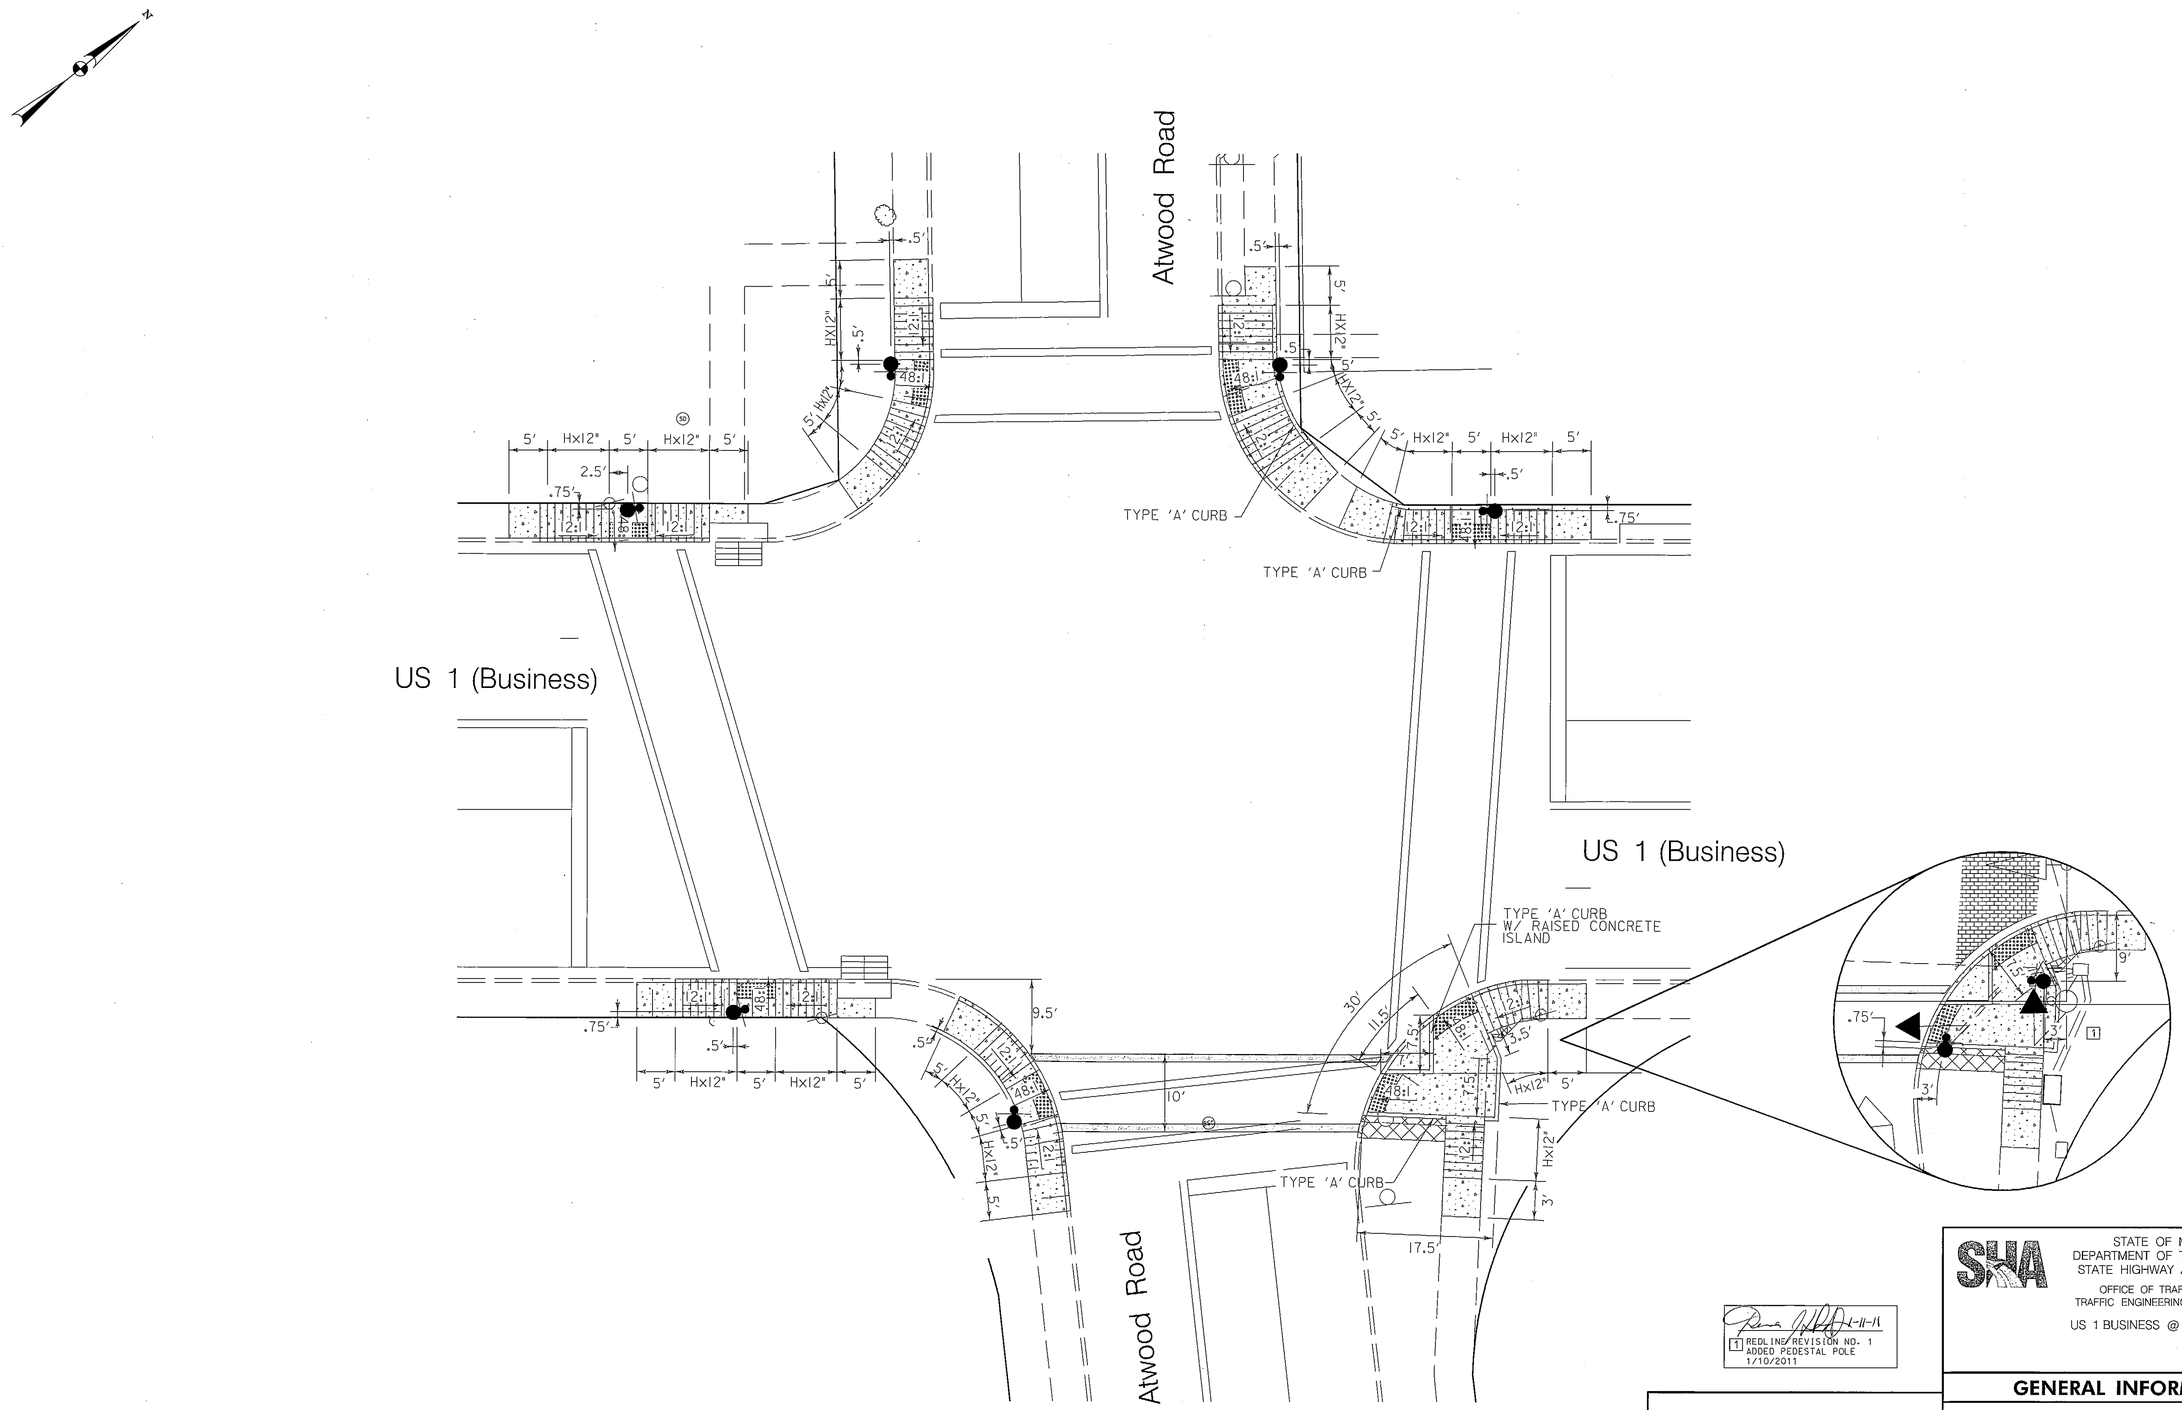

1 REDLINE REVISION NO. 1
ADDED PEDESTAL POLE
1/10/2011

H=HEIGHT OF CURB

WR&A
WHITMAN, REQUARDT & ASSOCIATES, LLP
801 South Caroline Street, Baltimore, Maryland 21231

SHA
STATE OF MARYLAND
DEPARTMENT OF TRANSPORTATION
STATE HIGHWAY ADMINISTRATION
OFFICE OF TRAFFIC & SAFETY
TRAFFIC ENGINEERING DESIGN DIVISION

US 1 BUSINESS @ ATWOOD ROAD

GENERAL INFORMATION SHEET

SCALE 1" = 10' ADVERTISED DATE 08/10/2010 CONTRACT NO.

DESIGNED BY	B. DONOWAY	COUNTY	HARFORD
DRAWN BY	B. DONOWAY	LOGMILE	12000102.15
CHECKED BY	N. Leary	TIMS NO.	K235
F.A.P. NO.		TOD NO.	

TS NO. 1962 E	DRAWING TSP – 2 OF 3	SHEET NO. 2 OF 3

PLOTTED: 01-10-2011
FILE: N:\31669-067\CADD\Redline_01.10.2011\pSG-N002_K235_RL.dgn

BY: sbloss