F H WA REGION NO	STATE	FED. AID PROJ. NO	SHEET NO.	TOTAL SHEETS
3	MD.		1	5

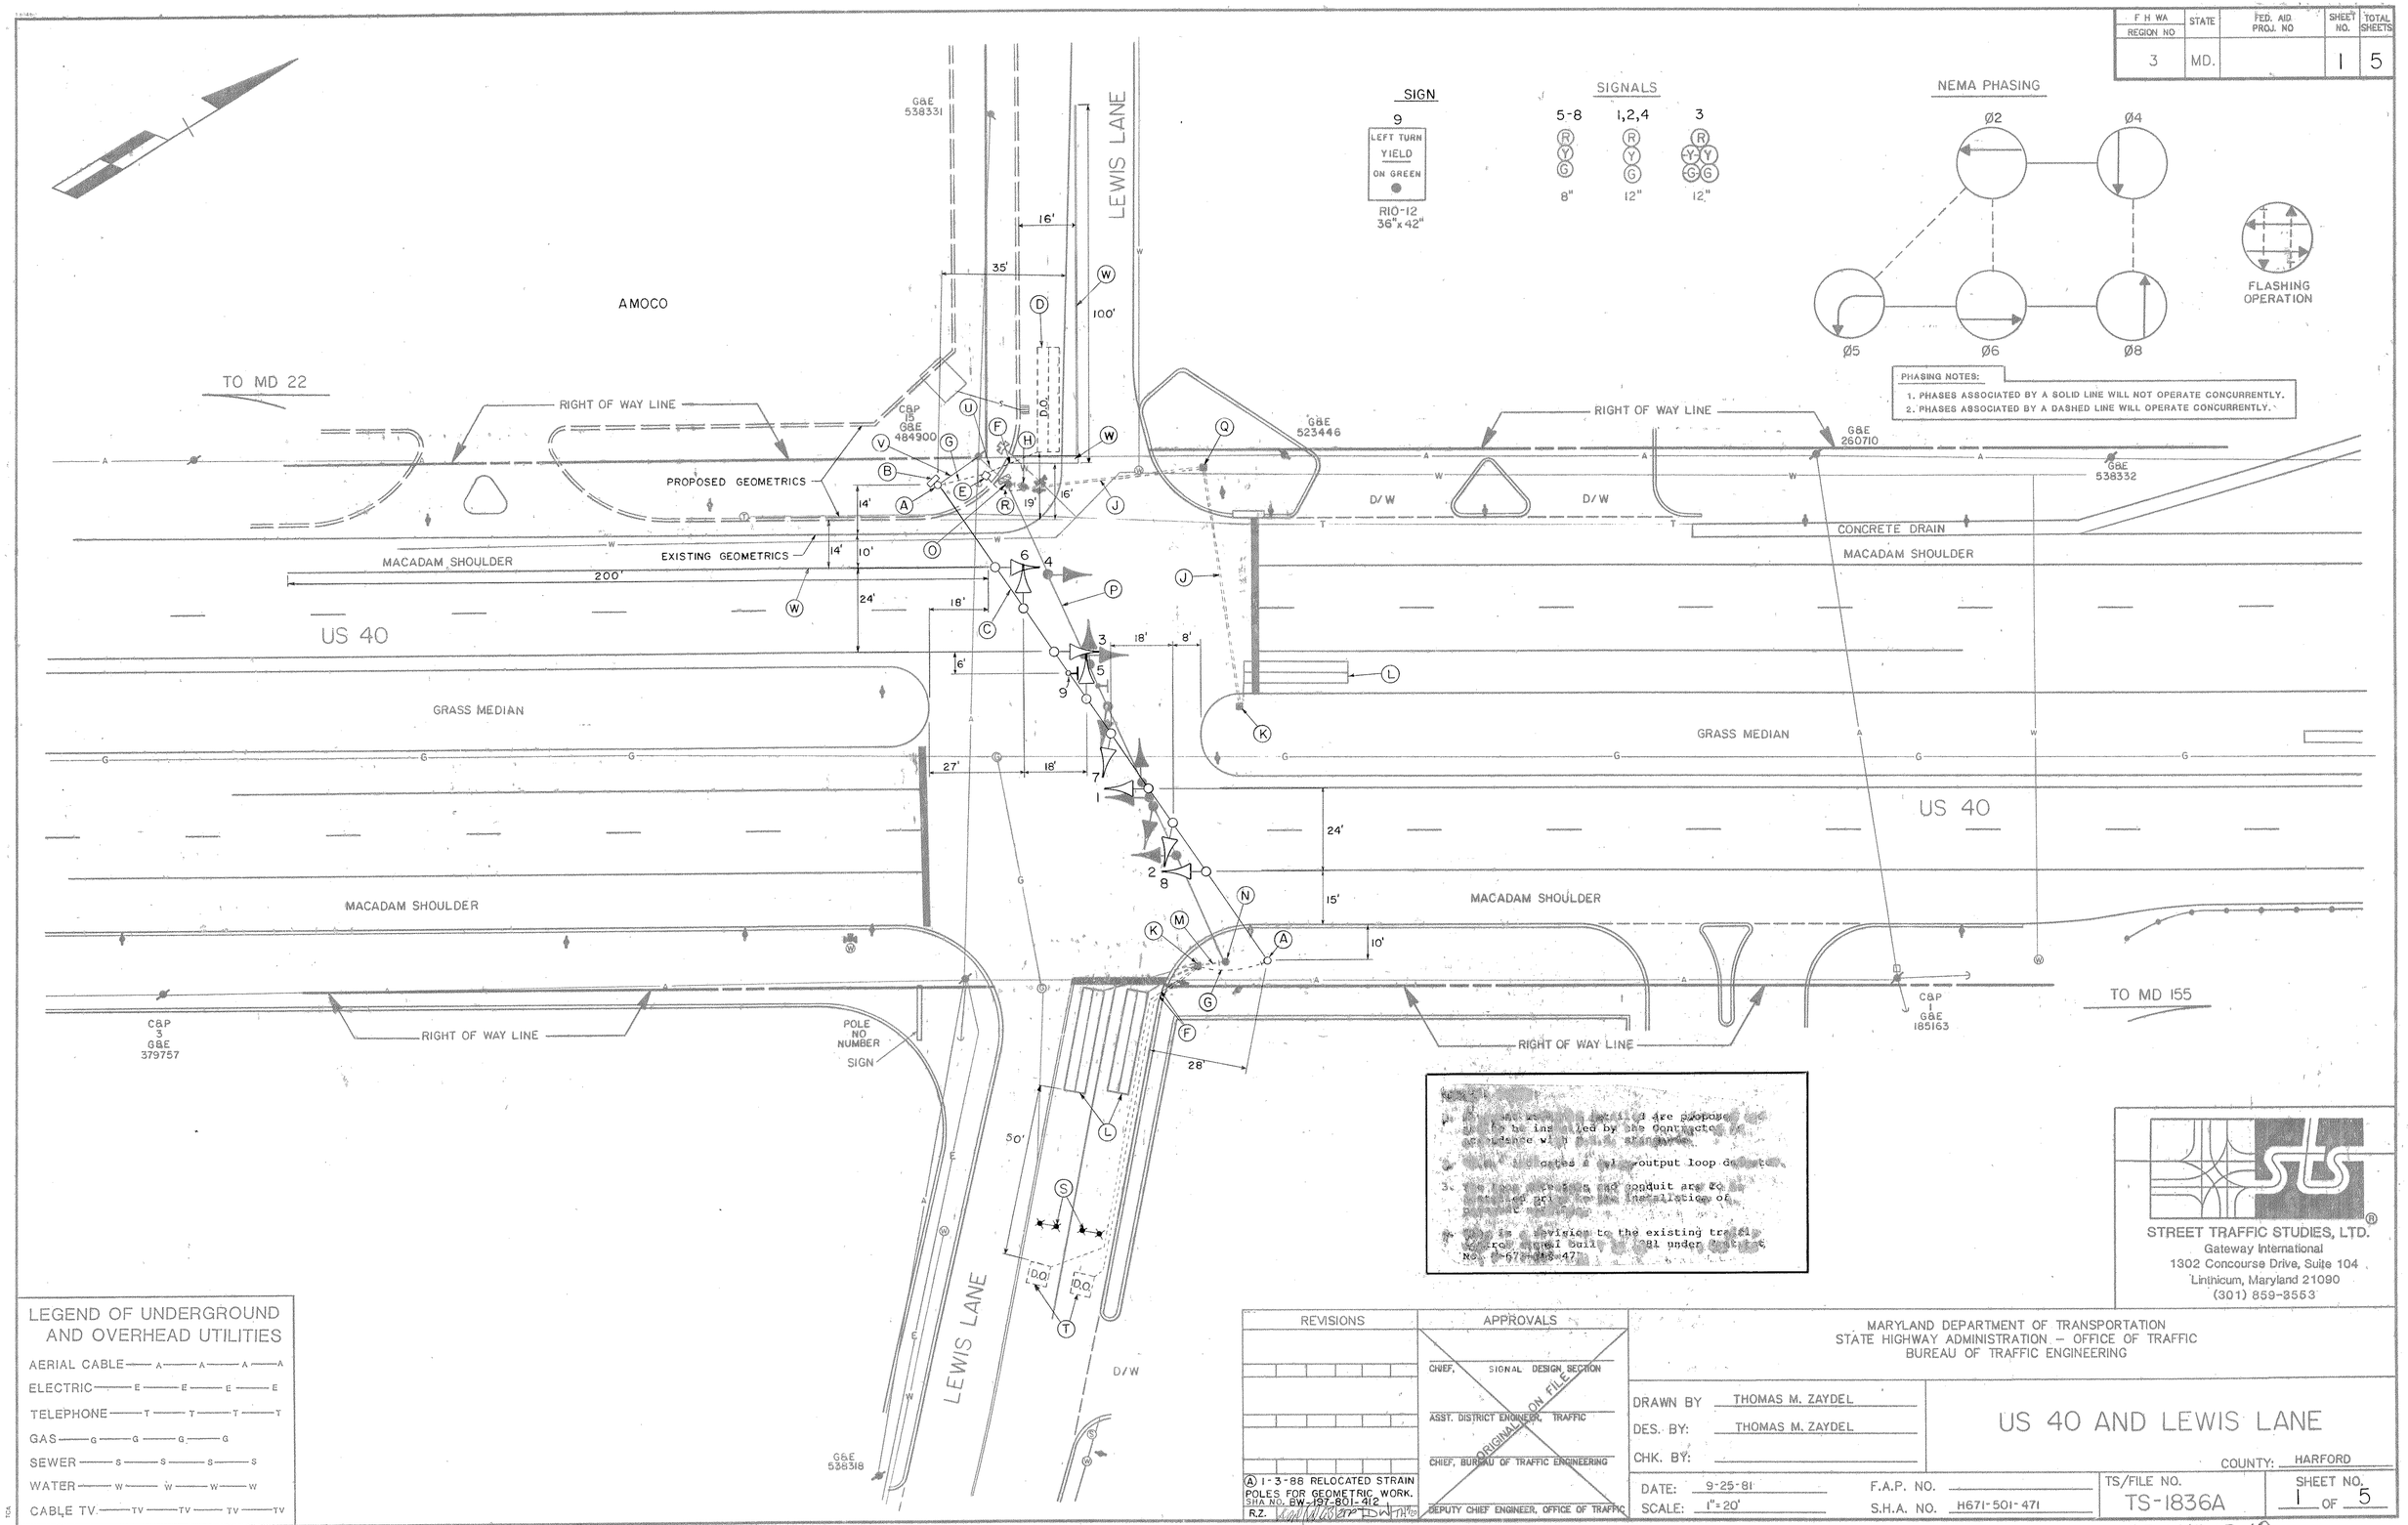

LEGEND OF UNDERGROUND AND OVERHEAD UTILITIES

AERIAL CABLE — A — A — A — A
ELECTRIC — E — E — E — E
TELEPHONE — T — T — T — T
GAS — G — G — G — G
SEWER — S — S — S — S
WATER — W — W — W — W
CABLE TV — TV — TV — TV — TV

STREET TRAFFIC STUDIES, LTD.
Gateway International
1302 Concourse Drive, Suite 104
Linthicum, Maryland 21090
(301) 859-3553

REVISIONS	APPROVALS
	CHIEF, SIGNAL DESIGN SECTION
	ASST. DISTRICT ENGINEER, TRAFFIC
	CHIEF, BUREAU OF TRAFFIC ENGINEERING
	DEPUTY CHIEF ENGINEER, OFFICE OF TRAFFIC

ORIGINAL ON FILE

(A) 1-3-88 RELOCATED STRAIN POLES FOR GEOMETRIC WORK.
SHA NO. BW-197-801-412
R.Z.

MARYLAND DEPARTMENT OF TRANSPORTATION
STATE HIGHWAY ADMINISTRATION – OFFICE OF TRAFFIC
BUREAU OF TRAFFIC ENGINEERING

DRAWN BY THOMAS M. ZAYDEL
DES. BY: THOMAS M. ZAYDEL
CHK. BY:

US 40 AND LEWIS LANE

COUNTY: HARFORD

DATE: 9-25-81
SCALE: 1"=20'
F.A.P. NO.
S.H.A. NO. H671-501-471
TS/FILE NO. TS-1836A
SHEET NO. 1 OF 5

12004017.17